


KOLB LAND CONSULTING, INC.

LAND SURVEYING • SUBDIVIDING • LAND PLANNING

LAKE GENEVA, WISCONSIN 53147


WHITEWATER, WISCONSIN 53190

HWY "50"

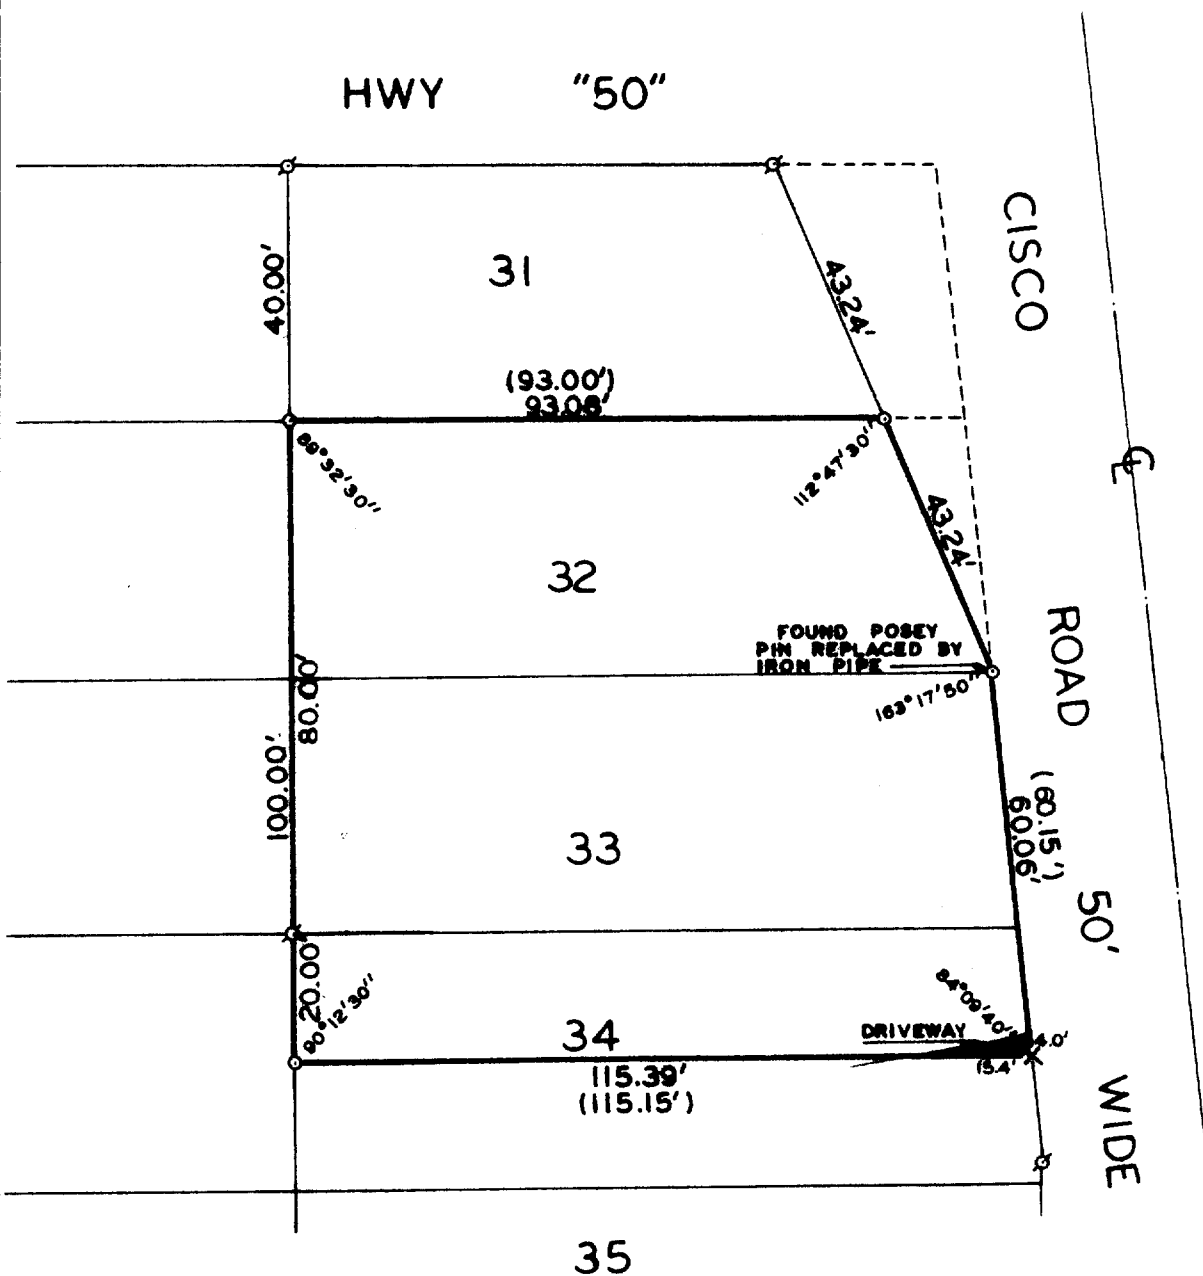

PLAT OF SURVEY OF

PART OF LOT 32, LOT 33, AND THE NORTH 20' OF LOT 34, BLOCK "J", CISCO BEACH SUBDIVISION, T1N, R17E, WALWORTH COUNTY, WISCONSIN.

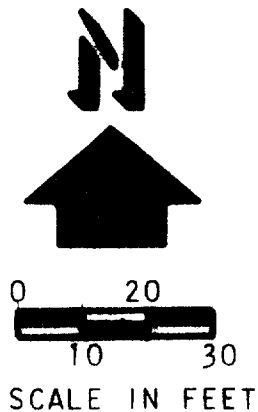

LEGEND:
 ♂ - IRON PIPE FOUND
 ● - IRON PIPE PLACED
 () - AS PLATTED



I, HAROLD H. KOLB, DO HEREBY CERTIFY THAT I HAVE SURVEYED THE PROPERTY HEREON DESCRIBED ACCORDING TO THE OFFICIAL RECORDS, AND THAT THE PLAT HEREON IS A CORRECT REPRESENTATION OF THE LOT LINES.

Harold H. Kolb
 HAROLD H. KOLB
 WISCONSIN REGISTERED LAND SURVEYOR, S-187
 DATE June 18, 1979