


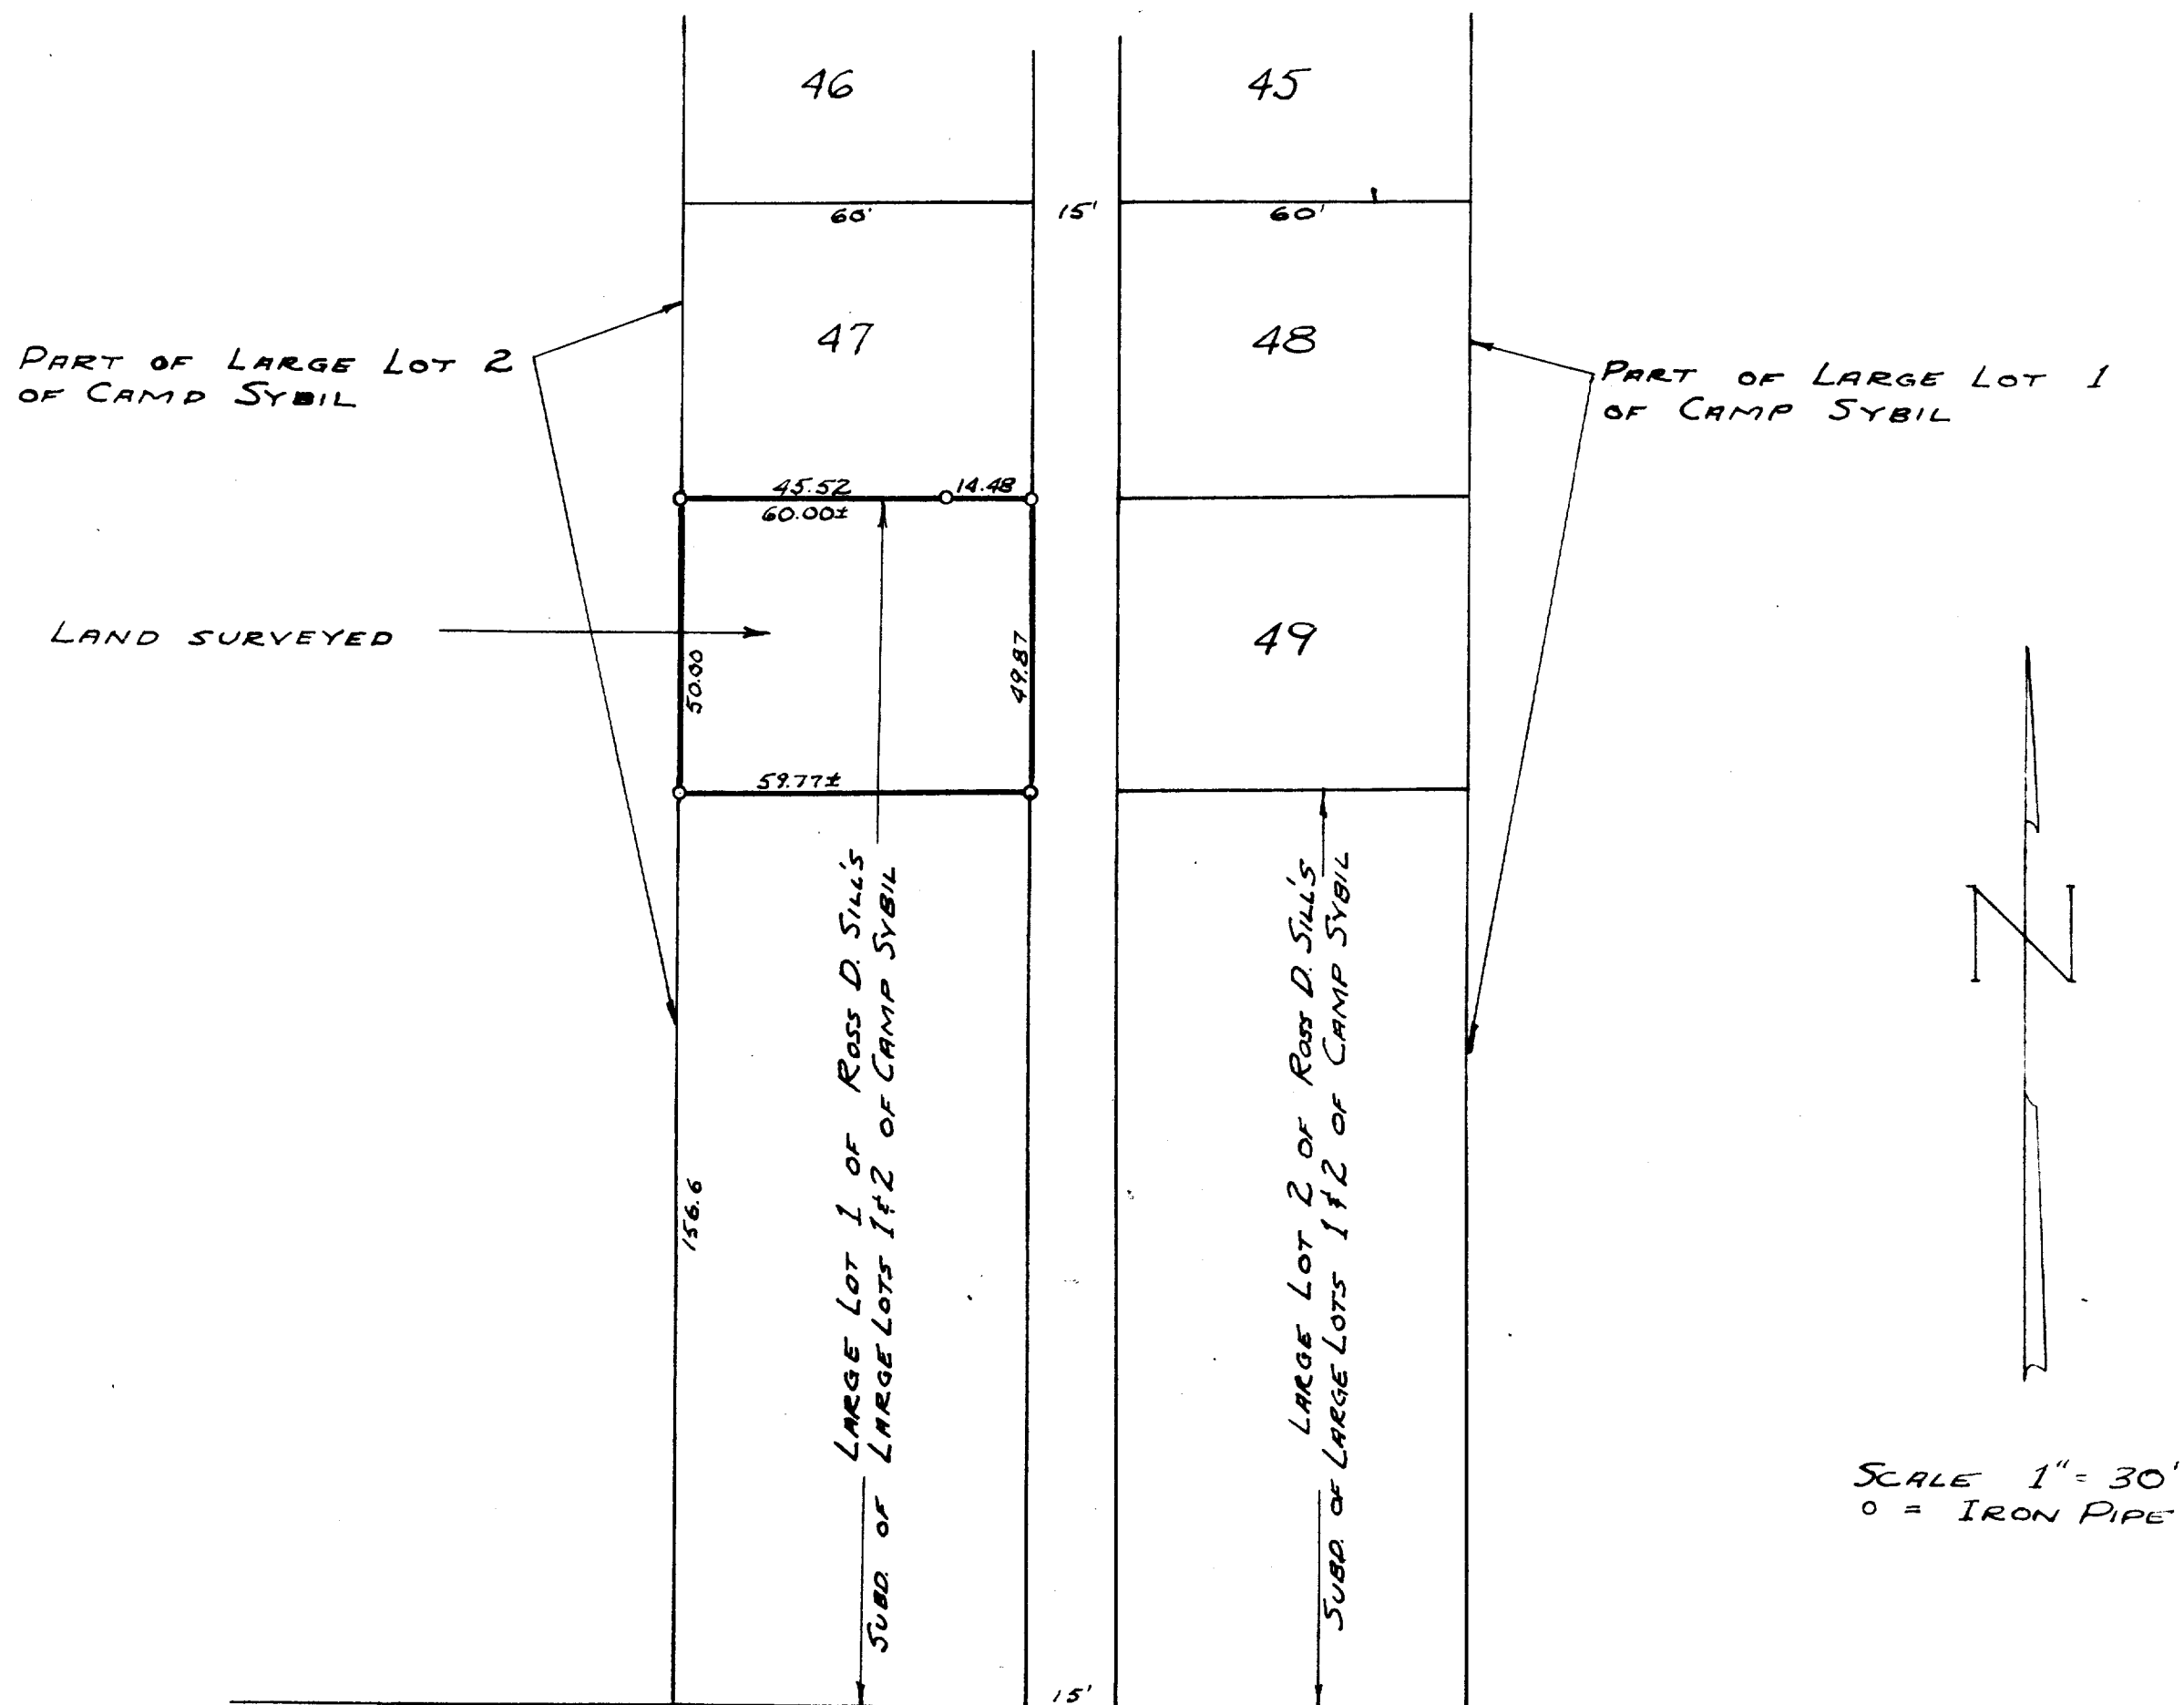

PLAT OF A SURVEY OF PART OF LARGE LOT 1 OF ROSS D. SILL'S SUBDIVISION OF LARGE LOTS 1 & 2 OF CAMP SYBIL, LOCATED IN THE NORTHEAST FRACTIONAL 1/4 OF SECTION 18, T18N R17E OF WALWORTH COUNTY, WISCONSIN

JULY 29, 1948

Lloyd D. Jensen
COUNTY SURVEYOR