


HAROLD H. KOLB

REGISTERED PROFESSIONAL LAND SURVEYOR
LAKE GENEVA, WISCONSIN

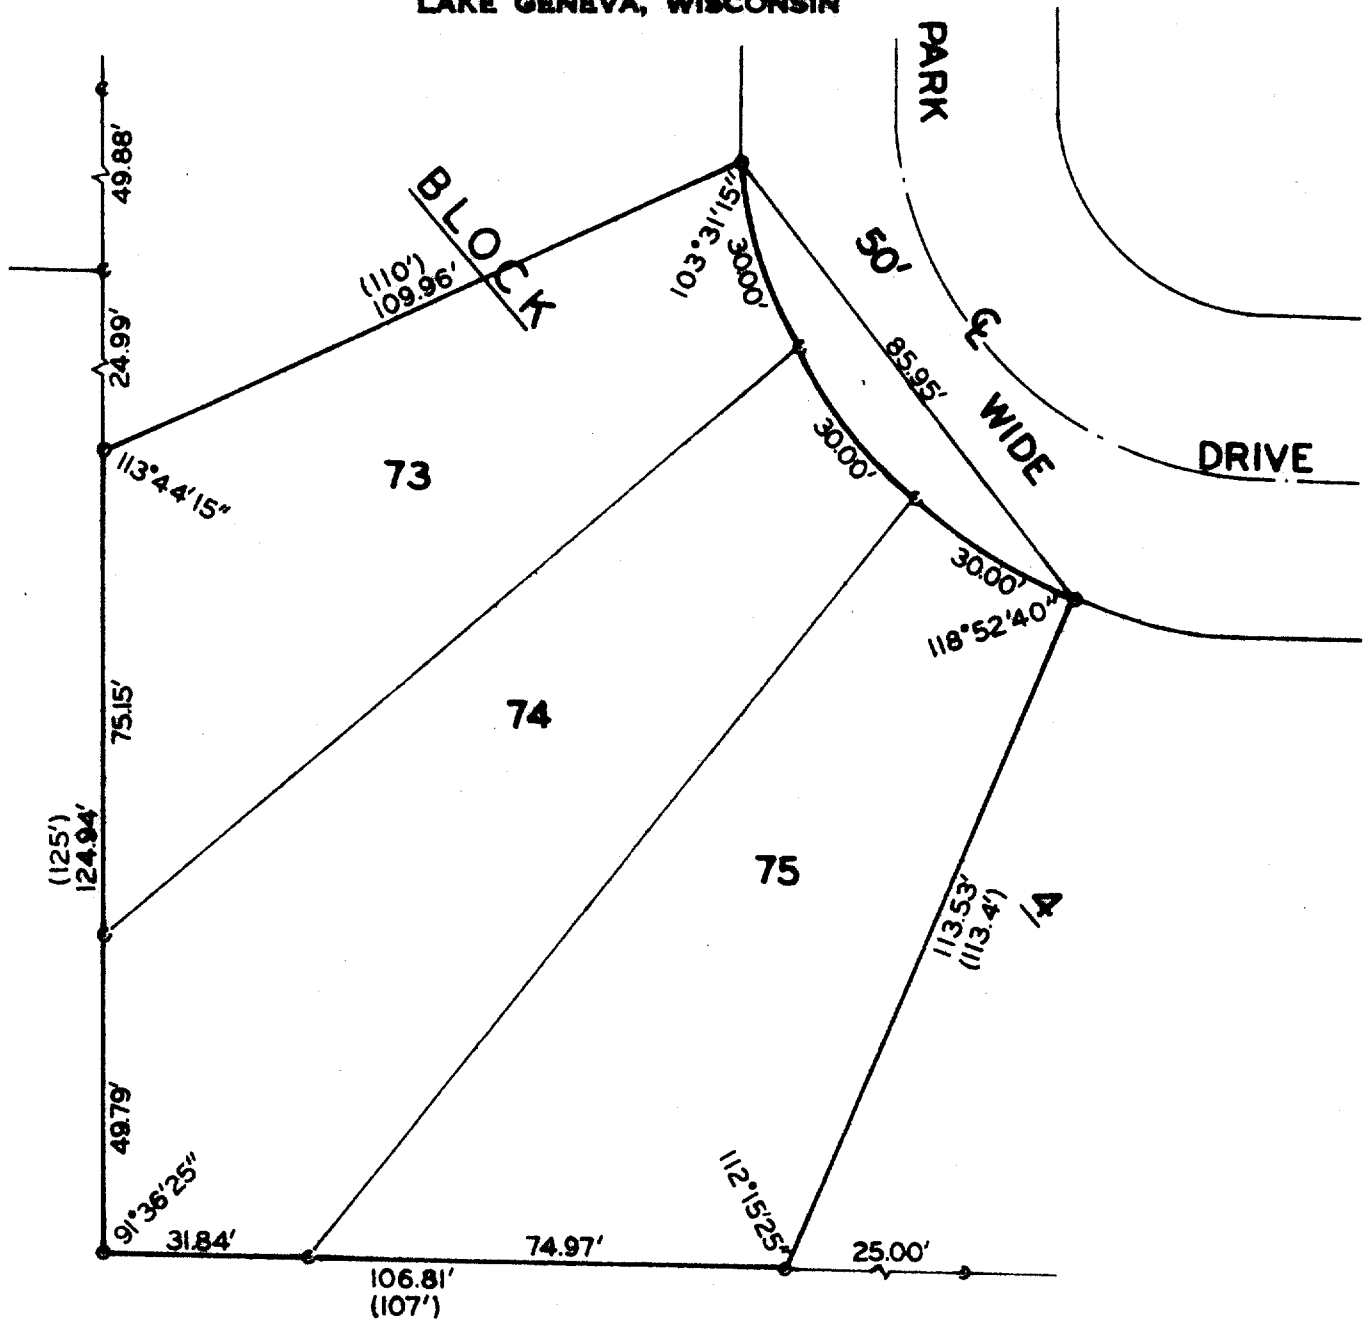


PLAT OF SURVEY OF

LOTS 73, 74 AND 75, BLOCK 4,
LAKE VIEW PARK, T 1 N, R 17 E,
WALWORTH COUNTY, WISCONSIN.

ORDERED BY: JOHN SONTAG
SONTAG REALTY

FOR: JAMES B. FITZPATRICK

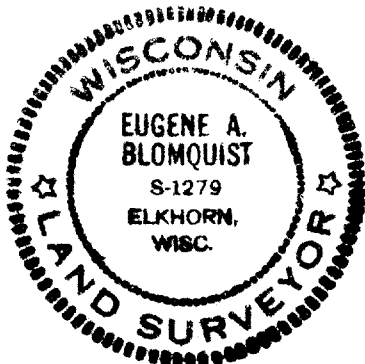

I LVP - 26 G
N



SCALE: 1" = 30'

LEGEND

- O - IRON PIPE PLACED.
- C - IRON PIN FOUND
- () - PLATTED AS

I, EUGENE A. BLOMQUIST, DO HEREBY CERTIFY THAT I
HAVE SURVEYED THE PROPERTY HEREON DESCRIBED ACCORD-
ING TO THE OFFICIAL RECORDS, AND THAT THE PLAT HERE-
ON IS A CORRECT REPRESENTATION OF THE LOT LINES.

Eugene A. Blomquist
EUGENE A. BLOMQUIST
WISCONSIN REGISTERED LAND SURVEYOR, S-1279
DATE June 23, 1977

117-594