


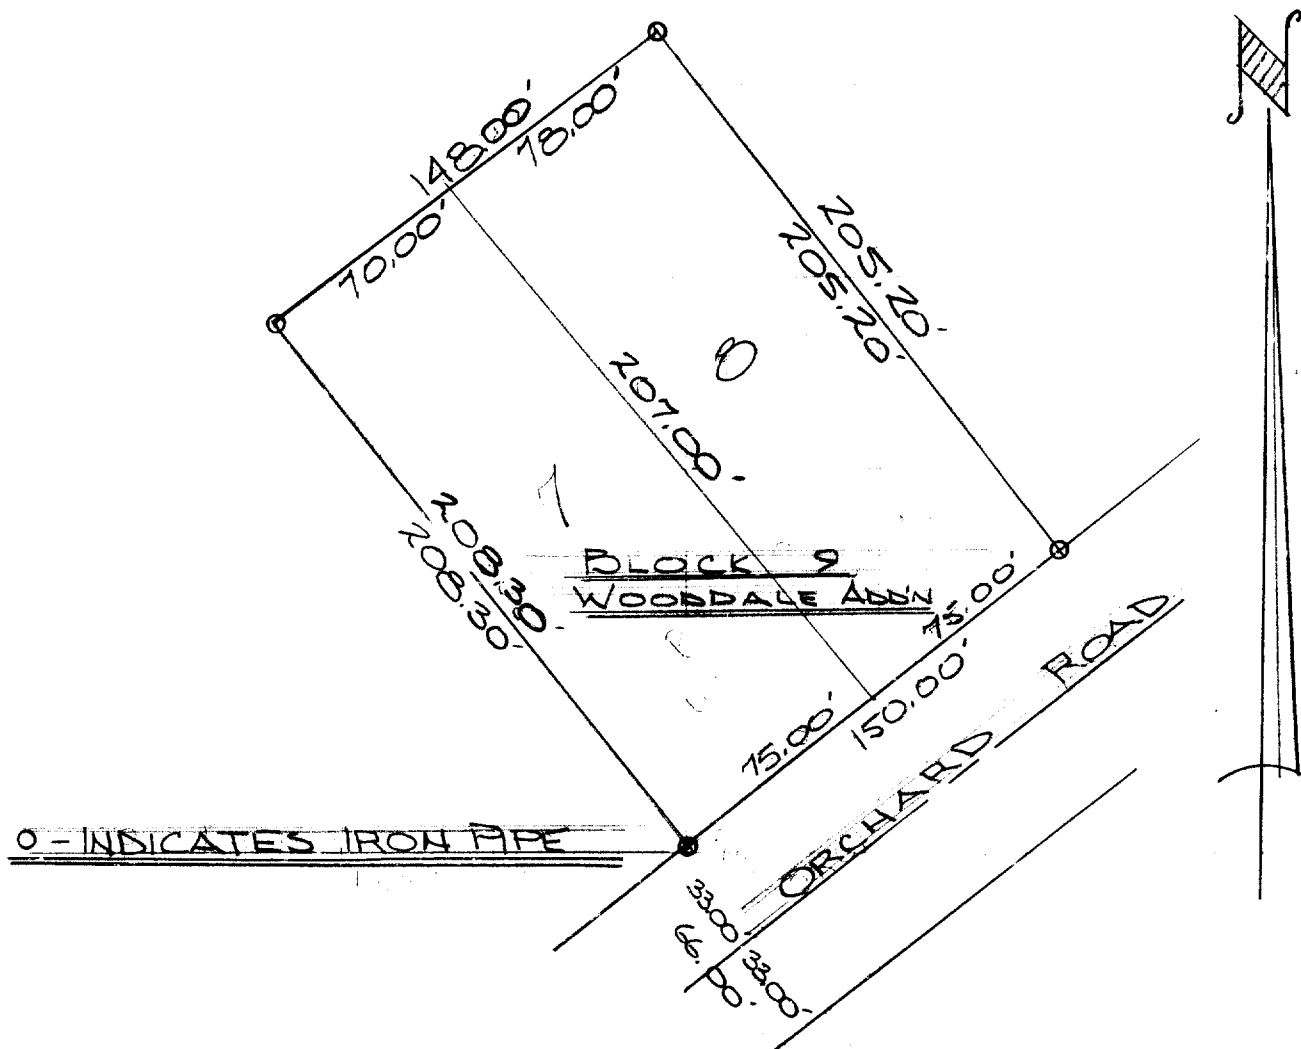

DESCRIPTION: Lots 7 and 8 of Block 9 of Wooddale Addition
located in Section 9 of T. 1 N., R. 17 E.,
Walworth County, Wisconsin.

CERTIFICATE: I, James F. Biagi, surveyor, do hereby certify
that I have surveyed the property hereon described.

October 22, 1968.

James F. Biagi
James F. Biagi, R.L.S. 272

