


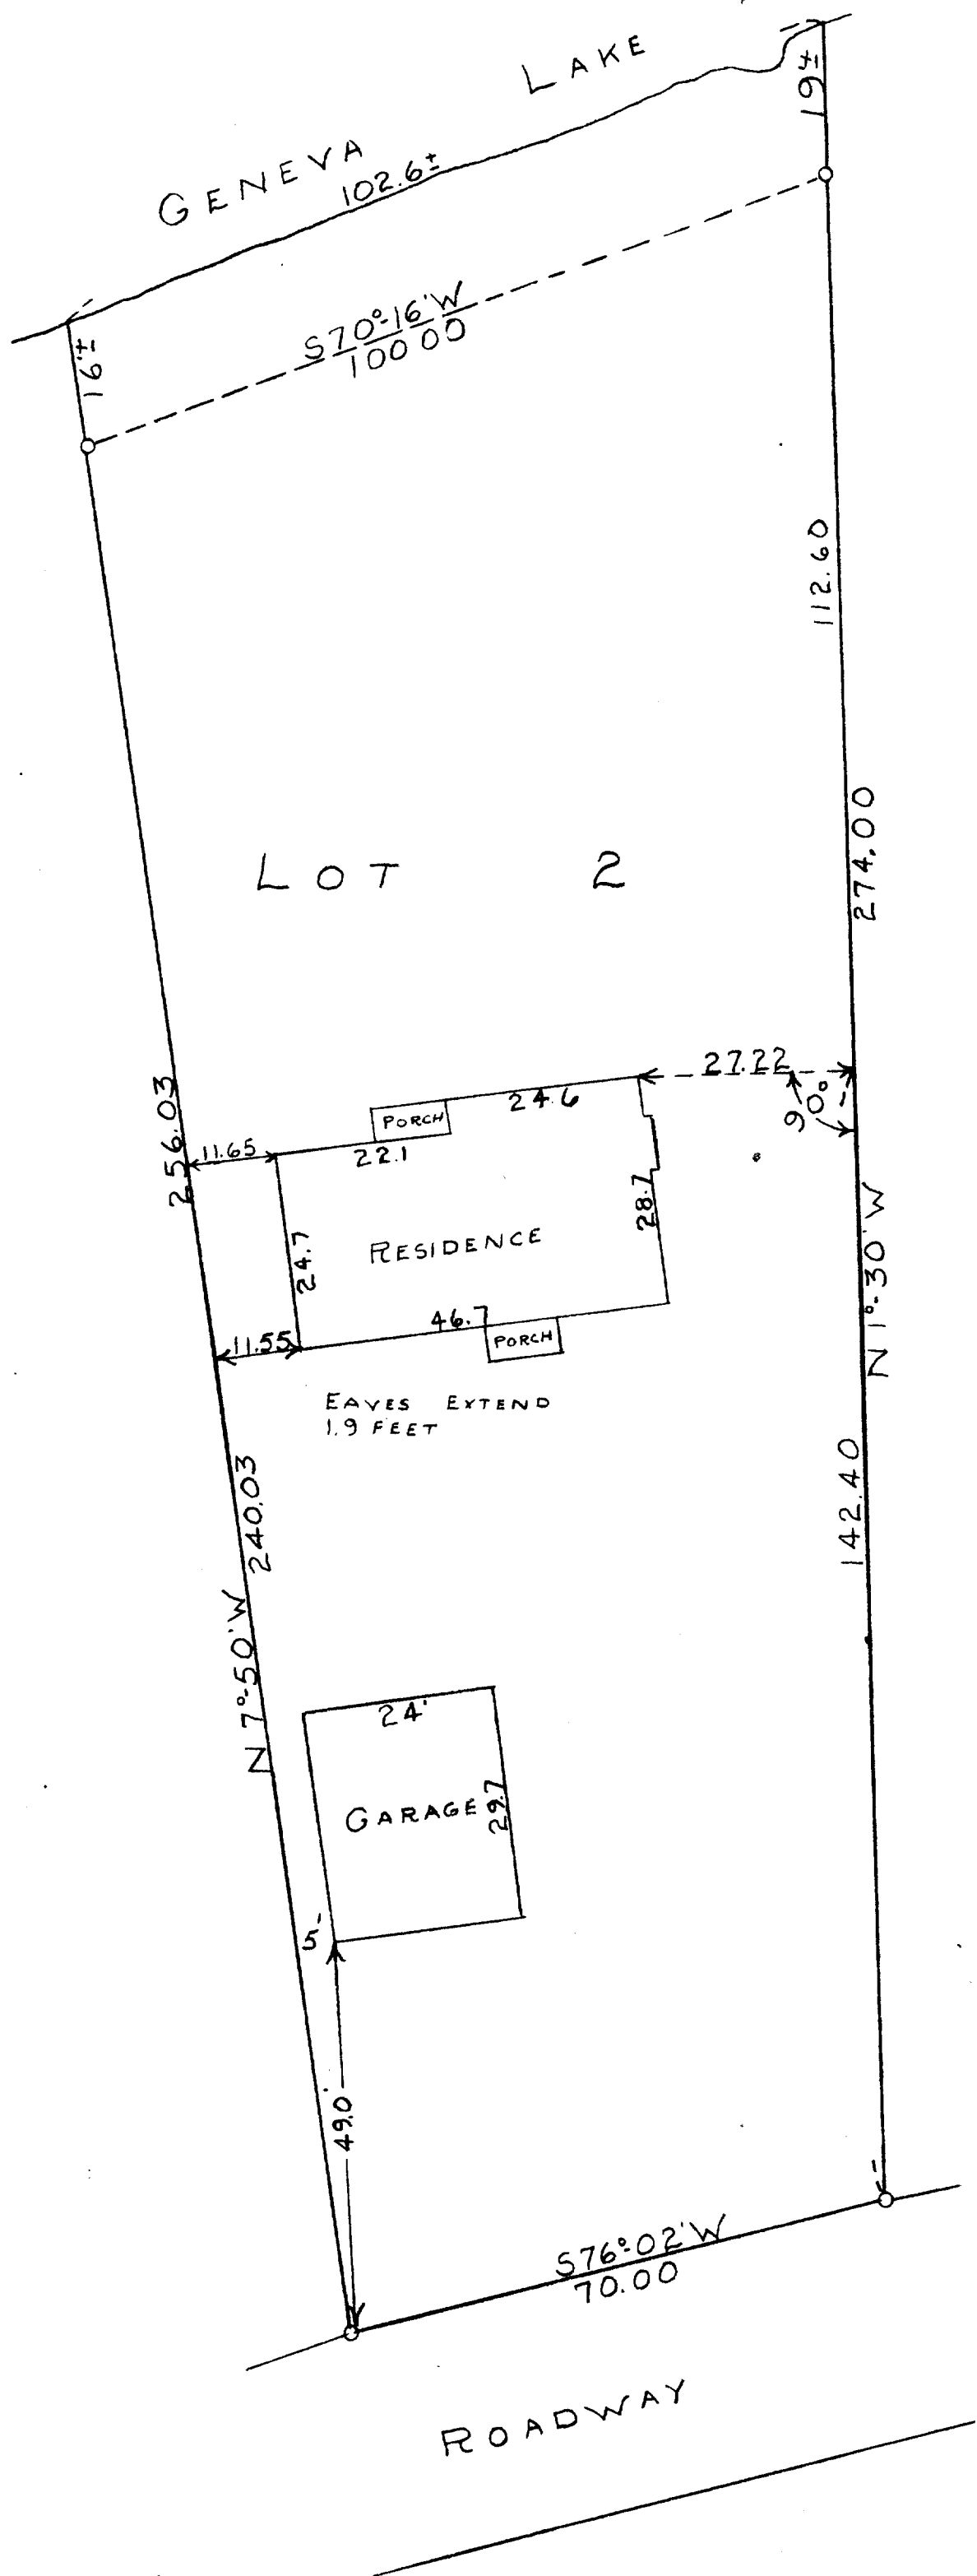

N

SCALE ~ 1" = 20'
O = IRON PIPE

STATE OF WISCONSIN)^{SS}
COUNTY OF WALWORTH)

I, GEORGE T. DUNHAM, DO HEREBY CERTIFY THAT I HAVE
SURVEYED THE PROPERTY DESCRIBED AS FOLLOWS:

LOT 2 OF THE BIRCHES 1ST ADDITION LOCATED IN
SECTION 9, T1N R17E OF WALWORTH COUNTY, WISCONSIN.
AND THAT THE ADJOINING PLAT IS A CORRECT REPRESENTATION
OF THE PROPERTY LINES.

MAY 28, 1954

REVISED MARCH 9, 1956

George T. Dunham
GEORGE T. DUNHAM, SURVEYOR
DELAVAN, WISCONSIN