


PLAT OF SURVEY

OF LOT 9 OF BLOCK A OF CISCO BEACH SUBDIVISION,
TOWN OF LINN, WALWORTH COUNTY, WISCONSIN.

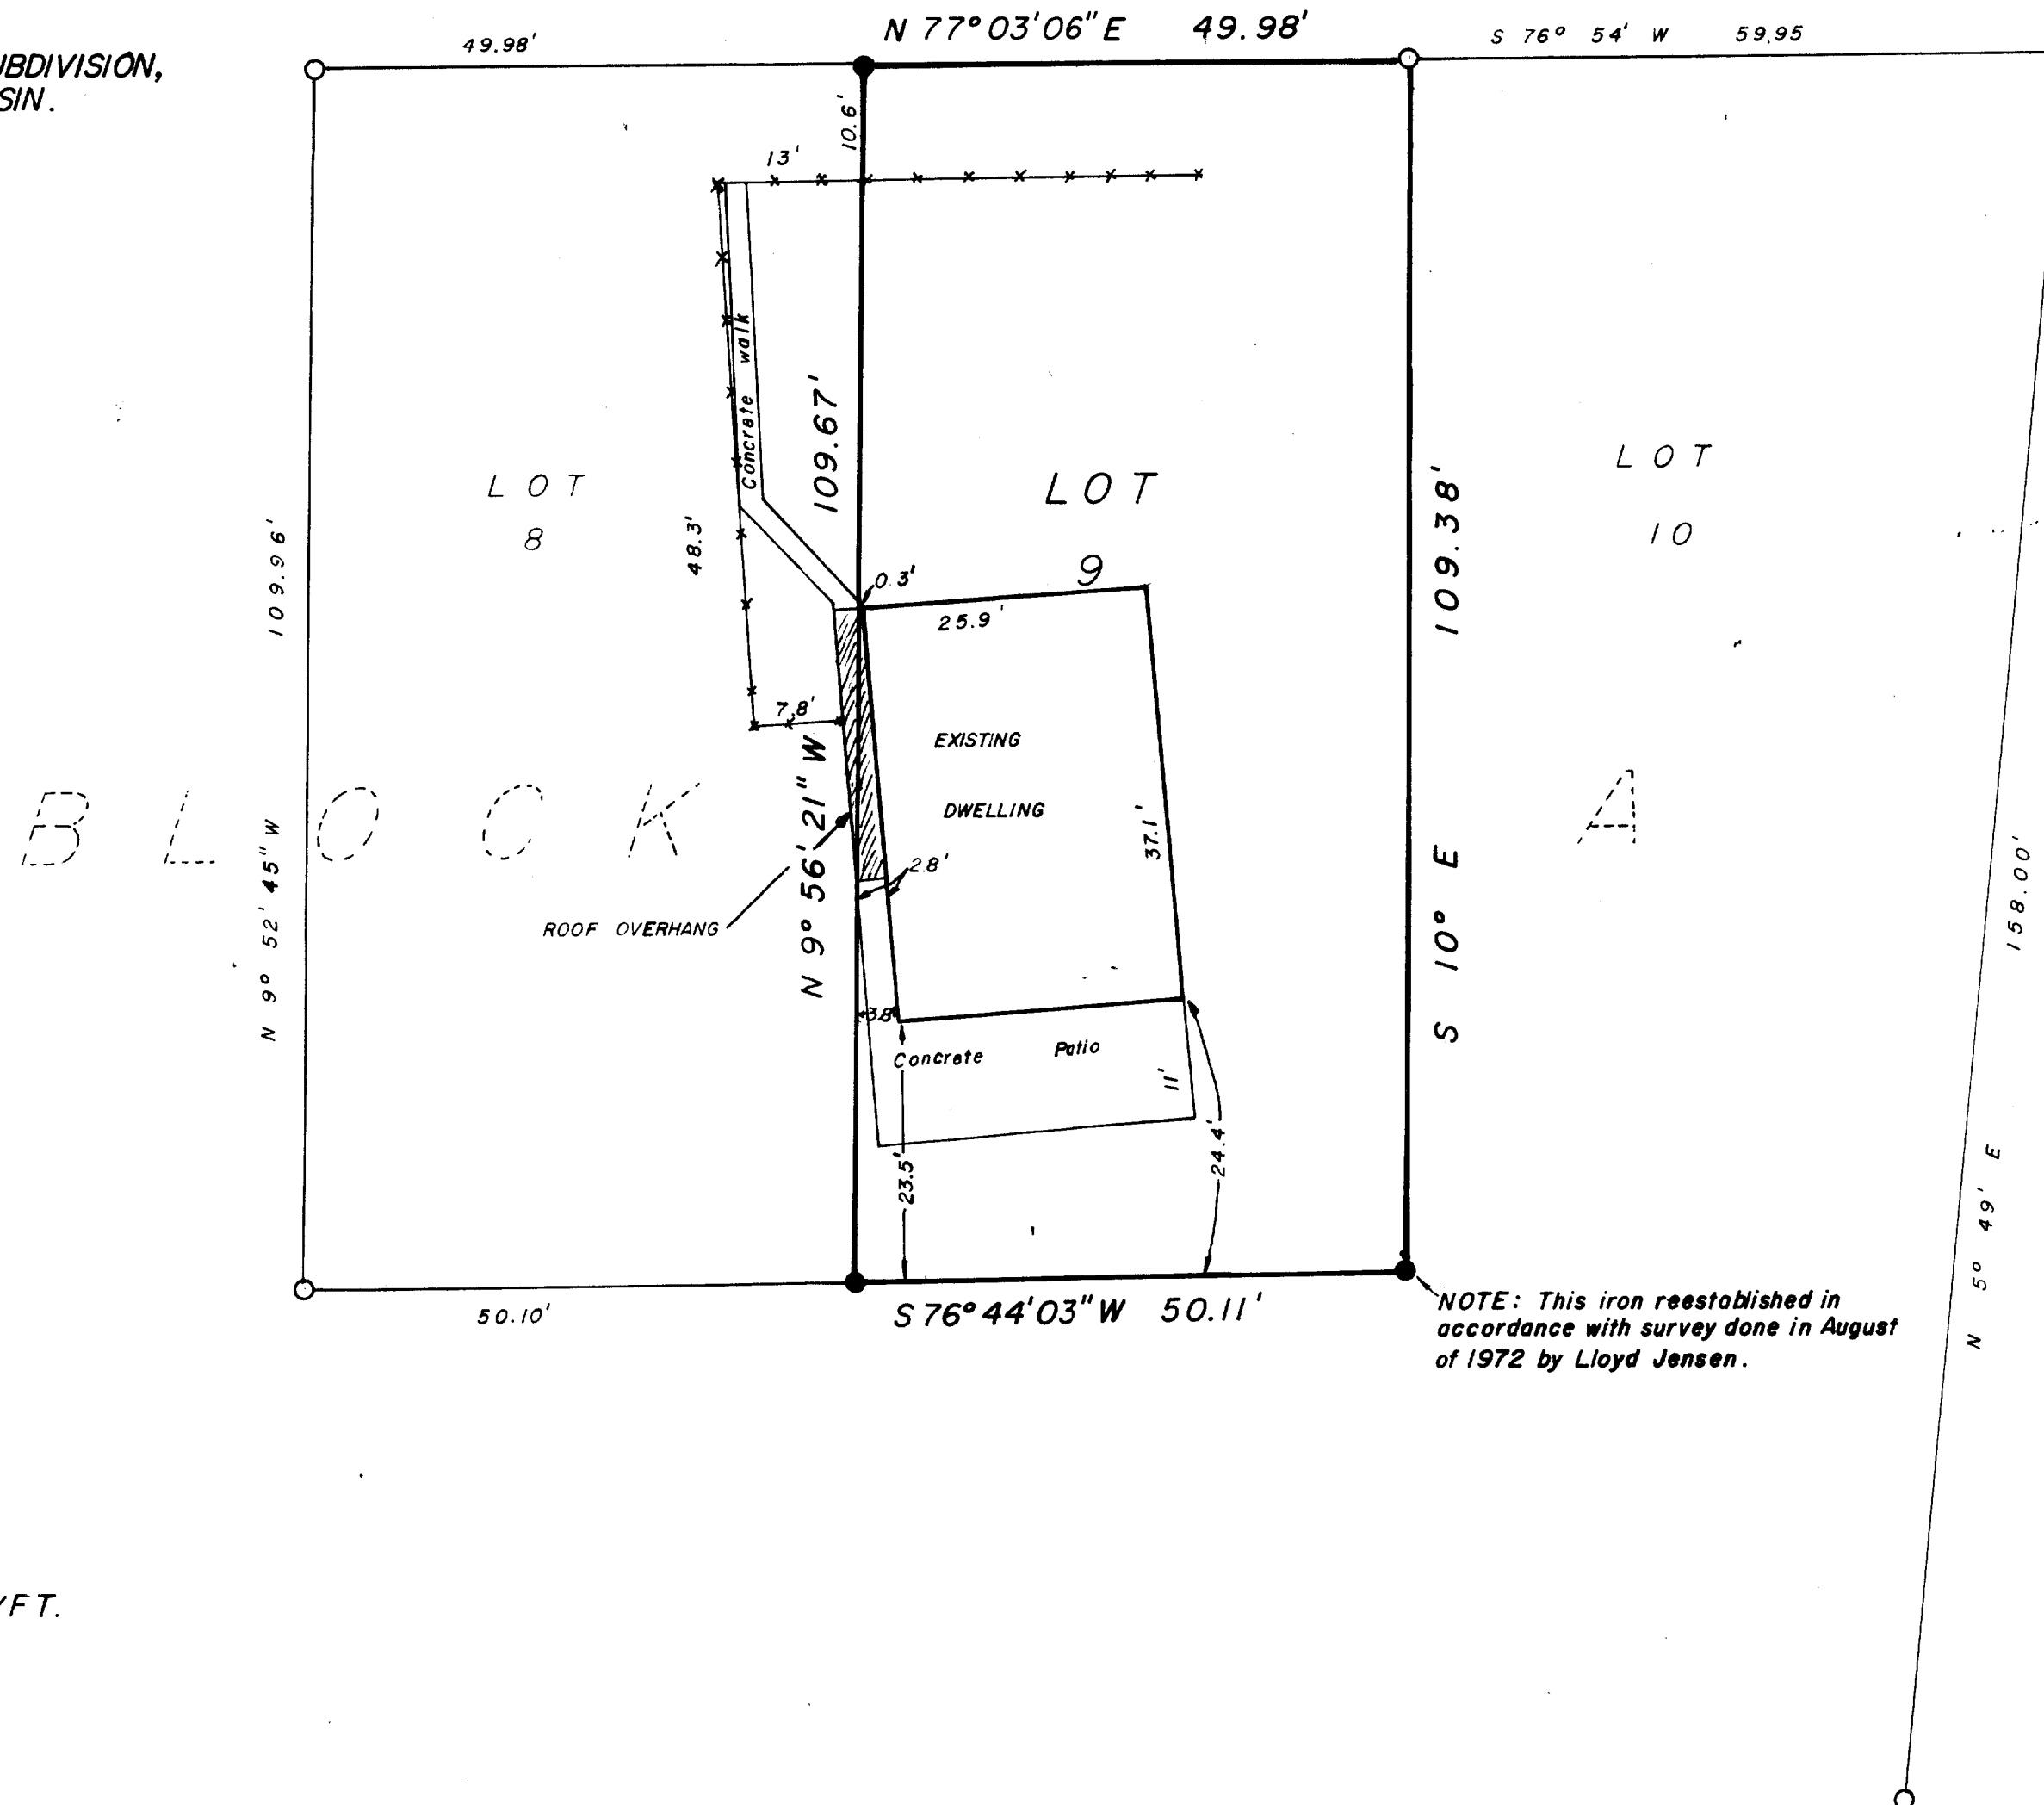


Bearings Referenced to East line of
Property, Previously Platted as S 10° E.

LEGEND

○ - IRON PIPE FOUND

● - IRON BAR SET 3/4" X 30" 1.50 LB/FT.

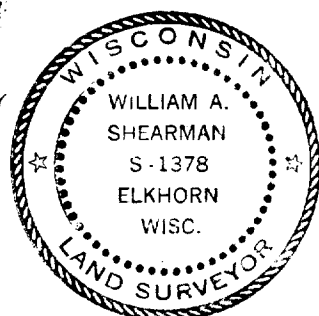

Surveyors Certificate

I, William A. Shearman, Registered Land Surveyor, do hereby certify that the plat shown hereon is a true and accurate survey and a true representation thereof and the exterior boundary lines and all divisions of said property have been surveyed under my direction and to the best of my knowledge and belief.

Dated this 20th day of December, 1978.

William A. Shearman S-1378
Registered Land Surveyor

JENSEN & JOHNSON
ENGINEERS AND SURVEYORS
PO BOX 290, ELKHORN, WISCONSIN
414-723-3204
A Division of
Donohue & Associates, Inc.

Date DEC. 20, 1977	Scale 1" = 15'
Drawn By GM	Surveyed For Scott French
Checked By DAN COOPER	Project No. 1658.248

117-606