


HAROLD H. KOLB

REGISTERED PROFESSIONAL LAND SURVEYOR
LAKE GENEVA, WISCONSIN

GENEVA LAKE

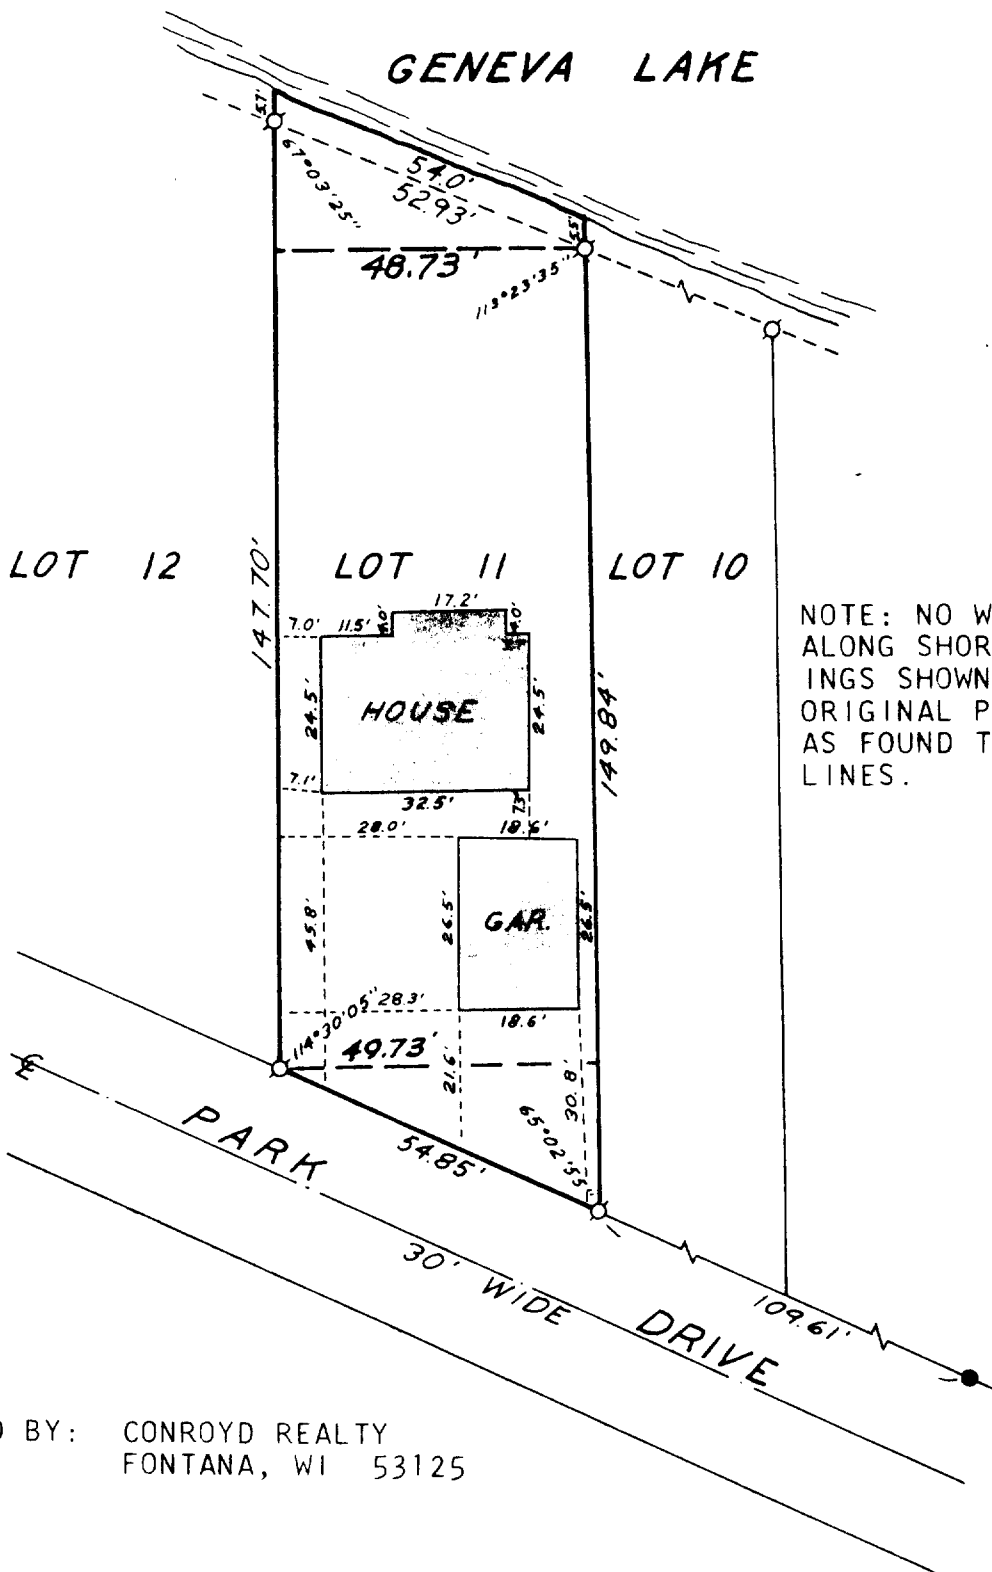

ORDERED BY: CONROYD REALTY
FONTANA, WI 53125



PLAT OF SURVEY OF

LOT 11, LAKE GENEVA BEACH SUBDIVISION, TIN, R17E, WALWORTH COUNTY, WISCONSIN.

OWNED BY: DIETER & HELEN HOLZ
20 W 450 DIVERSEY
ADDISON, IL. 60101

I, HAROLD H. KOLB, DO HEREBY CERTIFY THAT I HAVE SURVEYED THE PROPERTY HEREON DESCRIBED ACCORDING TO THE OFFICIAL RECORDS, AND THAT THE PLAT HEREON IS A CORRECT REPRESENTATION OF THE LOT LINES, AND THE PRINCIPAL LINES OF THE BUILDINGS THEREON.

Harold H. Kolb

HAROLD H. KOLB
WISCONSIN REGISTERED LAND SURVEYOR, S-187

DATE June 22, 1978

REVISED: JULY 27, 1978

N



Scale 1" = 30'

LEGEND

- — IRON PIPE PLACED, 1" x 24" 1.13 LB./LIN. FT.
- — CONCRETE MONUMENT, 5" DIA. x 30"
- ⊙ — IRON PIPE FOUND

IL68-7A