


PLAT OF SURVEY

LOTS 5, 6, 7, 8, 9, 10, 23, 24, 26 and 27, in Block 3
MAPLE HILLS Subdivision, Town of Linn, Walworth County,

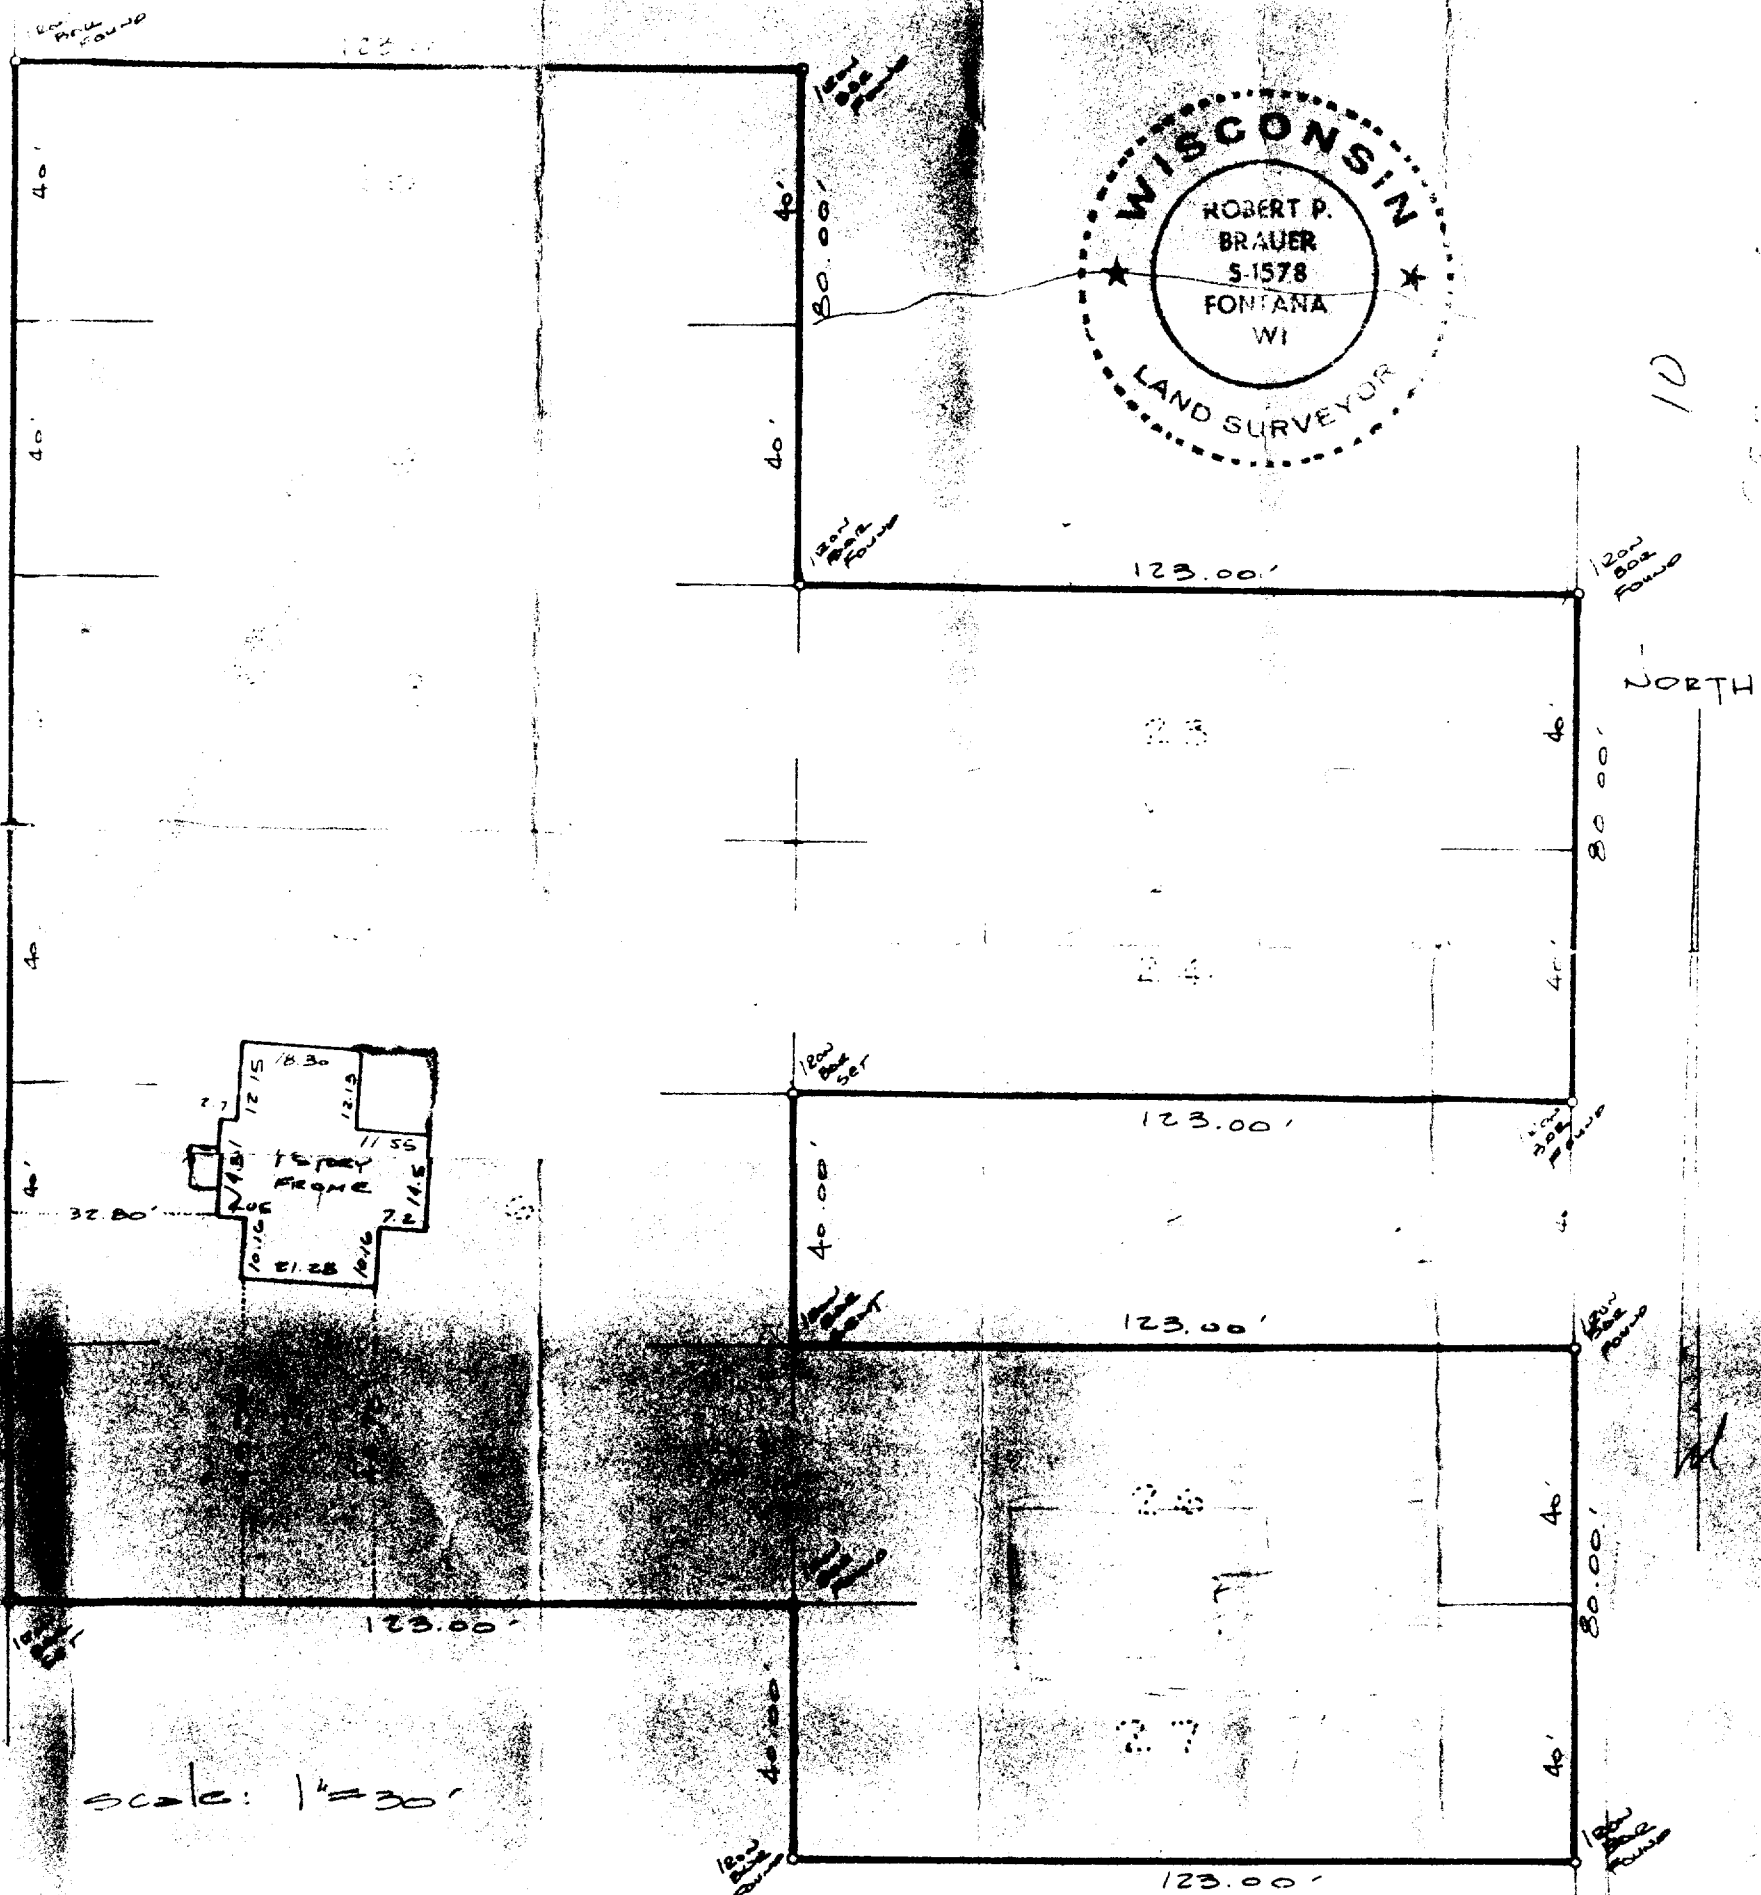

I HEREBY CERTIFY THAT I HAVE SURVEYED THE ABOVE DESCRIBED PROPERTY AND THE ABOVE MAP IS A TRUE REPRESENTATION THEREOF AND SHOWS THE SIZE AND LOCATION OF THE PROPERTY, ITS EXTERIOR BOUNDARIES, THE LOCATION OF ALL VISIBLE STRUCTURES AND DIMENSIONS OF ALL PRINCIPLE BUILDINGS THEREON, BOUNDARY FENCES, APPARENT EASEMENTS, ROADWAYS AND VISIBLE ENCROACHMENTS, IF ANY.

THIS SURVEY IS MADE FOR THE PRESENT OWNERS OF THE PROPERTY, AND ALSO THOSE WHO PURCHASE MORTGAGE, OR GUARANTEE THE TITLE THERETO WITHIN ONE YEAR FROM DATE THEREOF.

DATED AT Fontana, WI THIS 10th DAY OF NOVEMBER 19 33

MH-42, 43, 45, 54
MH-52B, 56, 57, 58

Robert P. Brauer

ROBERT P. BRAUER Registered Land Surveyor 1578

117-612-B⁴
No. 83531