


HAROLD H. KOLB

REGISTERED PROFESSIONAL LAND SURVEYOR
LAKE GENEVA, WISCONSIN

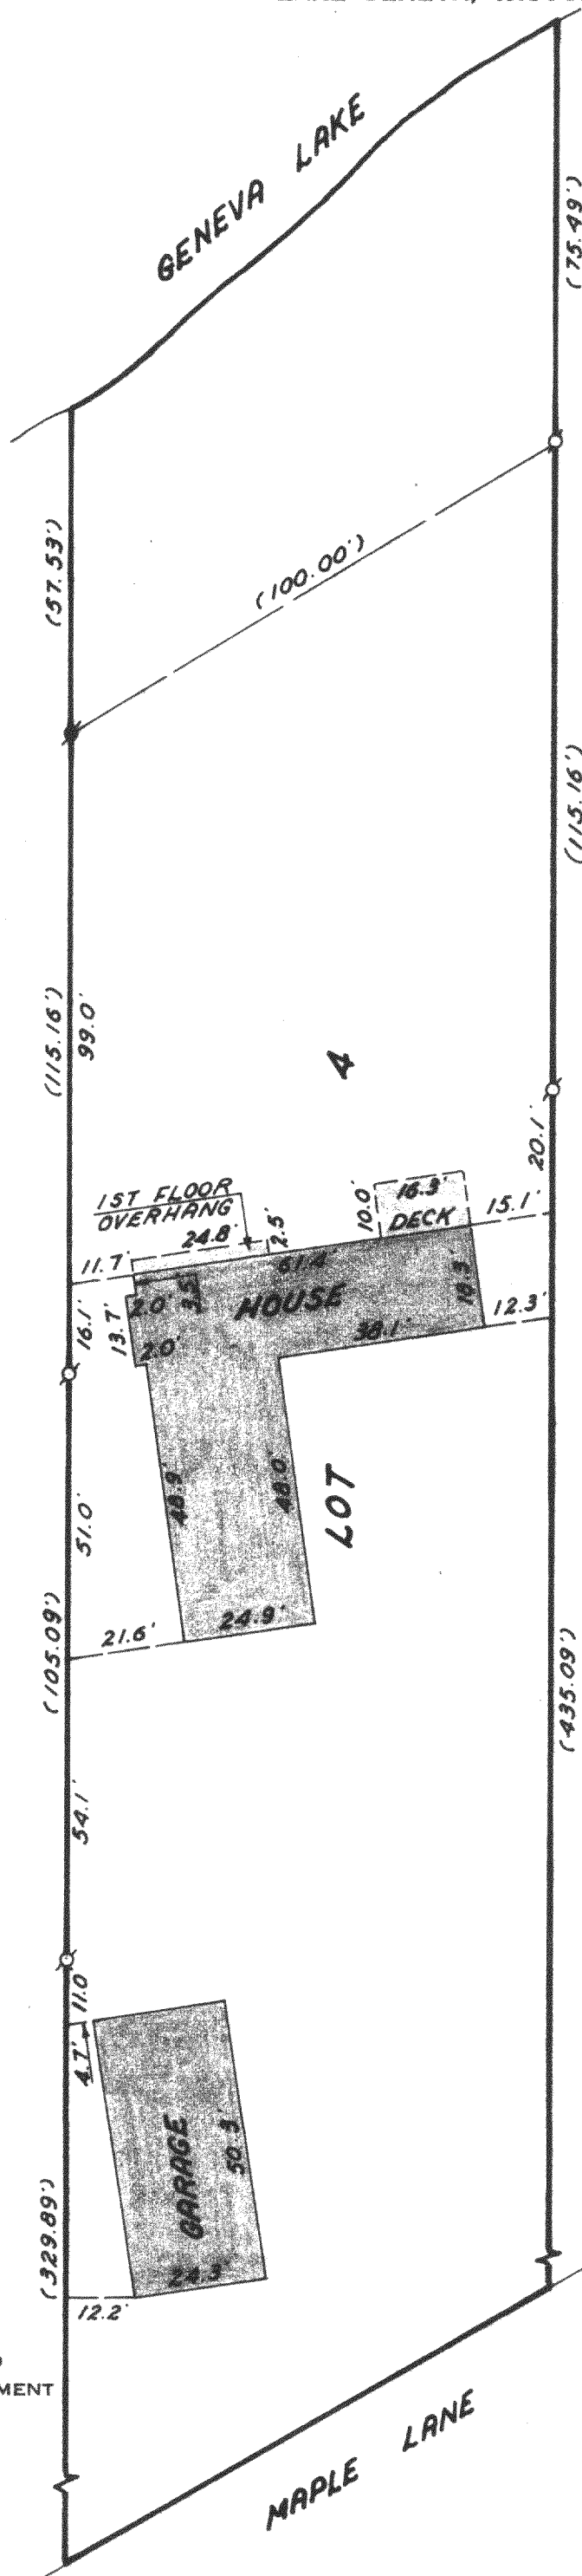

PLAT OF

BUILDING LOCATIONS ON
LOT 4, THE BIRCHES, T 1 N,
R 17 E, WALWORTH COUNTY,
WISCONSIN.

ORDERED BY: LAKE GENEVA
REALTY

NOTE: IRON PIPE AND CONCRETE MONUMENT WERE
FOUND AS SHOWN ON A SURVEY BY
GEORGE T. DUNHAM, DATED OCTOBER 5, 1962

N



SCALE: 1"=30'



LEGEND

- φ - IRON PIPE FOUND
- O - IRON PIPE PLACED
- - CONCRETE MONUMENT
- X - SPIKE
- () - RECORDED AS

±BA-5

Harold H. Kolb

HAROLD H. KOLB
WISCONSIN REGISTERED LAND SURVEYOR, S-187
DATE May 20, 1977