


HAROLD H. KOLB

REGISTERED PROFESSIONAL LAND SURVEYOR
LAKE GENEVA, WISCONSIN

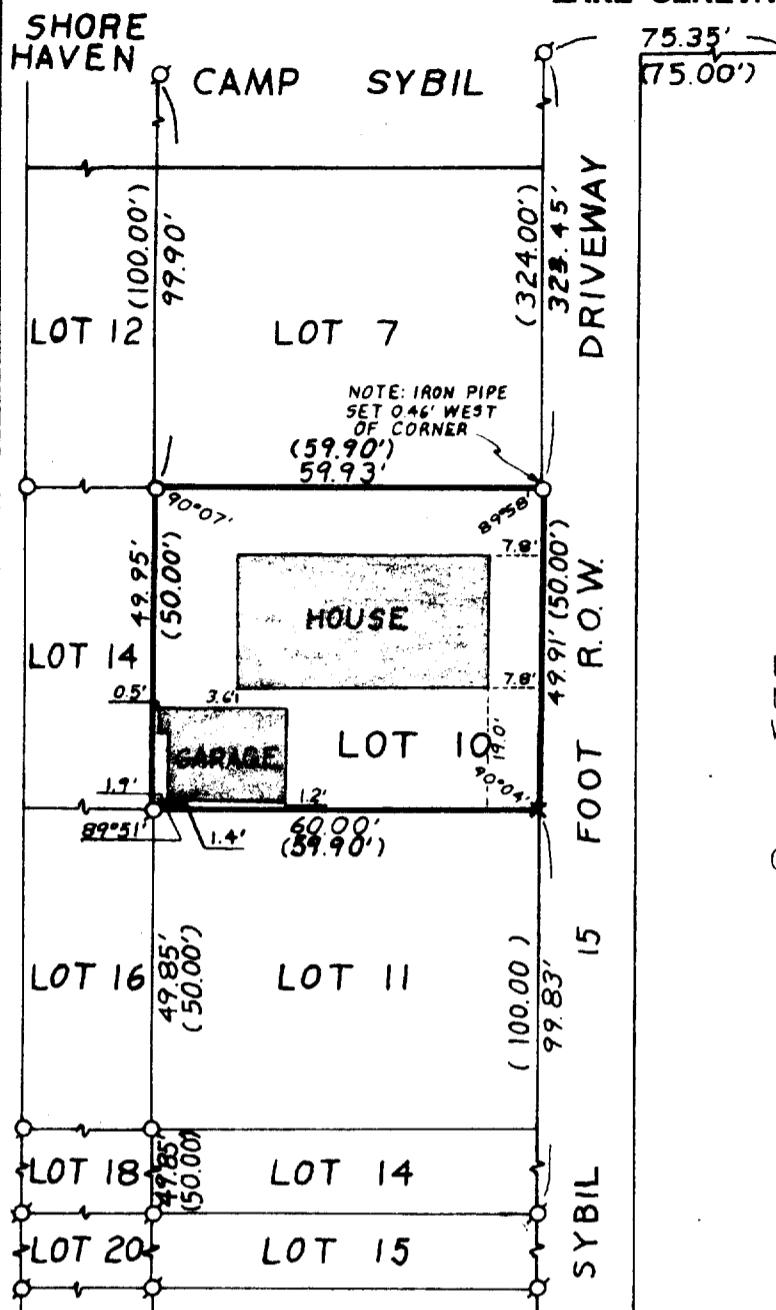


PLAT OF SURVEY OF

LOT 10, CAMP SYBIL, A SUBDIVISION
LOCATED IN SECTION 18, T 1 N, R 17 E,
WALWORTH COUNTY, WISCONSIN.

OWNER: HARRY W. BERNDT
5517 WEST 102ND STREET
OAK LAWN, ILLINOIS 60453

I, EUGENE A. BLOMQUIST, DO HEREBY CERTIFY
THAT I HAVE SURVEYED THE PROPERTY HEREON
DESCRIBED ACCORDING TO THE OFFICIAL RECORDS
AND THAT THE PLAT HEREON IS A CORRECT REP-
RESENTATION OF THE LOT LINES.

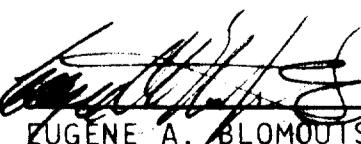


EUGENE A. BLOMQUIST
WISCONSIN REGISTERED LAND SURVEYOR, S-1279
DATE Feb 23, 1978

EECA-9

O — IRON PIPE PLACED. 1" x 24" 1.13 LB./LIN. FT.
● — CONCRETE MONUMENT. 5" DIA. x 30"
◊ — IRON PIPE FOUND X - CHISELED CROSS () — PLATTED AS