


DUNHAM SURVEYING, S.C.
SURVEYING & SUBDIVIDING
DELAVER, WISCONSIN 53115

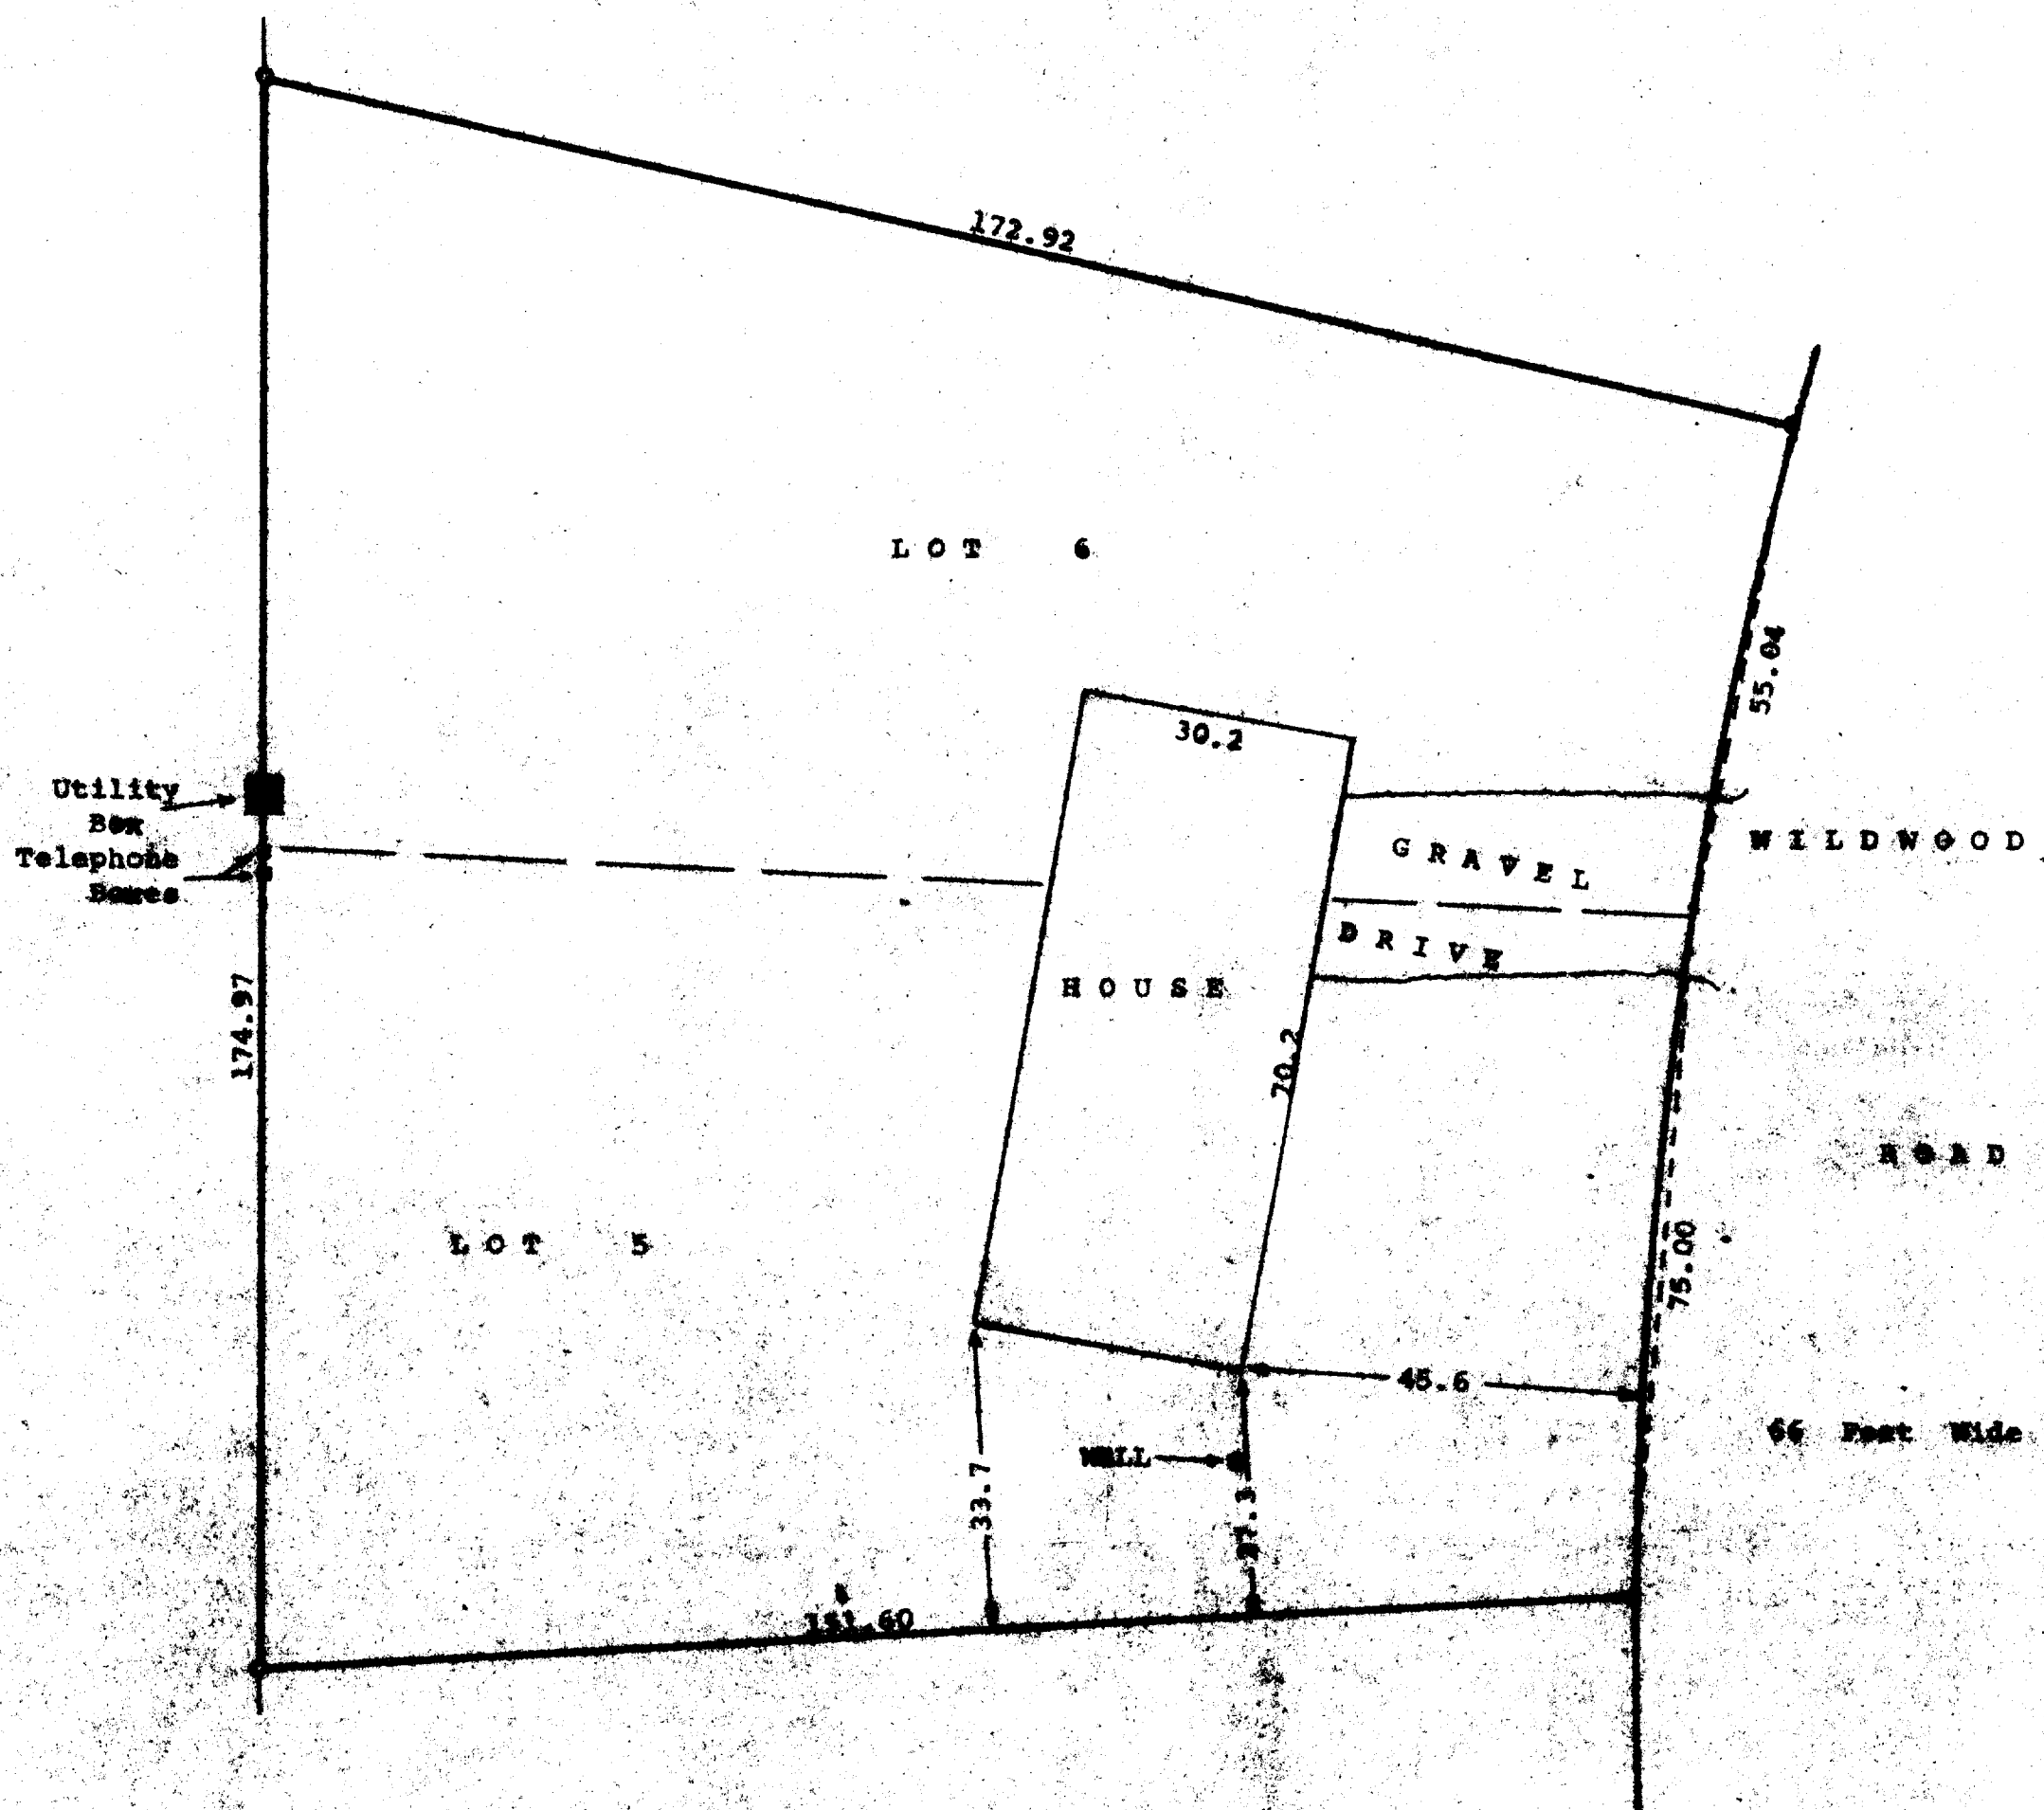

STATE OF WISCONSIN)
COUNTY OF WAUKESHA)

I, James M. Dunham, Surveyor, certify that I have surveyed the property described as follows:

Lots 5 and 6 in Block 15 of Woodman Addition, located in Section 16, T 1 N, R 17 E, Walworth County, Wisconsin, and the above map is a true representation thereof and shows the size and location of the property, its exterior boundaries, the location and dimensions of all structures thereon, fences, apparent easements and roadways and visible encroachments, if any.

This survey is made for the exclusive use of the present owners of the property, and also those who purchase, mortgage, or otherwise acquire title thereto within one (1) year from the date hereof, and as to them I warrant the accuracy of said survey and map.

August 14, 1978

EW-77A

James M. Dunham
James M. Dunham, Surveyor

