


WHITEWATER, WISCONSIN 53190

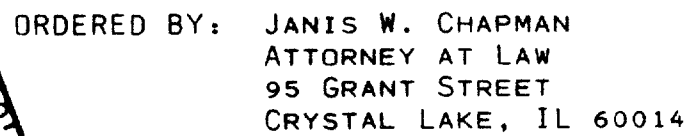

SCALE 1"=20'

LEGEND:

○ - IRON PIPE PLACED  
 ⦿ - IRON PIPE FOUND



HAROLD H. KOLB  
WISCONSIN REGISTERED LAND SURVEYOR, S-187

DATE Oct. 3, 1970

IW-12

117-6225

SHEET 2 OF 2 SHEETS

**KOLB LAND CONSULTING, INC.**  
LAND SURVEYING • SUBDIVIDING • LAND PLANNING


HAROLD H. KOLB, RLS • 415 BROAD ST., LAKE GENEVA, WI 53147 • 414-248-3697  
EUGENE A. BLUMQUIST, RLS • 144 W. MAIN ST., WHITEWATER, WI 53190 • 414-473-4150

PLAT OF SURVEY OF

LOT 9, BLOCK 1 OF WOODDALE ADDITION LOCATED IN SECTION 9,  
TOWN 1 NORTH, RANGE 17 EAST, WALWORTH COUNTY, WISCONSIN,  
EXCEPTING THAT PORTION THEREOF DESCRIBED AS FOLLOWS:  
BEGINNING AT THE SOUTHWEST CORNER OF LOT 9, BLOCK 1 OF  
SAID WOODDALE ADDITION; THENCE NORTHWESTERLY ALONG THE  
SOUTHWESTERLY LINE OF SAID LOT 9, 158.55 FEET MORE OR  
LESS TO THE LOW WATER MARK OF GENEVA LAKE; THENCE NORTH-  
EASTERLY ALONG THE SHORE OF GENEVA LAKE 20 FEET; THENCE  
SOUTHEASTERLY ON A LINE THAT IS PARALLEL WITH THE WESTERLY  
LINE OF SAID LOT 9 AND 20 FEET DISTANT THEREFROM 162.57  
FEET MORE OR LESS TO THE SOUTHERLY LINE OF SAID LOT 9;  
THENCE SOUTHWESTERLY ALONG THE SOUTHERLY LINE OF SAID LOT 9  
20.00 FEET TO THE PLACE OF BEGINNING.

I HEREBY CERTIFY THAT I HAVE SURVEYED THE  
ABOVE DESCRIBED PROPERTY AND THAT THE ABOVE  
MAP IS A TRUE REPRESENTATION THEREOF AND  
SHOWS THE SIZE AND LOCATION OF THE PROPERTY,  
ITS EXTERIOR BOUNDARIES, THE LOCATION OF ALL  
VISIBLE STRUCTURES AND DIMENSIONS OF ALL  
PRINCIPAL BUILDINGS THEREON, BOUNDARY FENCES,  
APPARENT EASEMENTS, ROADWAYS AND VISIBLE  
ENCROACHMENTS, IF ANY.

THIS SURVEY IS MADE FOR THE USE OF THE PRESENT  
OWNERS OF THE PROPERTY, AND ALSO THOSE WHO  
PURCHASE, MORTGAGE, OR GUARANTEE THE TITLE  
THERETO WITHIN ONE (1) YEAR FROM DATE HEREOF.

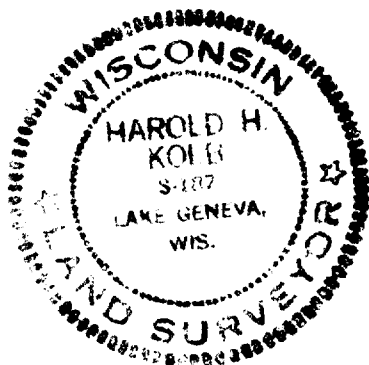

*Harold H. Kolb*  
HAROLD H. KOLB  
WISCONSIN REGISTERED LAND SURVEYOR, S-187  
DATE Oct 3, 1979

117-622K