

KOLB LAND CONSULTING, INC.
LAND SURVEYING • SUBDIVIDING • LAND PLANNING


LAKE GENEVA, WISCONSIN 53147

WHITEWATER, WISCONSIN 53190

PLAT OF SURVEY OF
LOT 14, THE BIRCHES 1ST ADDITION,
A SUBDIVISION LOCATED IN TOWN 1 NORTH,
RANGE 17 EAST, WALWORTH COUNTY,
WISCONSIN.


ORDERED BY: KENNETH MANNINO
2610 HIGHCREST ROAD
ROCKFORD, ILL. 61107

Scale 1"=20'

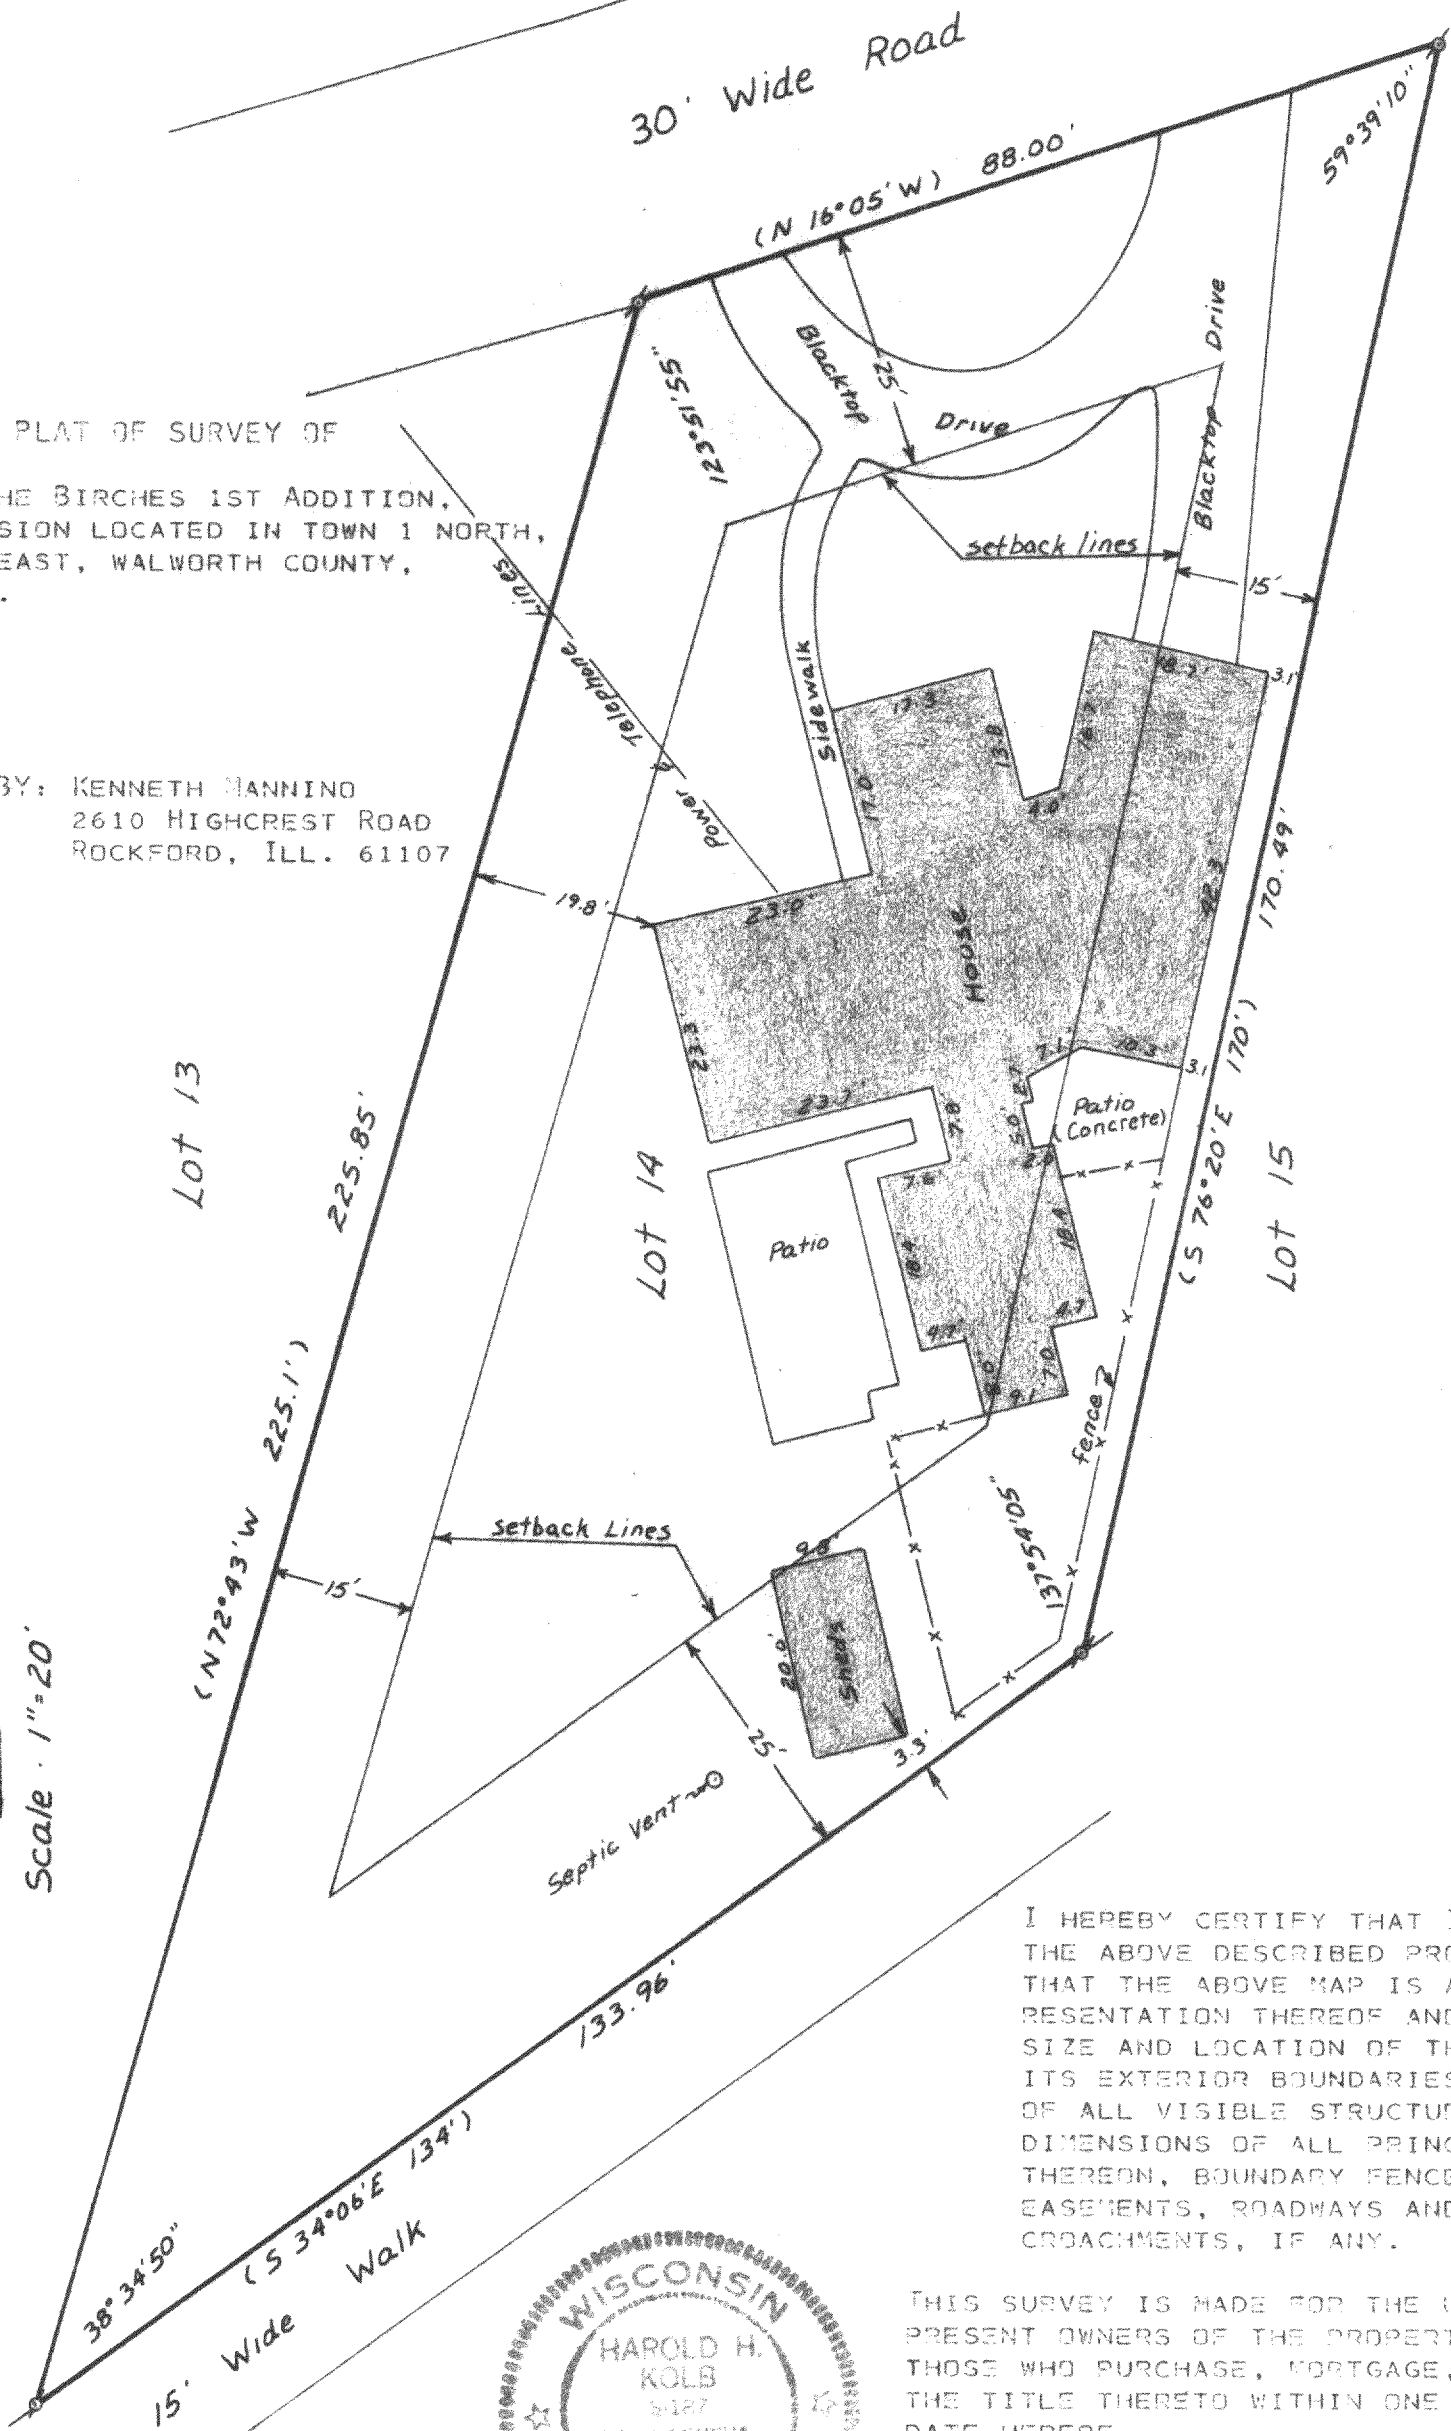

I HEREBY CERTIFY THAT I HAVE SURVEYED
THE ABOVE DESCRIBED PROPERTY AND
THAT THE ABOVE MAP IS A TRUE REP-
RESENTATION THEREOF AND SHOWS THE
SIZE AND LOCATION OF THE PROPERTY,
ITS EXTERIOR BOUNDARIES, THE LOCATION
OF ALL VISIBLE STRUCTURES AND
DIMENSIONS OF ALL PRINCIPAL BUILDINGS
THEREON, BOUNDARY FENCES, APPARENT
EASEMENTS, ROADWAYS AND VISIBLE EN-
CROACHMENTS, IF ANY.

THIS SURVEY IS MADE FOR THE USE OF THE
PRESENT OWNERS OF THE PROPERTY, AND ALSO
THOSE WHO PURCHASE, MORTGAGE, OR GUARANTEE
THE TITLE THERETO WITHIN ONE (1) YEAR FROM
DATE HEREOF.

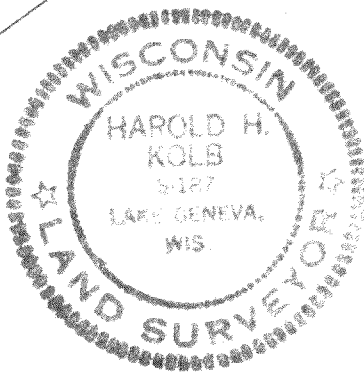

LEGEND:
Ø - IRON PIPE FOUND
() - AS PLATTED

Harold H. Kolb
HAROLD H. KOLB
WISCONSIN REGISTERED LAND SURVEYOR, S-187
DATE Dec. 27, 1979

IBA1-74

117-626K