



ASSUMED NORTH

SCALE 1" = 30 FEET

LEGEND

- CH" IRON PIPE FOUND
- 1" IRON PIPE SET
- 3/4" IRON ROD FOUND
- 1/2" IRON PIPE FOUND

FIELD WORK - KBA
ELM

26V-7


PLAT OF SURVEY

LOT 6, BLK 2, GENEVISTA, A SUBDIVISION LOCATED IN THE
SW 1/4, OF THE SW 1/4 OF SECTION 10, T1N, R17E, WALWORTH COUNTY, WIS.

SURVEYED FOR: PROPERTIES
UNLIMITED --- JOHN J. DONAHUE

Rt 1 Linn Rd
LAKE GENEVA
WIS 53147


49.50 WIDE ROAD
RD
PIER
LINN

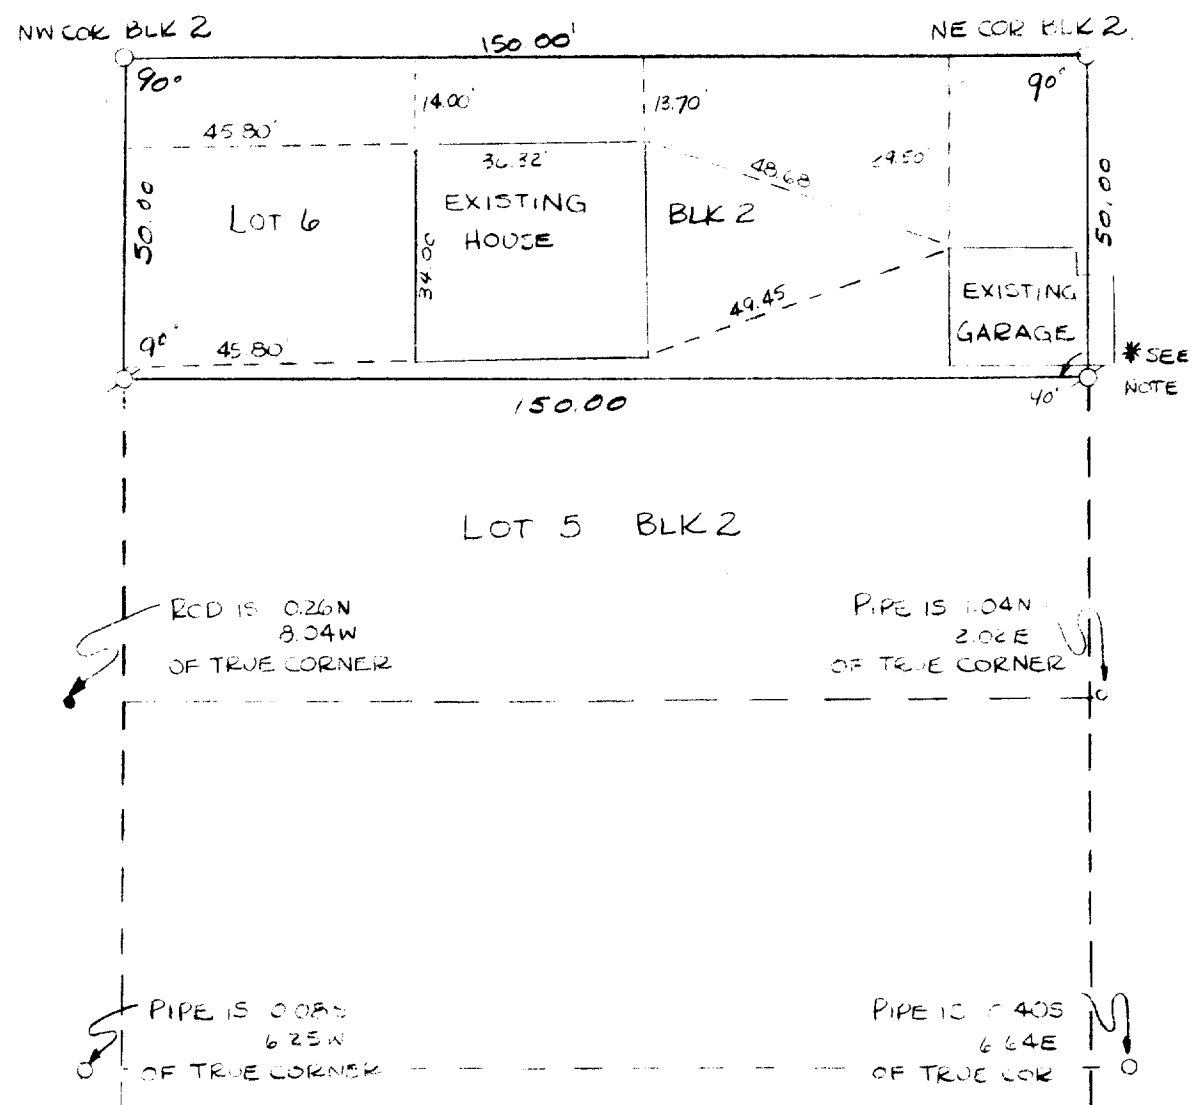

50' WIDE ROAD
ST.
FIRST

*NOTE - GARAGE IS 2' IS NORTH
OF SOUTH PROPERTY LINE
AND IS 4.50' EAST OF EAST
PROPERTY LINE

I HEREBY CERTIFY THE ABOVE DESCRIBED
PROPERTY HAS BEEN SURVEYED UNDER
MY DIRECTION AND THAT THE PLAT HERE-
ON IS AN ACCURATE SURVEY AND A TRUE
REPRESENTATION THEREOF AND COR-
RECTLY SHOWS THE BOUNDARY LINES OF
SAID PROPERTY AND ALL IMPROVEMENTS
THEREON. 7-20-79

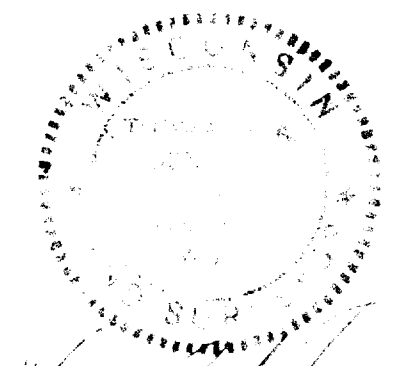

THOMAS P.A. JENSEN S-1084
JENSEN SURVEYING & MAPPING
ELKHORN, WIS 53121

417-630