

FARRIS, HANSEN & COOPER, INC.

ENGINEERING, SURVEYING AND LAND PLANNING
715 W. WALWORTH ST. - P.O. BOX 487 - ELKHORN, WI 53121

PLAT OF SURVEY OF

PART OF LOT 6, BLOCK 2, TRINKE ESTATES, LOCATED IN THE SOUTHEAST
1/4 OF SECTION 10, TOWN 1 NORTH, RANGE 17 EAST, TOWN OF LINN,
WALWORTH COUNTY, WISCONSIN, AS DESCRIBED IN VOLUME 587, PAGE 87
OF DEEDS.

NOTE: The Southerly line of Lot 6 is assumed to bear
"EAST" as shown on the subdivision plat of
Trinke Estates.

OWNER: Allen B. Bentz

I HEREBY CERTIFY that I have surveyed the property described
hereon and that this Plat of Survey is a true and accurate
representation of the lot lines to the best of my professional
knowledge and belief.



Daniel D. Cooper
Daniel D. Cooper, RLS No. 1464

Dated this 24 day of Oct., 1979.

0 10 20 40
SCALE IN FEET
1"=40'

LEGEND

○-Iron Pipe Found
○-1" Dia. x 24"
Iron Pipe Set
()-Record Dimension

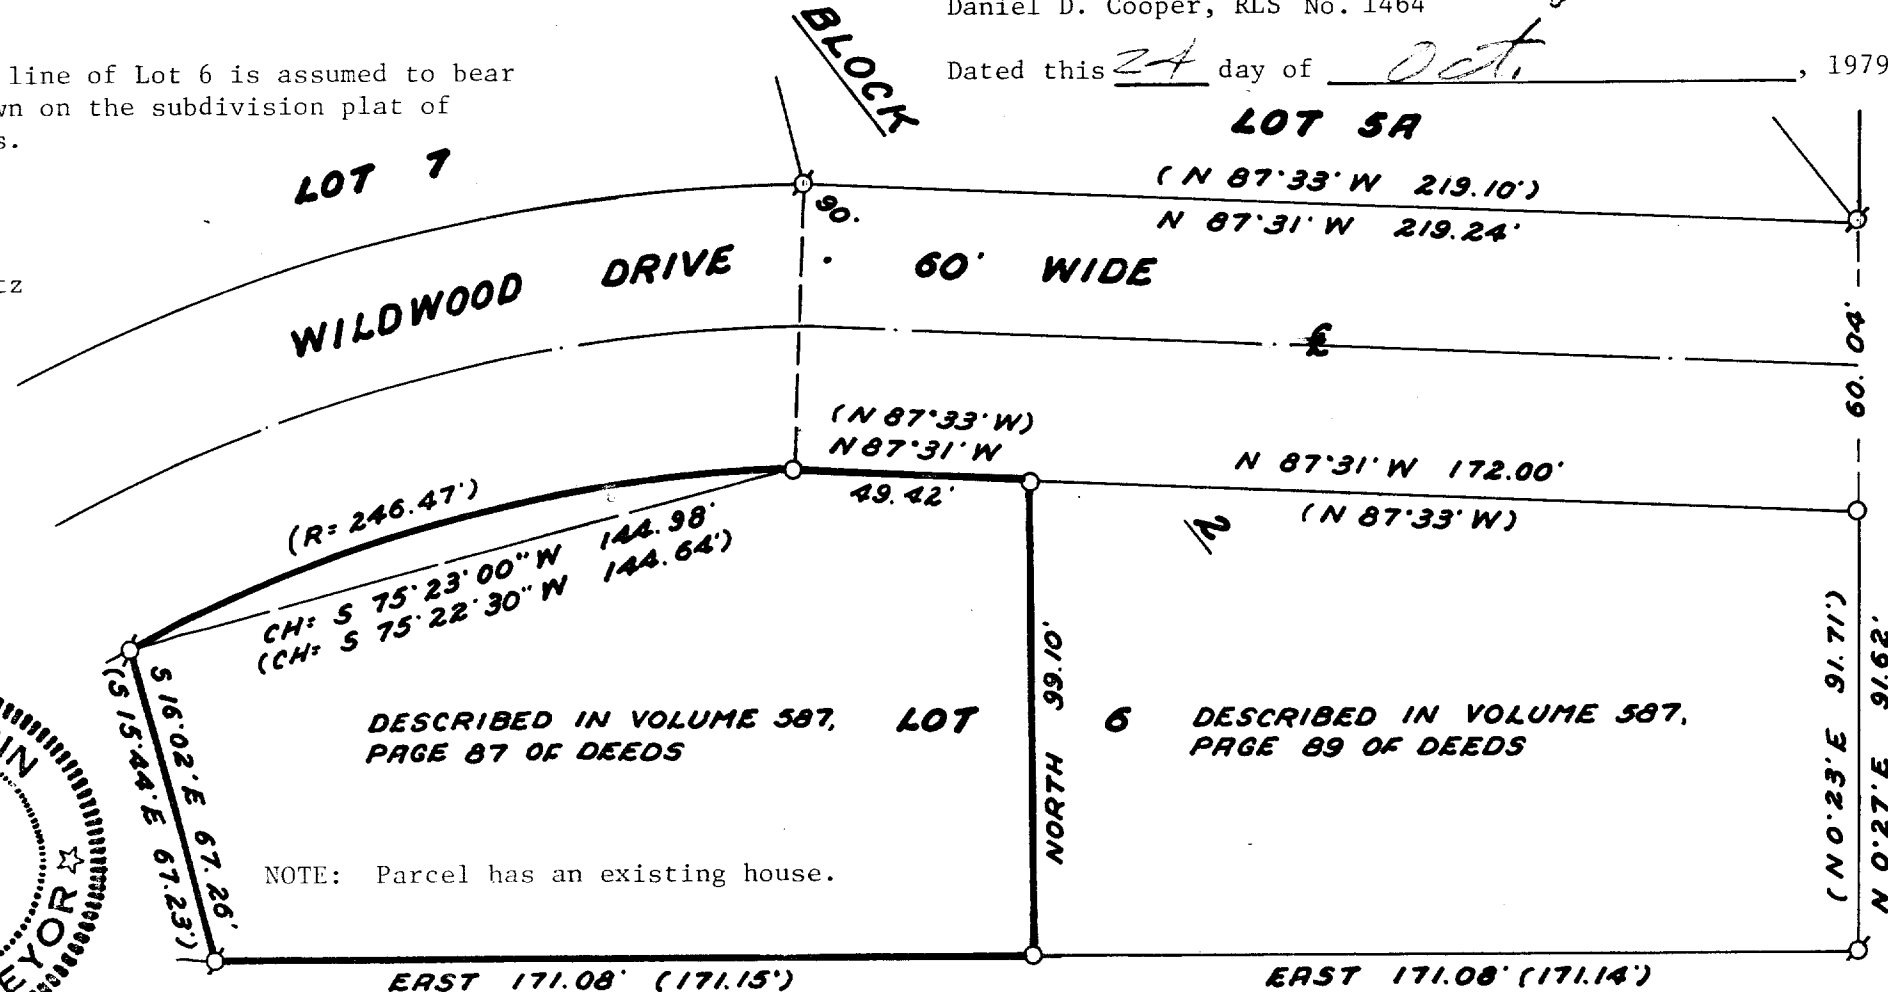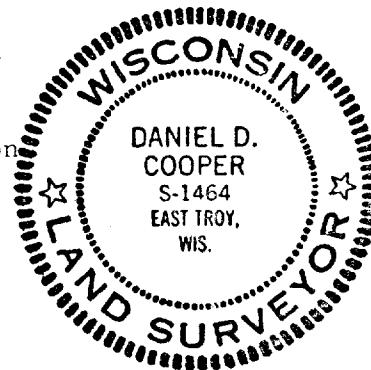

NOTE: Parcel has an existing house.

PROJ. NO. 1624

117-635 ✓