


KOLB LAND CONSULTING, INC.
LAKE GENEVA, WISCONSIN

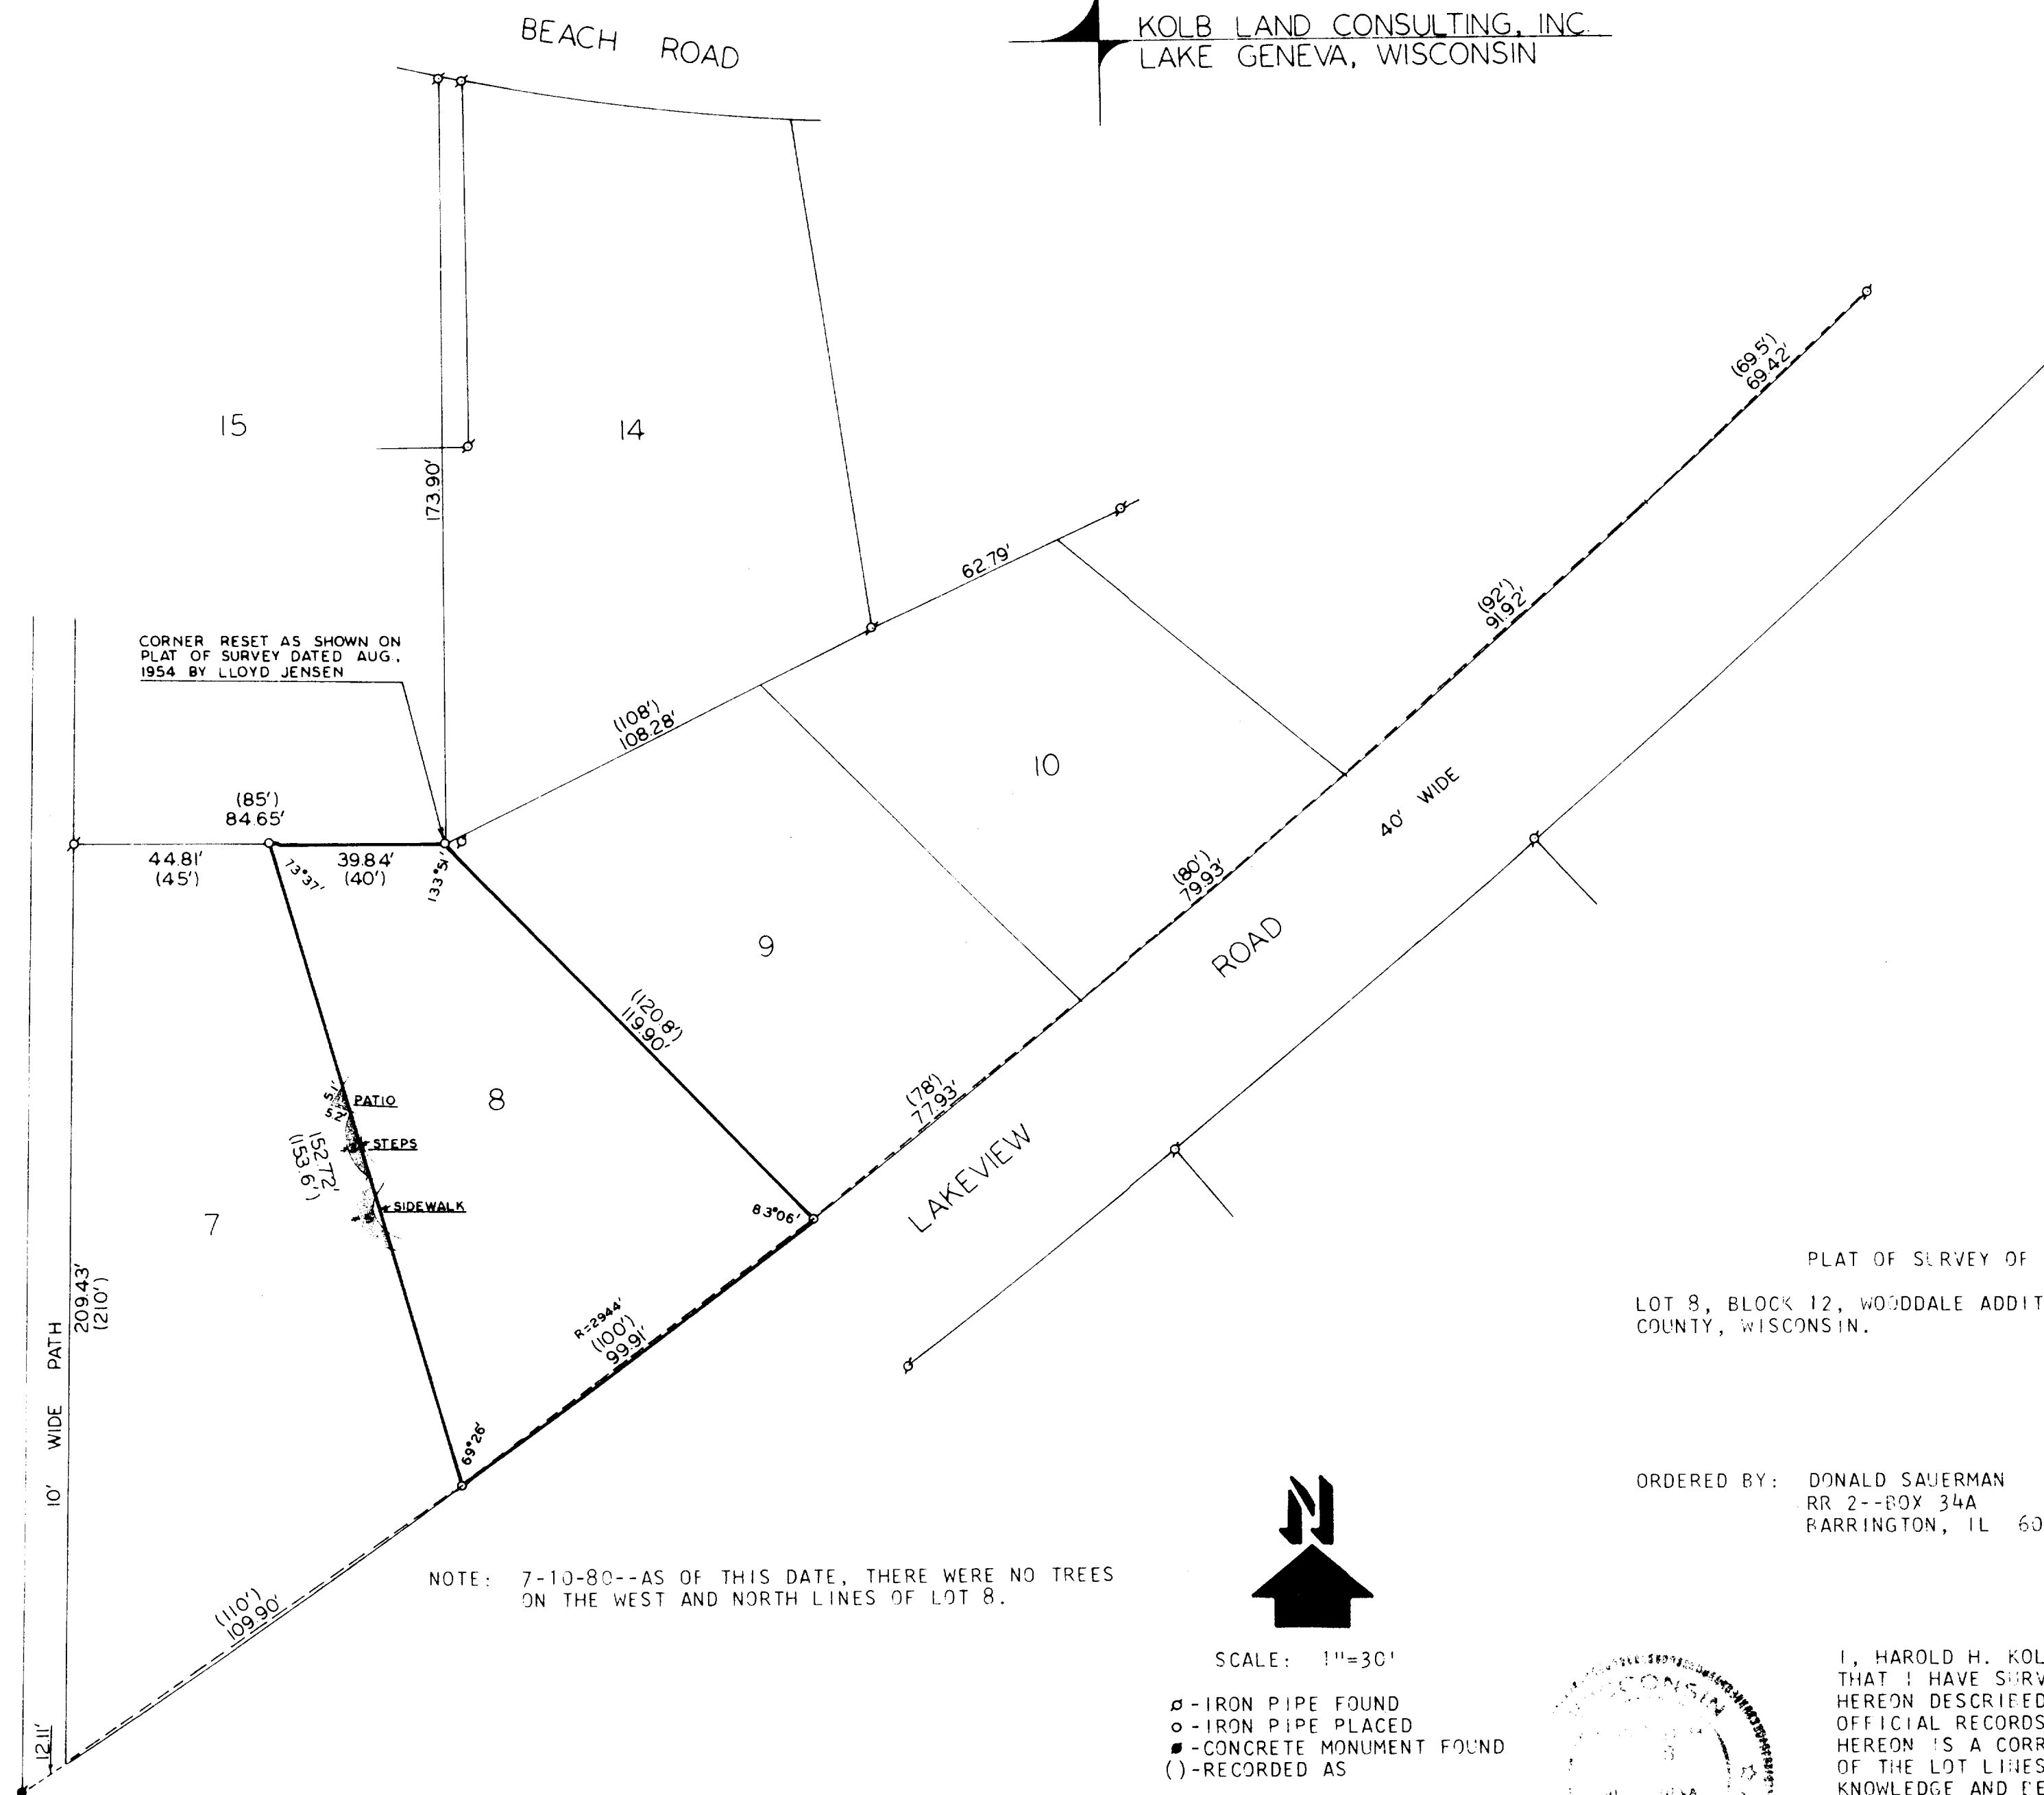

PLAT OF SURVEY OF
LOT 8, BLOCK 12, WOODDALE ADDITION, WALWORTH
COUNTY, WISCONSIN.

ORDERED BY: DONALD SAUERMAN
RR 2--BOX 34A
BARRINGTON, IL 60010



SCALE: 1"=30'

o - IRON PIPE FOUND
o - IRON PIPE PLACED
■ - CONCRETE MONUMENT FOUND
() - RECORDED AS



I, HAROLD H. KOLB, DO HEREBY CERTIFY
THAT I HAVE SURVEYED THE PROPERTY
HEREON DESCRIBED ACCORDING TO THE
OFFICIAL RECORDS, AND THAT THE PLAT
HEREON IS A CORRECT REPRESENTATION
OF THE LOT LINES TO THE BEST OF MY
KNOWLEDGE AND BELIEF.

Harold H. Kolb
HAROLD H. KOLB
WISCONSIN REGISTERED LAND SURVEYOR, S-187

DATE *July 10, 1980*