



PLAT OF SURVEY

A PARCEL OF LAND LOCATED IN THE NE 1/4 OF
SECTION 5, TOWNSHIP 1 NORTH, ~~RANGE~~ 17 EAST IN
LINN TOWNSHIP, WALWORTH COUNTY, WISCONSIN

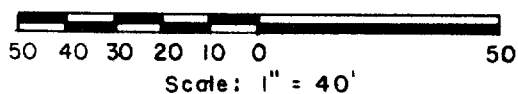

KEY

- Iron Pipe Found
- Iron Rod Set
- () Recorded as

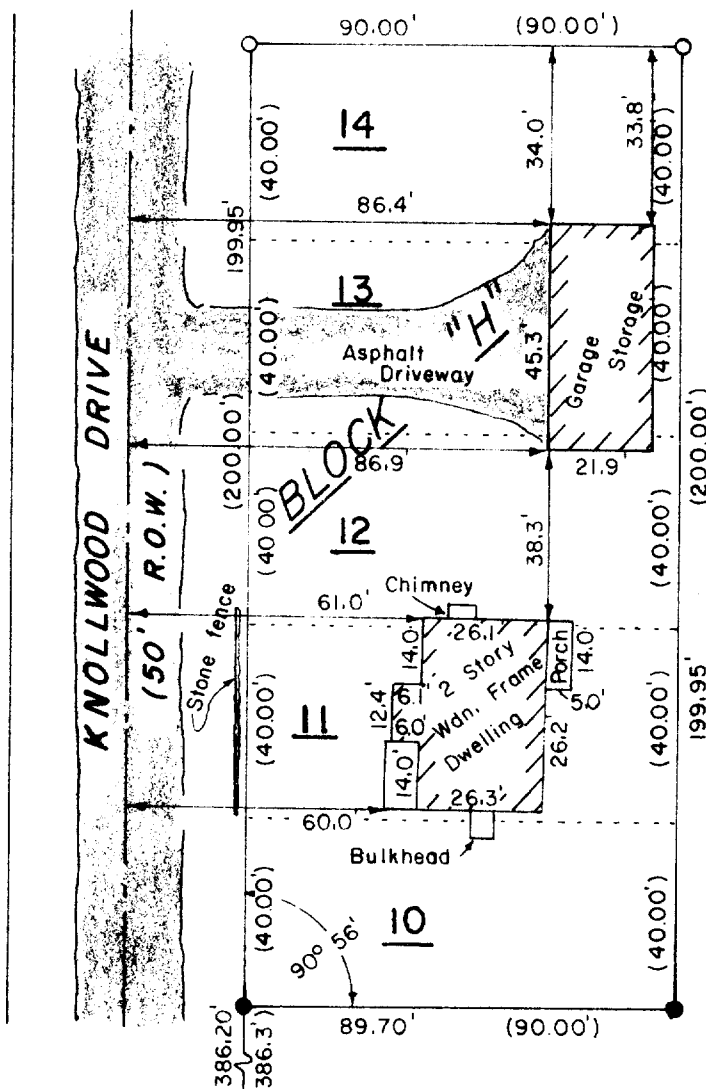


DESCRIPTION: Lots 10, 11, 12, 13 and 14 in Block "H" of CISCO BEACH, a recorded subdivision in the NE 1/4 of Section 5, Township 1 North, Range 17 East in Linn Township, Walworth County, Wisconsin.

SURVEYOR'S CERTIFICATE: I hereby certify that I have surveyed the above described property and that the above map is a true representation thereof and shows the size and location of the property, its exterior boundaries, apparent easements, roadways and visible encroachments, if any. This survey is made for the use of the present owners of the property, and also those who purchase, mortgage, or guarantee the title thereto within one (1) year from date hereof.

February 13, 1980
Date

Dennis W. Valentine
Dennis W. Valentine, RES.

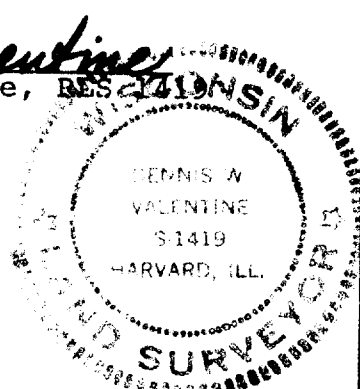

Prepared By
VALENTINE AND ASSOCIATES, INC.
DELAVER, WISCONSIN

Prepared For
GENE RAY
WILLIAMS BAY, WISCONSIN

Date
2/9/80
Job Number
80004

Sheet Number
1 of 1
Reference
File

117-6364