


KOLB LAND CONSULTING, INC.

LAND SURVEYING • SUBDIVIDING • LAND PLANNING

LAKE GENEVA, WISCONSIN 53147

WHITEWATER, WISCONSIN 53190

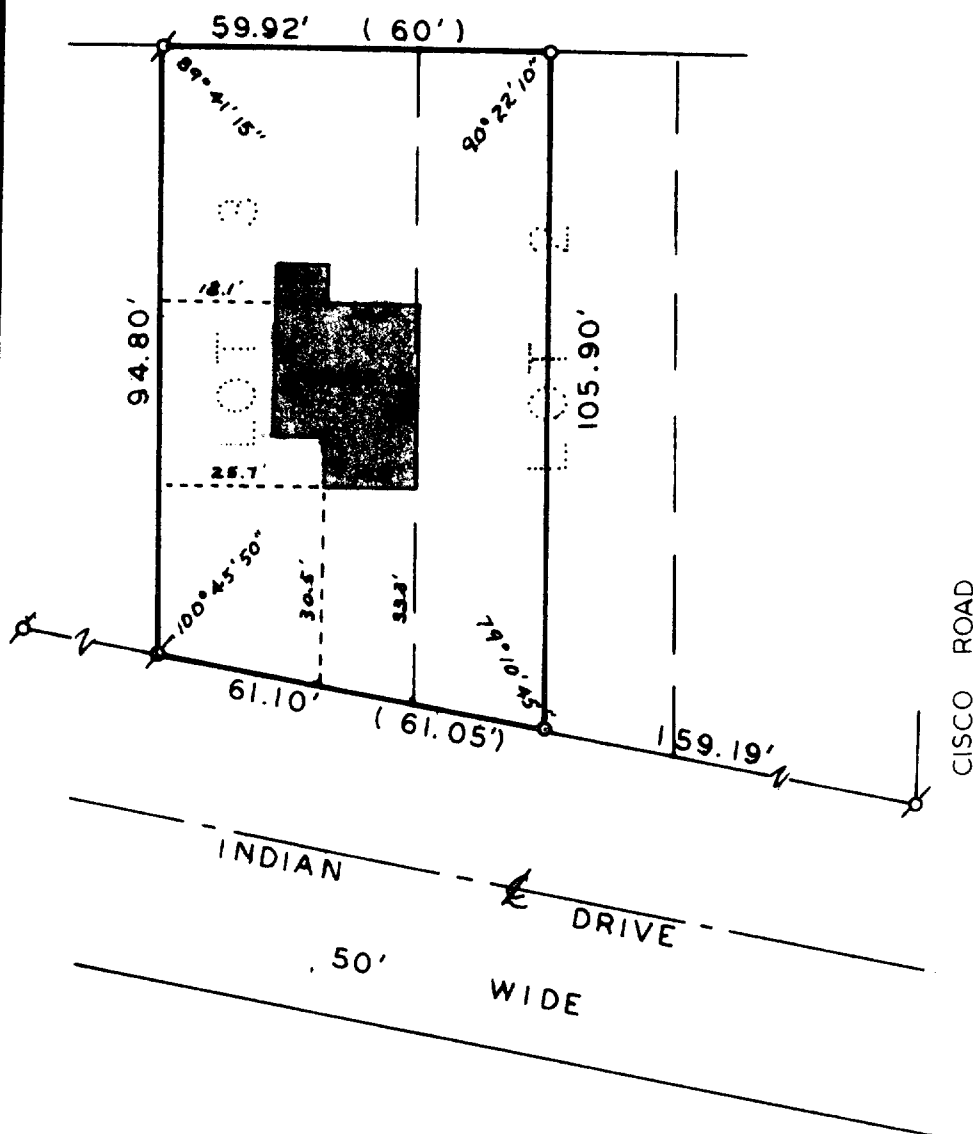

SCALE: 1"=30'

PLAT OF SURVEY OF

LOT 3 AND THE WEST $\frac{1}{2}$ OF LOT 2, BLOCK J,
CISCO BEACH SUBDIVISION, WALWORTH COUNTY,
WISCONSIN.

ORDERED BY: Robert C. Hamilton
230 Blackhawk
Park Forest, IL 60466

LEGEND

⌀ - IRON PIPE FOUND
○ - IRON PIPE SET
() - RECORDED AS

I, HAROLD H. KOLB, DO HEREBY CERTIFY THAT I HAVE
SURVEYED THE PROPERTY HEREON DESCRIBED ACCORDING
TO THE OFFICIAL RECORDS, AND THAT THE PLAT HEREON
IS A CORRECT REPRESENTATION OF THE LOT LINES TO
THE BEST OF MY KNOWLEDGE AND BELIEF.

Harold H. Kolb

HAROLD H. KOLB
WISCONSIN REGISTERED LAND SURVEYOR, S-187
DATE Sept. 4, 1980