


FARRIS, HANSEN & COOPER, INC.

ENGINEERING, SURVEYING AND LAND PLANNING
715 W. WALWORTH ST. - P.O. BOX 487 - ELKHORN, WI 53121

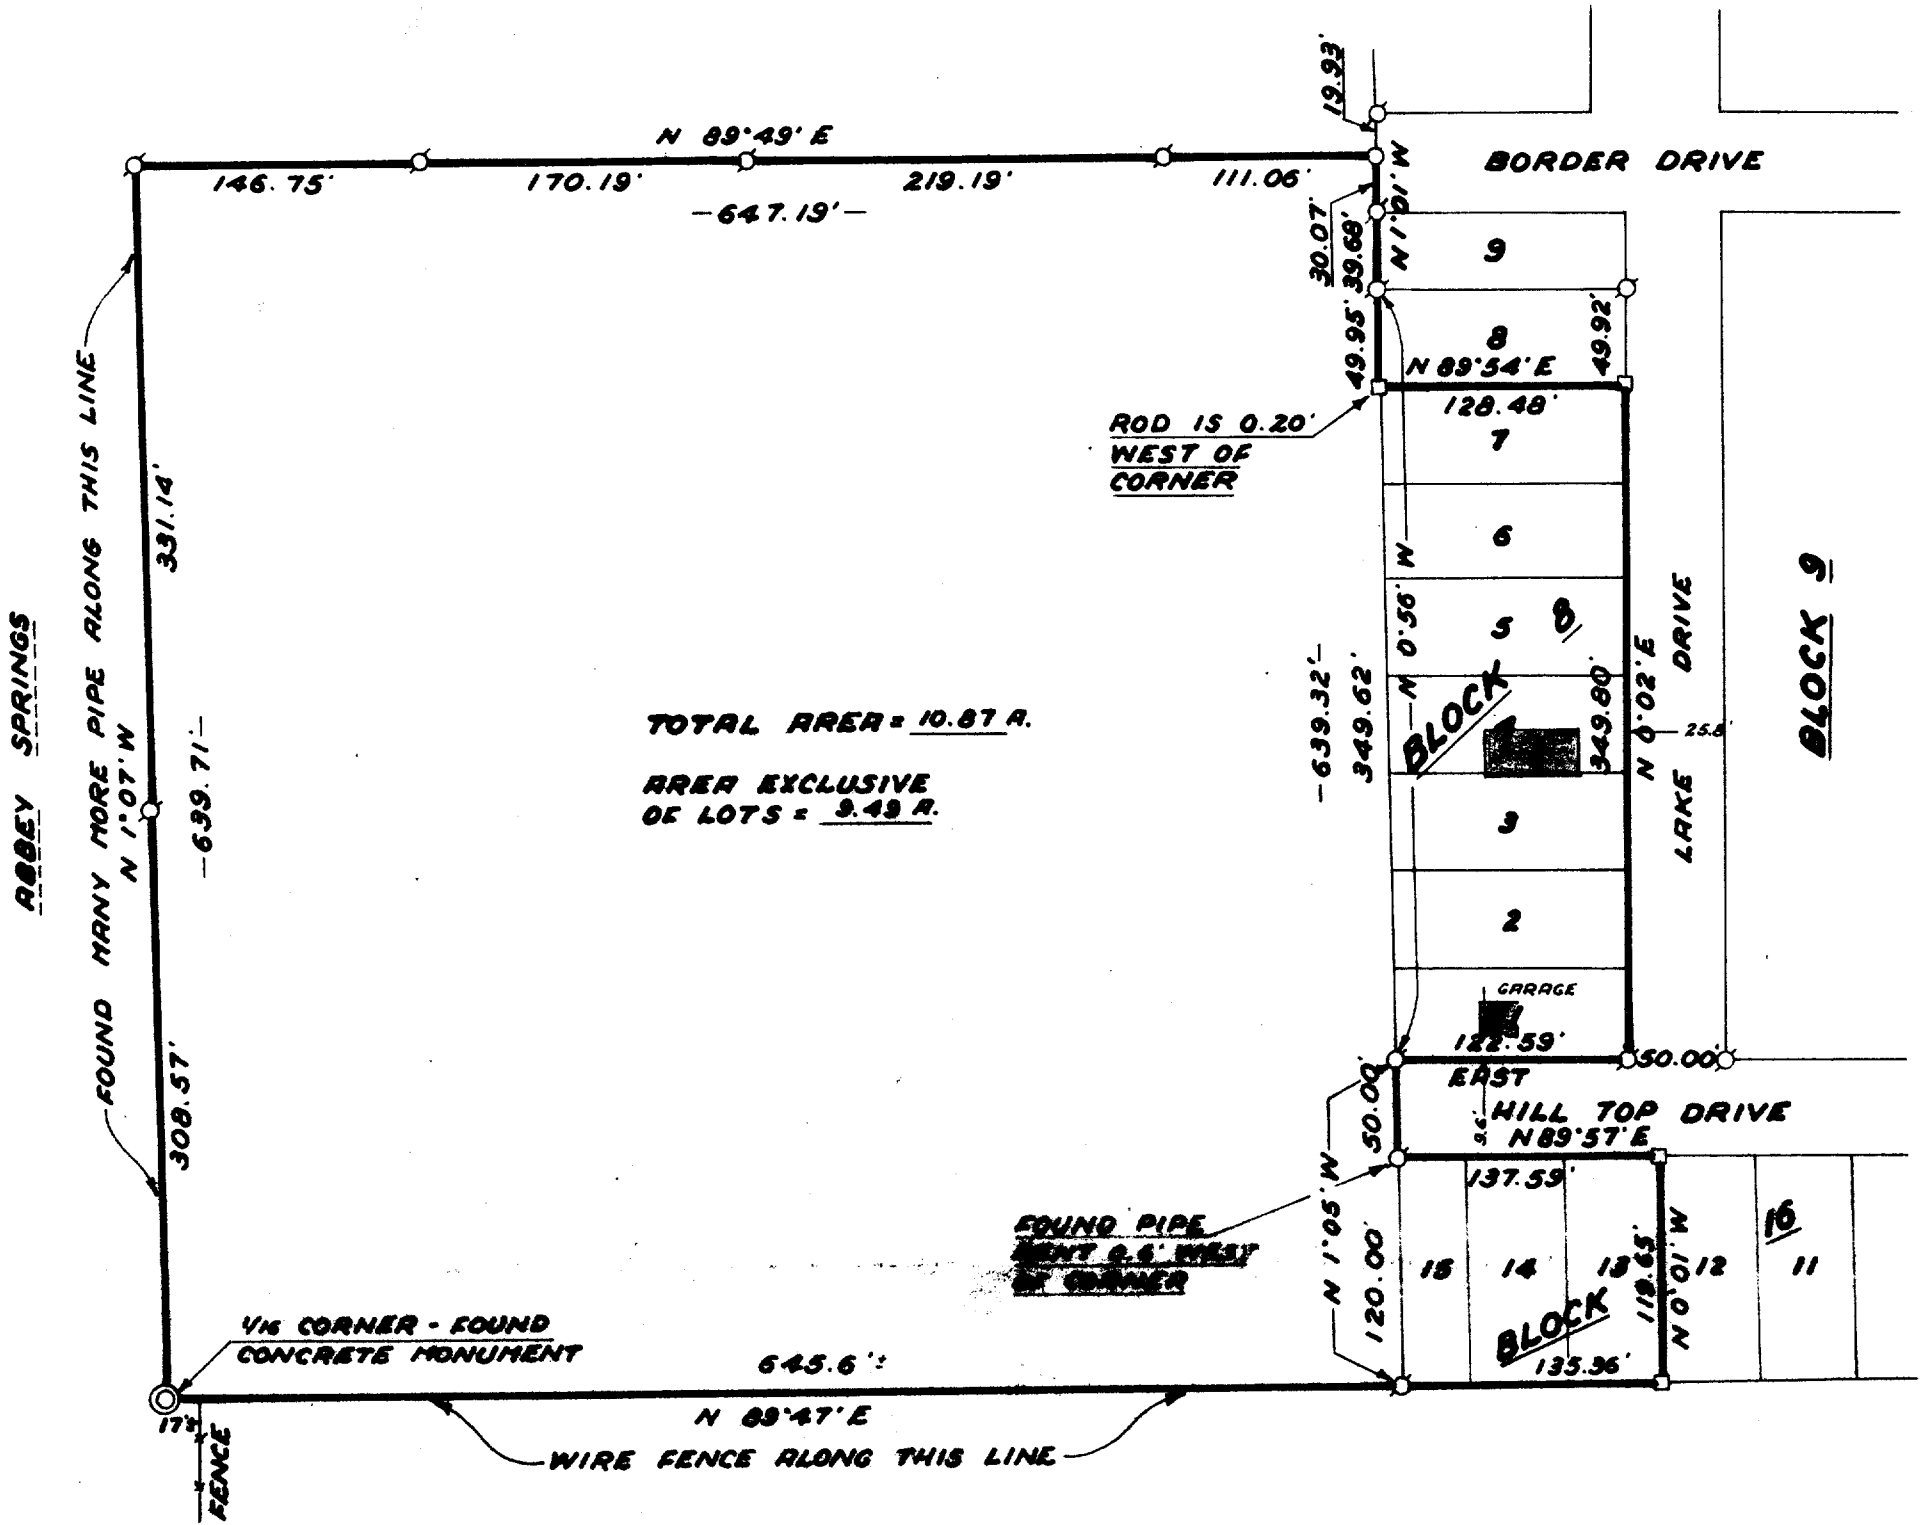

PLAT OF SURVEY OF

THE SOUTH 640 FEET OF THE WEST 1/2 OF THE SOUTHEAST 1/4 OF THE SOUTH-WEST 1/4, ALSO LOTS 1, 2, 3, 4, 5, 6 AND 7 OF BLOCK 8 AND LOTS 13, 14 AND 15 OF BLOCK 16 OF MAPLE HILLS "A", ALL IN SECTION 18, TOWN 1 NORTH, RANGE 17 EAST, WALWORTH COUNTY, WISCONSIN.

LEGEND

- Found 3/8" Sq. Iron Rod
- Found Iron Pipe
- Set Iron Pipe
- ⊙—Found 5" Dia. Conc. Mon.
- ()—Record Dimension

ORDERED BY:


Spencer Willison

I HEREBY CERTIFY that this is a true and accurate representation of the property lines as found to be monumented to the best of my knowledge and belief.

Robert A. Farris

Robert A. Farris, RLS No. 1293

Dated this 12th day of December, 1979.

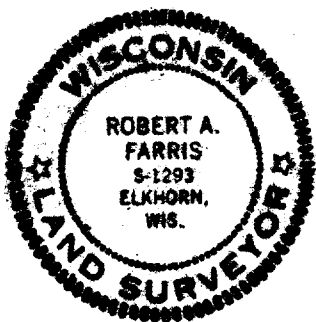

PROJECT NO. 1639

L-18-19B + lta

117-638