


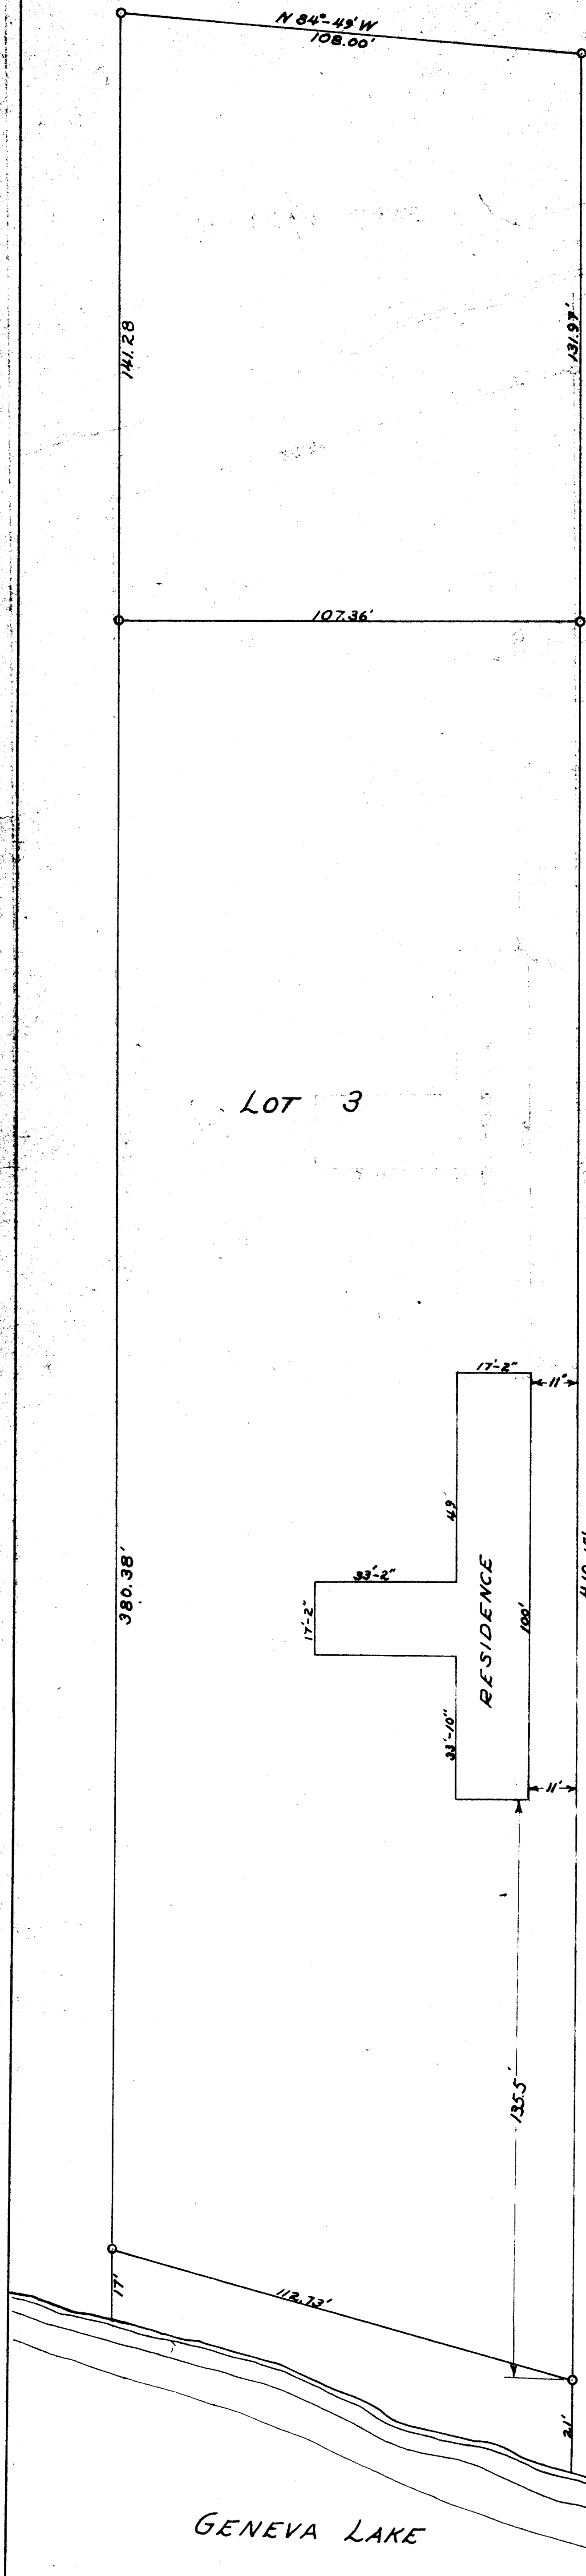

SCALE - 1" = 20'
O = IRON PIPE

LOT 3

I HEREBY CERTIFY THAT I HAVE SURVEYED THE FOLLOWING DESCRIBED PROPERTY: LOT 3 OF S.B. CHAPINS SUBDIVISION, A PART OF FRACTIONAL SECTION (W) T1N, R1E OF WALWORTH COUNTY, WISCONSIN. ALSO BEGINNING AT THE N.E. CORNER OF LOT 3 OF S.B. CHAPINS SUBDIVISION; THENCE NORTH IN EAST LINE OF SAID LOT PRODUCED A DISTANCE OF 131.97 FT.; THENCE $N 84^{\circ} 43' W$ 108 FT; THENCE SOUTH 141.28 FT TO THE NW CORNER OF SAID LOT 3; THENCE EAST IN THE NORTH LINE OF SAID LOT 3 A DISTANCE OF 107.36 FT. TO THE PLACE OF BEGINNING.

I FURTHER CERTIFY THAT THE PLAT SHOWN HERE ON IS A CORRECT REPRESENTATION OF SAID SURVEY AND NO ENCROACHMENTS EXIST ON THE ABOVE DESCRIBED PROPERTY.

AUG. 1999

H. E. Johnson
SURVEYOR

ICH-2A

117-64.1

117-64.1