


N

DUNHAM SURVEYING, S.C.
SURVEYING & SUBDIVIDING
DELAVER, WISCONSIN 53115

Scale - 1" = 20'

- = Iron Pipe Found
- = Iron Pipe Found bent & reset
- = Tree

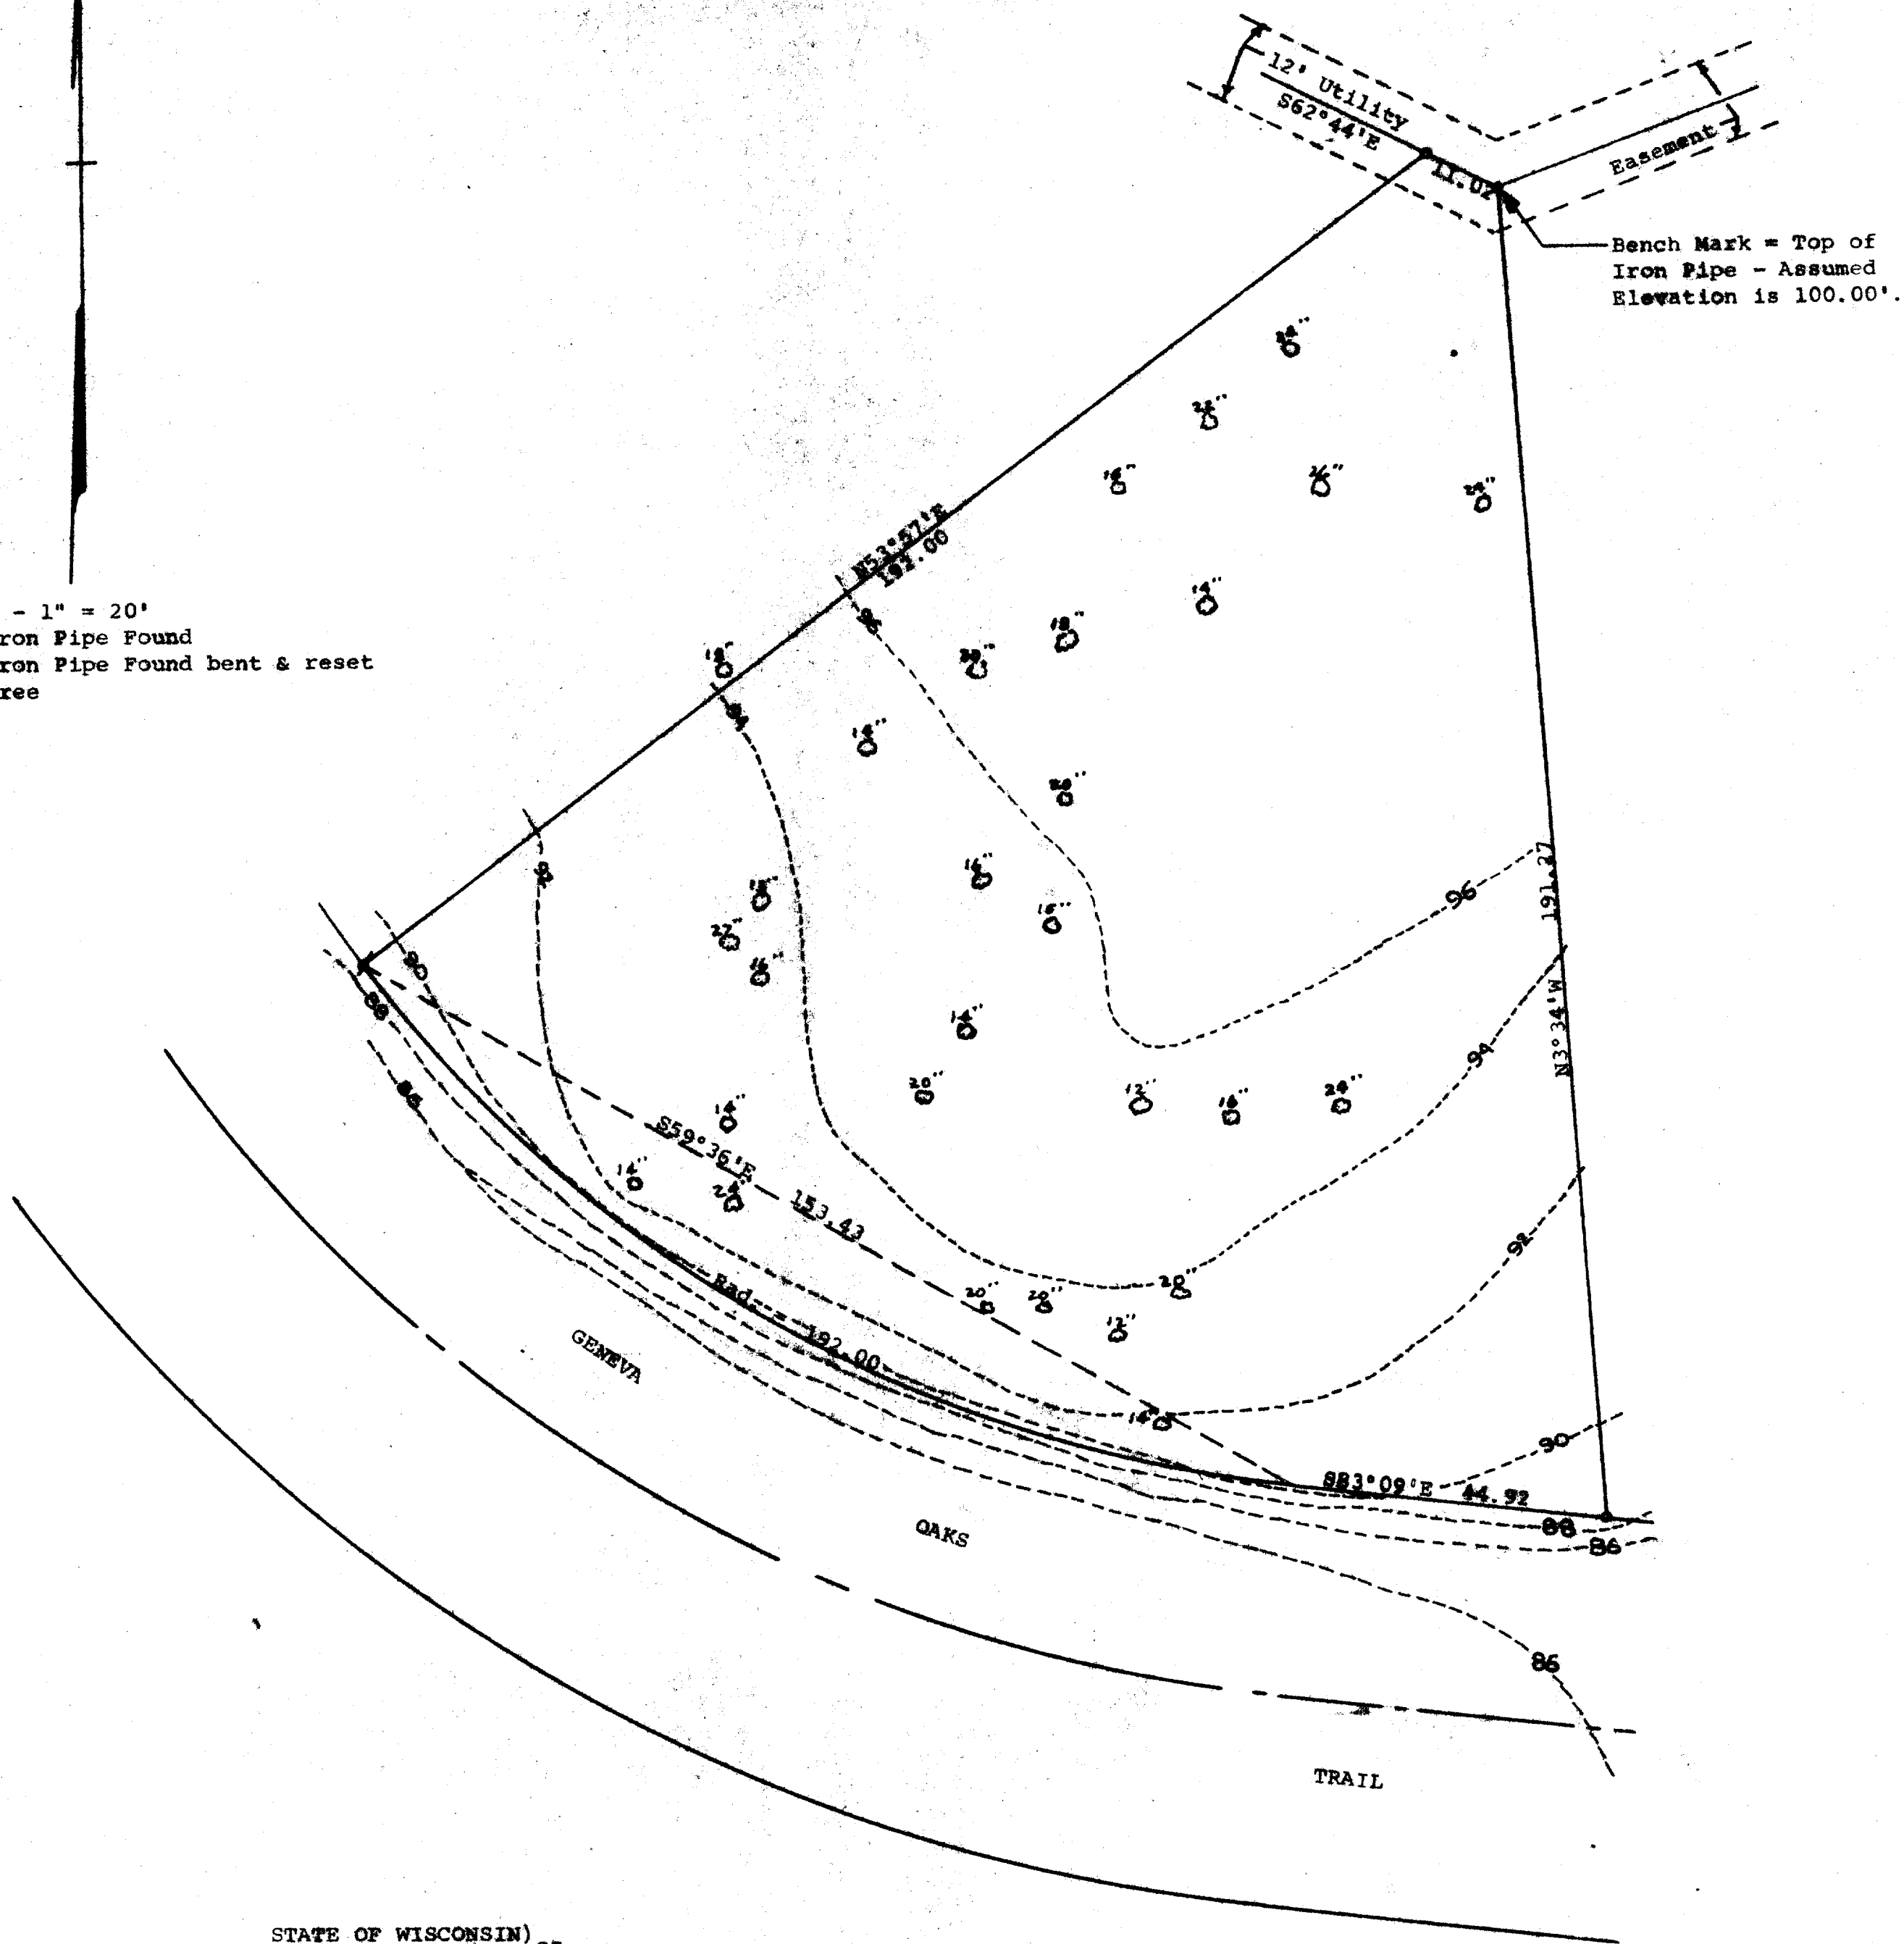

Bench Mark = Top of
Iron Pipe - Assumed
Elevation is 100.00'.

STATE OF WISCONSIN)
COUNTY OF WALWORTH)

I, George T. Dunham, Surveyor, certify that I have surveyed the property described as follows:

Lot 9, Geneva Oaks, a subdivision located in Gov't Lot 3 in the North-west $\frac{1}{4}$ of Section 4, T 1 N, R 17 E, Walworth County, Wisconsin.

and that the above map is a true representation thereof and shows the size and location of the property, its exterior boundaries, the location of all visible structures and dimensions of all principal buildings thereon, boundary fences, apparent easements, roadways and visible encroachments, if any.

This survey is made for the use of the present owners of the property, and also those who purchase, mortgage, or guarantee the title thereto within one year from date hereof.

December 29, 1980.

Revised January 27, 1981.

George T. Dunham
George T. Dunham, Surveyor

