



PLAT OF SURVEY OF LOT 45, THE BIRCHES 1ST ADDITION

A SUBDIVISION LOCATED IN THE S.E. 1/4 OF SECTION 9, T1N, R1E WALWORTH CO. WIS.

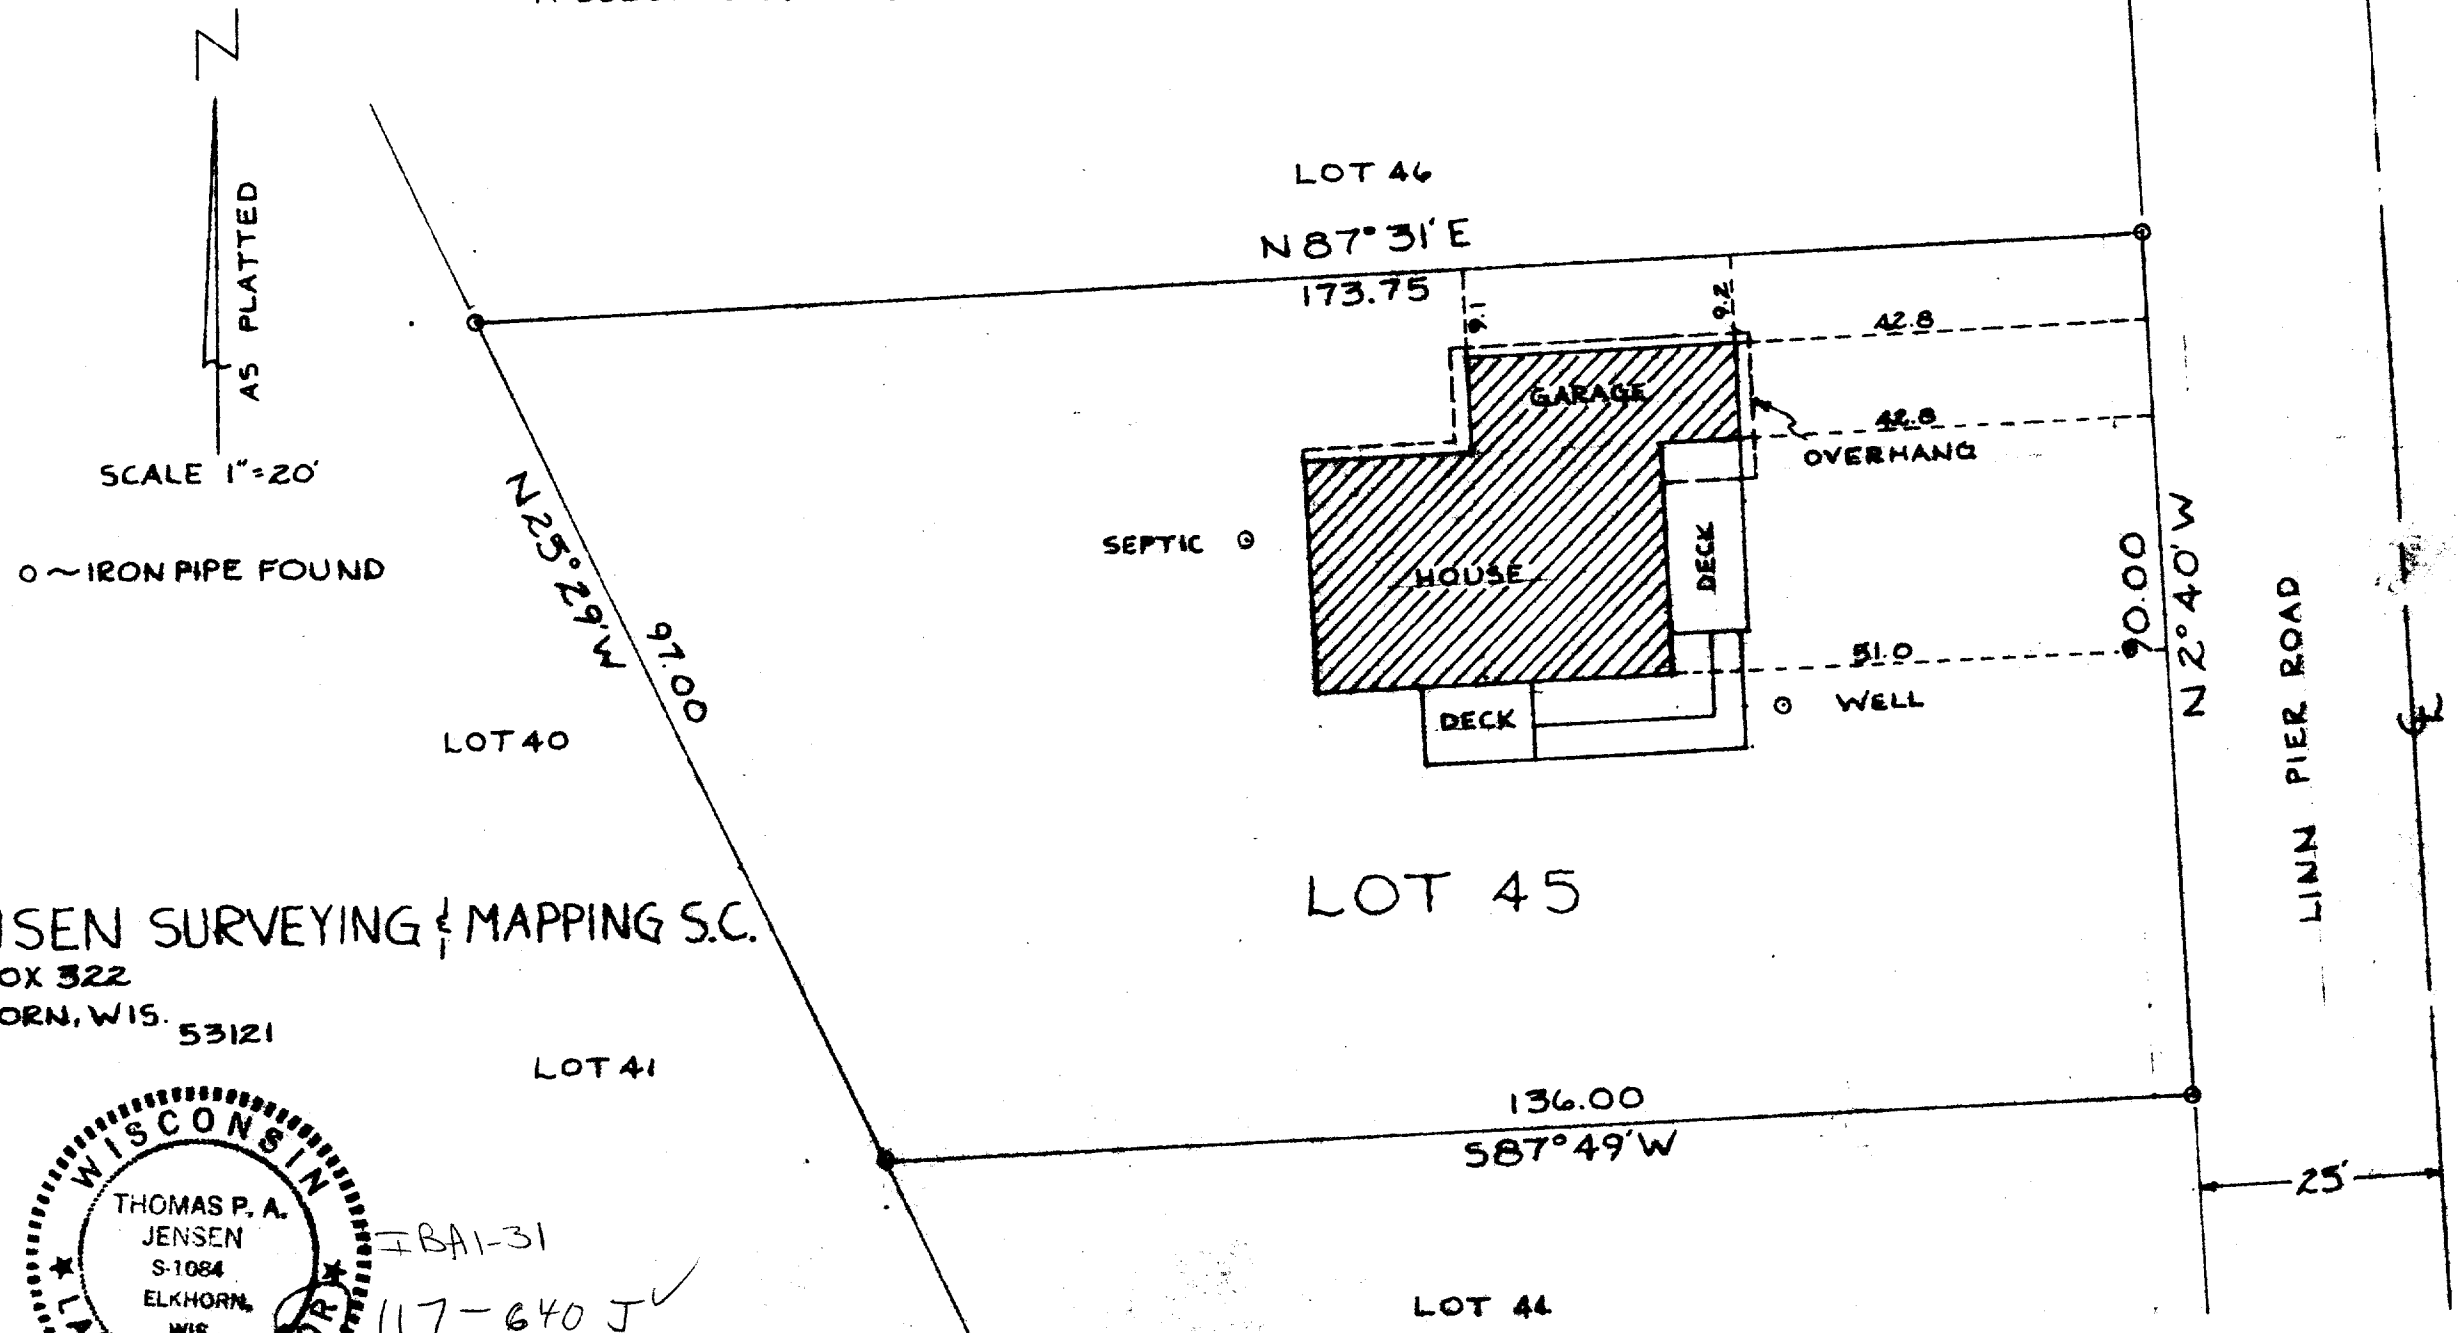

JENSEN SURVEYING & MAPPING S.C.
P.O. BOX 322
ELKHORN, WIS. 53121

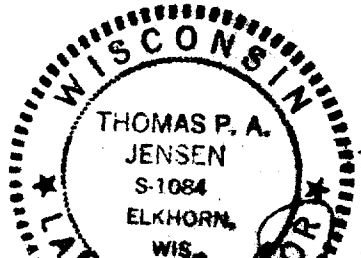

BAI-31
117-640 J ✓