
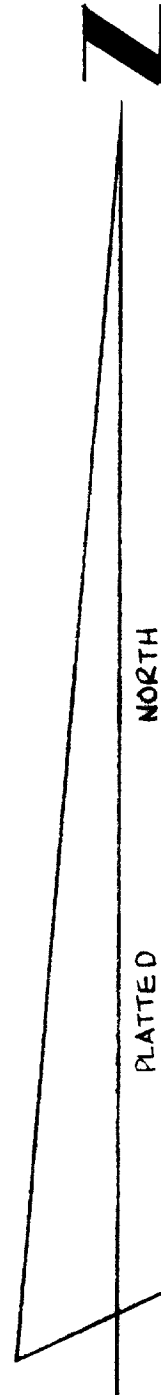


PLAT OF SURVEY
OF

LOTS 13 AND 14 OF BLOCK 1 OF WOODDALE ADDITION
TOGETHER WITH THOSE PORTIONS OF LOT X WHICH LIE
SOUTH OF SAID LOTS 13 AND 14 AND LOTS 5 THRU 14
INCLUSIVE OF BLOCK 3 OF WOODDALE ADDITION TOGETHER
WITH A 10' WIDE STRIP OF LAND BEING PART OF LOT 15, BLOCK 3;
AND A 10' WIDE STRIP OF LAND EAST OF LOT 14, BLOCK 1 AND LOT X
ALL LOCATED IN THE SW 1/4 OF SECTION 9, TOWN 1 NORTH,
RANGE 17 EAST, TOWN OF LINN, WALWORTH COUNTY,
WISCONSIN

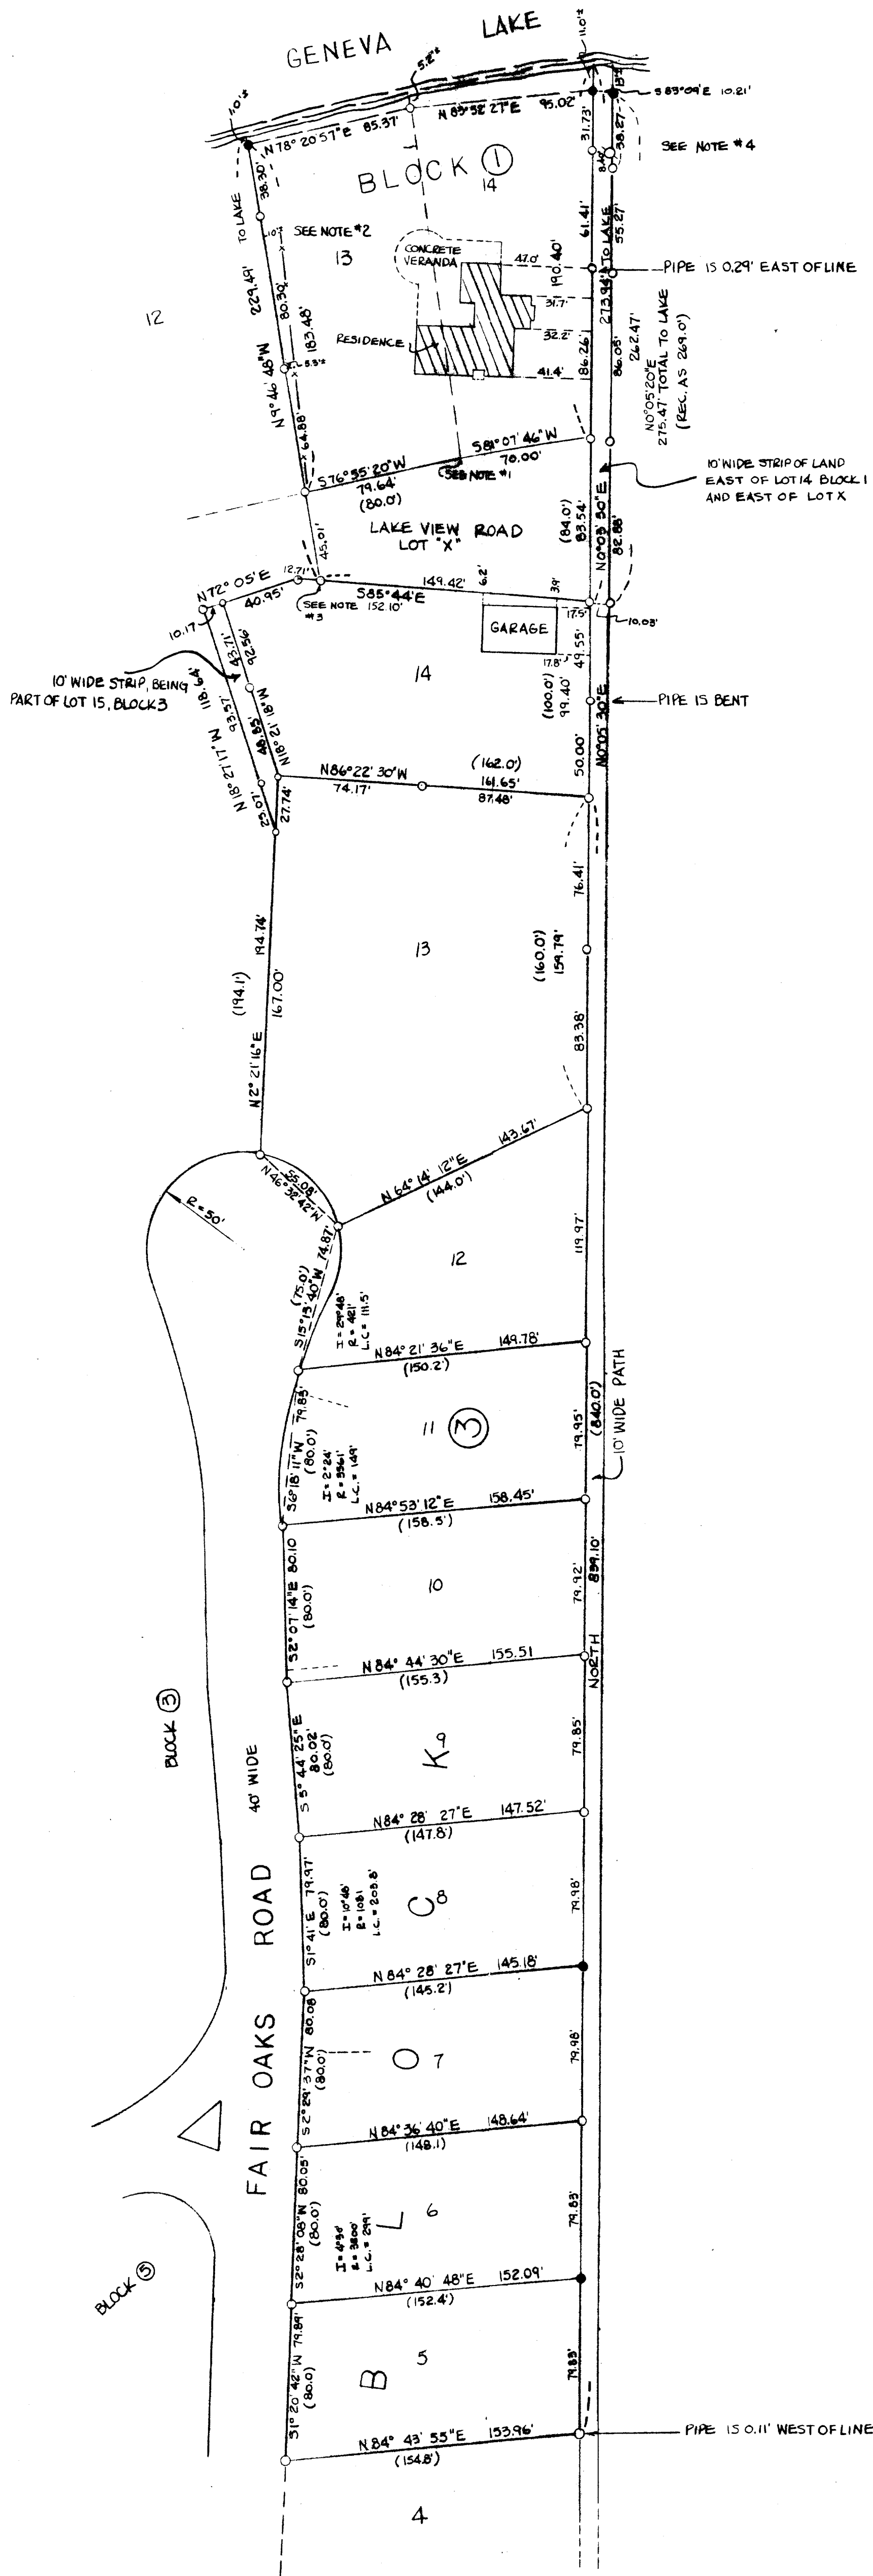

SCALE 1" = 50 FEET

LEGEND

- - IRON PIPE FOUND
- - CONCRETE MONUMENT FOUND
- - IRON BAR 1 3/16" DIA. & 30" LONG SET


NOTE #1 - CORNER FALLS ON STONE SIDEWALK
NOTE #2 - EXISTING FENCE ENCROACHES ON LOT 13 BLOCK 1
NOTE #3 - FOUND IRON PIPE 13.00'S AND 0.1'E. OF TRUE CORNER
NOTE #4 - CONCRETE MONUMENT IS 0.01' WEST OF LINE

SURVEY ORDERED BY: LAW OFFICES
GOFFREY, PFEIL & NESHEK, S.C.
ELKHORN, WISCONSIN 53121

NOTE: CURVE DATA - AS RECORDED

JENSEN SURVEYING & MAPPING, S.C.
P.O. BOX 322
ELKHORN, WIS. 53121

I HEREBY CERTIFY THAT THE ABOVE DESCRIBED LAND
HAS BEEN SURVEYED UNDER MY DIRECTION AND THAT
THE PLAT HEREON DRAWN IS AN ACCURATE SURVEY AND
A TRUE REPRESENTATION THEREOF AND CORRECTLY SHOWS
THE BOUNDARY LINES OF SAID PROPERTY.
DATED 4-28-81

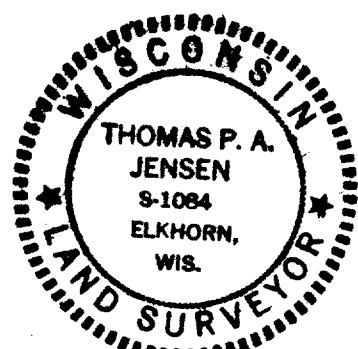

Thomas P. A. Jensen
THOMAS P. A. JENSEN / RLS-1084