

PLAT OF SURVEY

OF

LOT 3 OF BLOCK 2 OF SUNSET HILLS SUBDIVISION
LOCATED IN THE SE 1/4 OF THE NW 1/4 OF SECTION 4, T1N,
R17E, WALWORTH COUNTY, WISCONSIN

I HEREBY CERTIFY THAT THE ABOVE DESCRIBED PARCEL OF LAND
HAS BEEN SURVEYED UNDER MY DIRECTION AND THAT THE PLAT
HEREON DRAWN IS A CORRECT REPRESENTATION OF SAID SURVEY
AND CORRECTLY SHOWS THE EXTERIOR BOUNDARIES OF SAID
PROPERTY

5-9-80



SCALE 1" = 40'

LEGEND

- - IRON PIPE FOUND
- - IRON ROD FOUND 3/16" DIA.
- - IRON ROD SET 3/4" DIA. 30" LONG
- - POSEY PIN FOUND
- () - RECORDED AS


SURVEYED FOR: BRADEN & OLSEN ATTY'S

716 WISCONSIN
LAKE GENEVA, WI. 5-1084


THOMAS P. A. JENSEN

#1 NOTE - FOUND POSEY PIN BENT AND SET
ROD AT SAME POINT

#2 NOTE - FOUND PIN BENT AND EAST OF ROAD LINE 0.48'

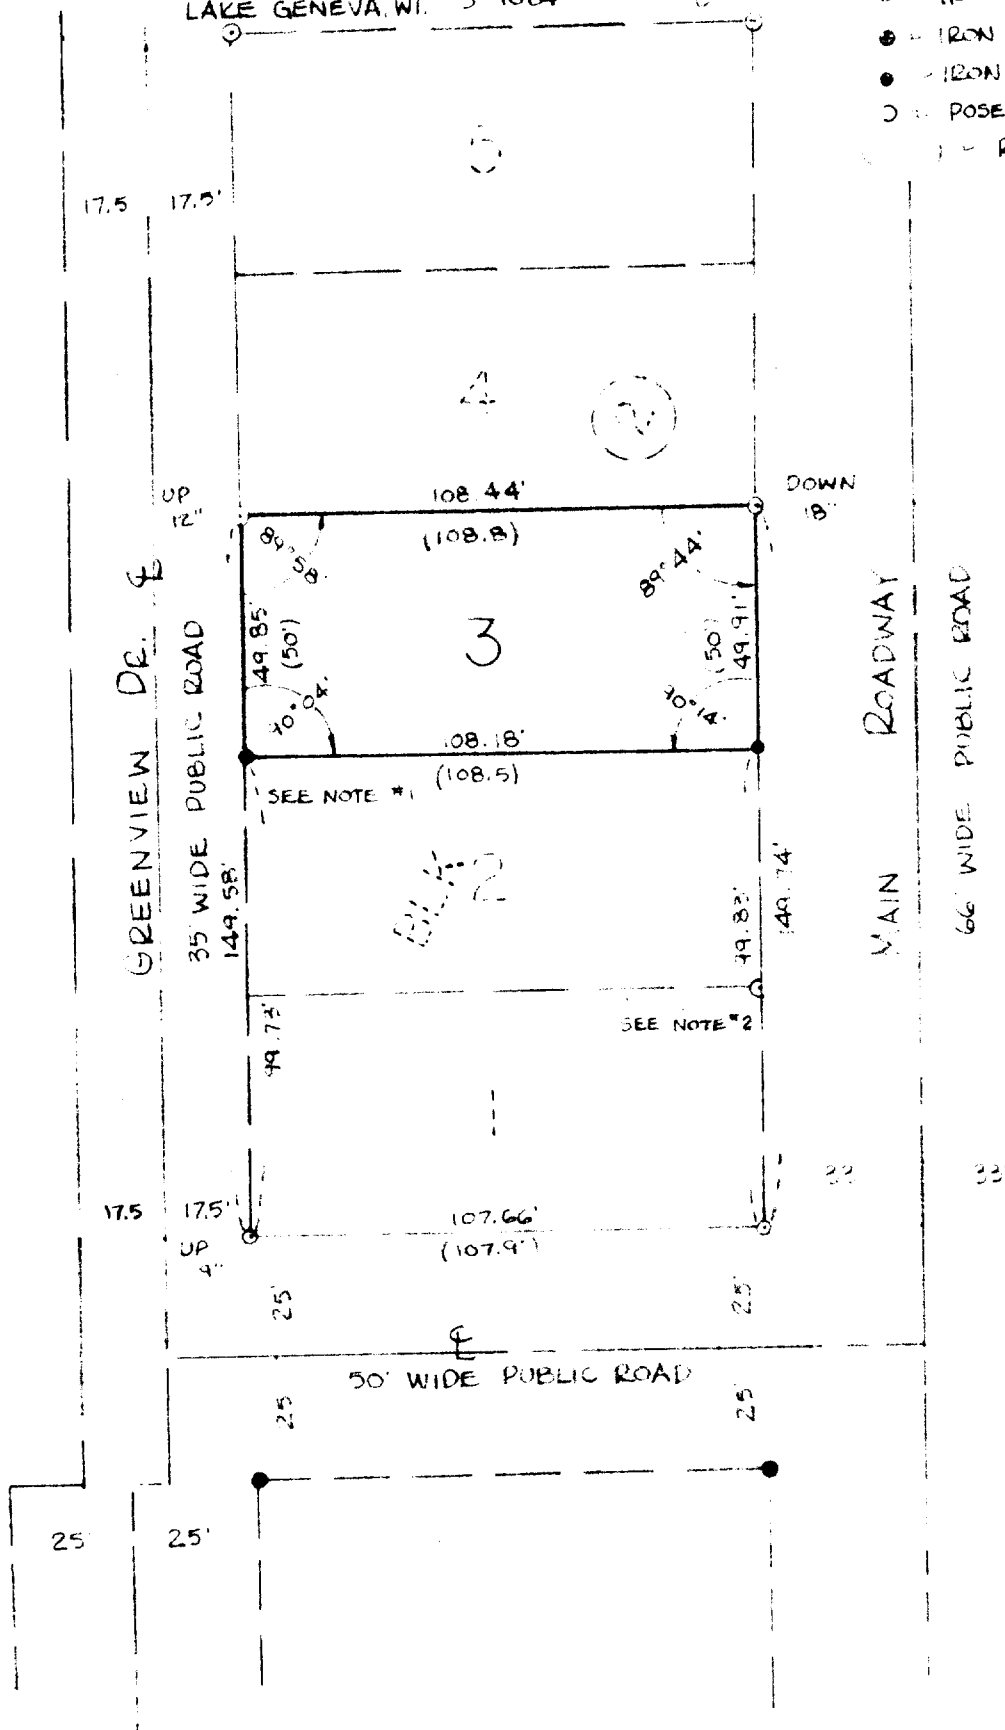

JENSEN
SURVEYING &
MAPPING
P.O. BOX 322
ELKHORN, WIS
53121

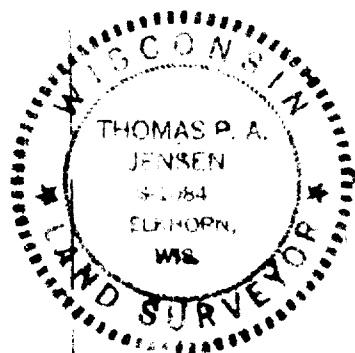

1980.021