

ON LOT 10 OF GENEVA OAKS SUBDIVISION, A SUBDIVISION LOCATED
IN GOVERNMENT LOT 3, IN THE N.W. 1/4 OF SECTION 4, T1N, R17E, TOWN
OF LINN, WALWORTH COUNTY, WISCONSIN.


P.O. BOX 322
ELKHORN, WIS. 53121-0322

(414) 723-5239

SURVEYED BY: THOMAS P.A. JENSEN S-1084

SURVEYED FOR: HOWARD FLOHR

MAPPING DATE JULY 28, 1982


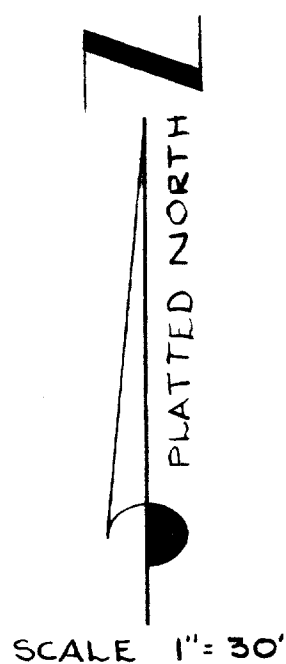


SCALE 1" = 30'

LEGEND

- FOUND IRON PIPE
- WOOD STAKE SET

THOMAS P.A. JENSEN 5-1084

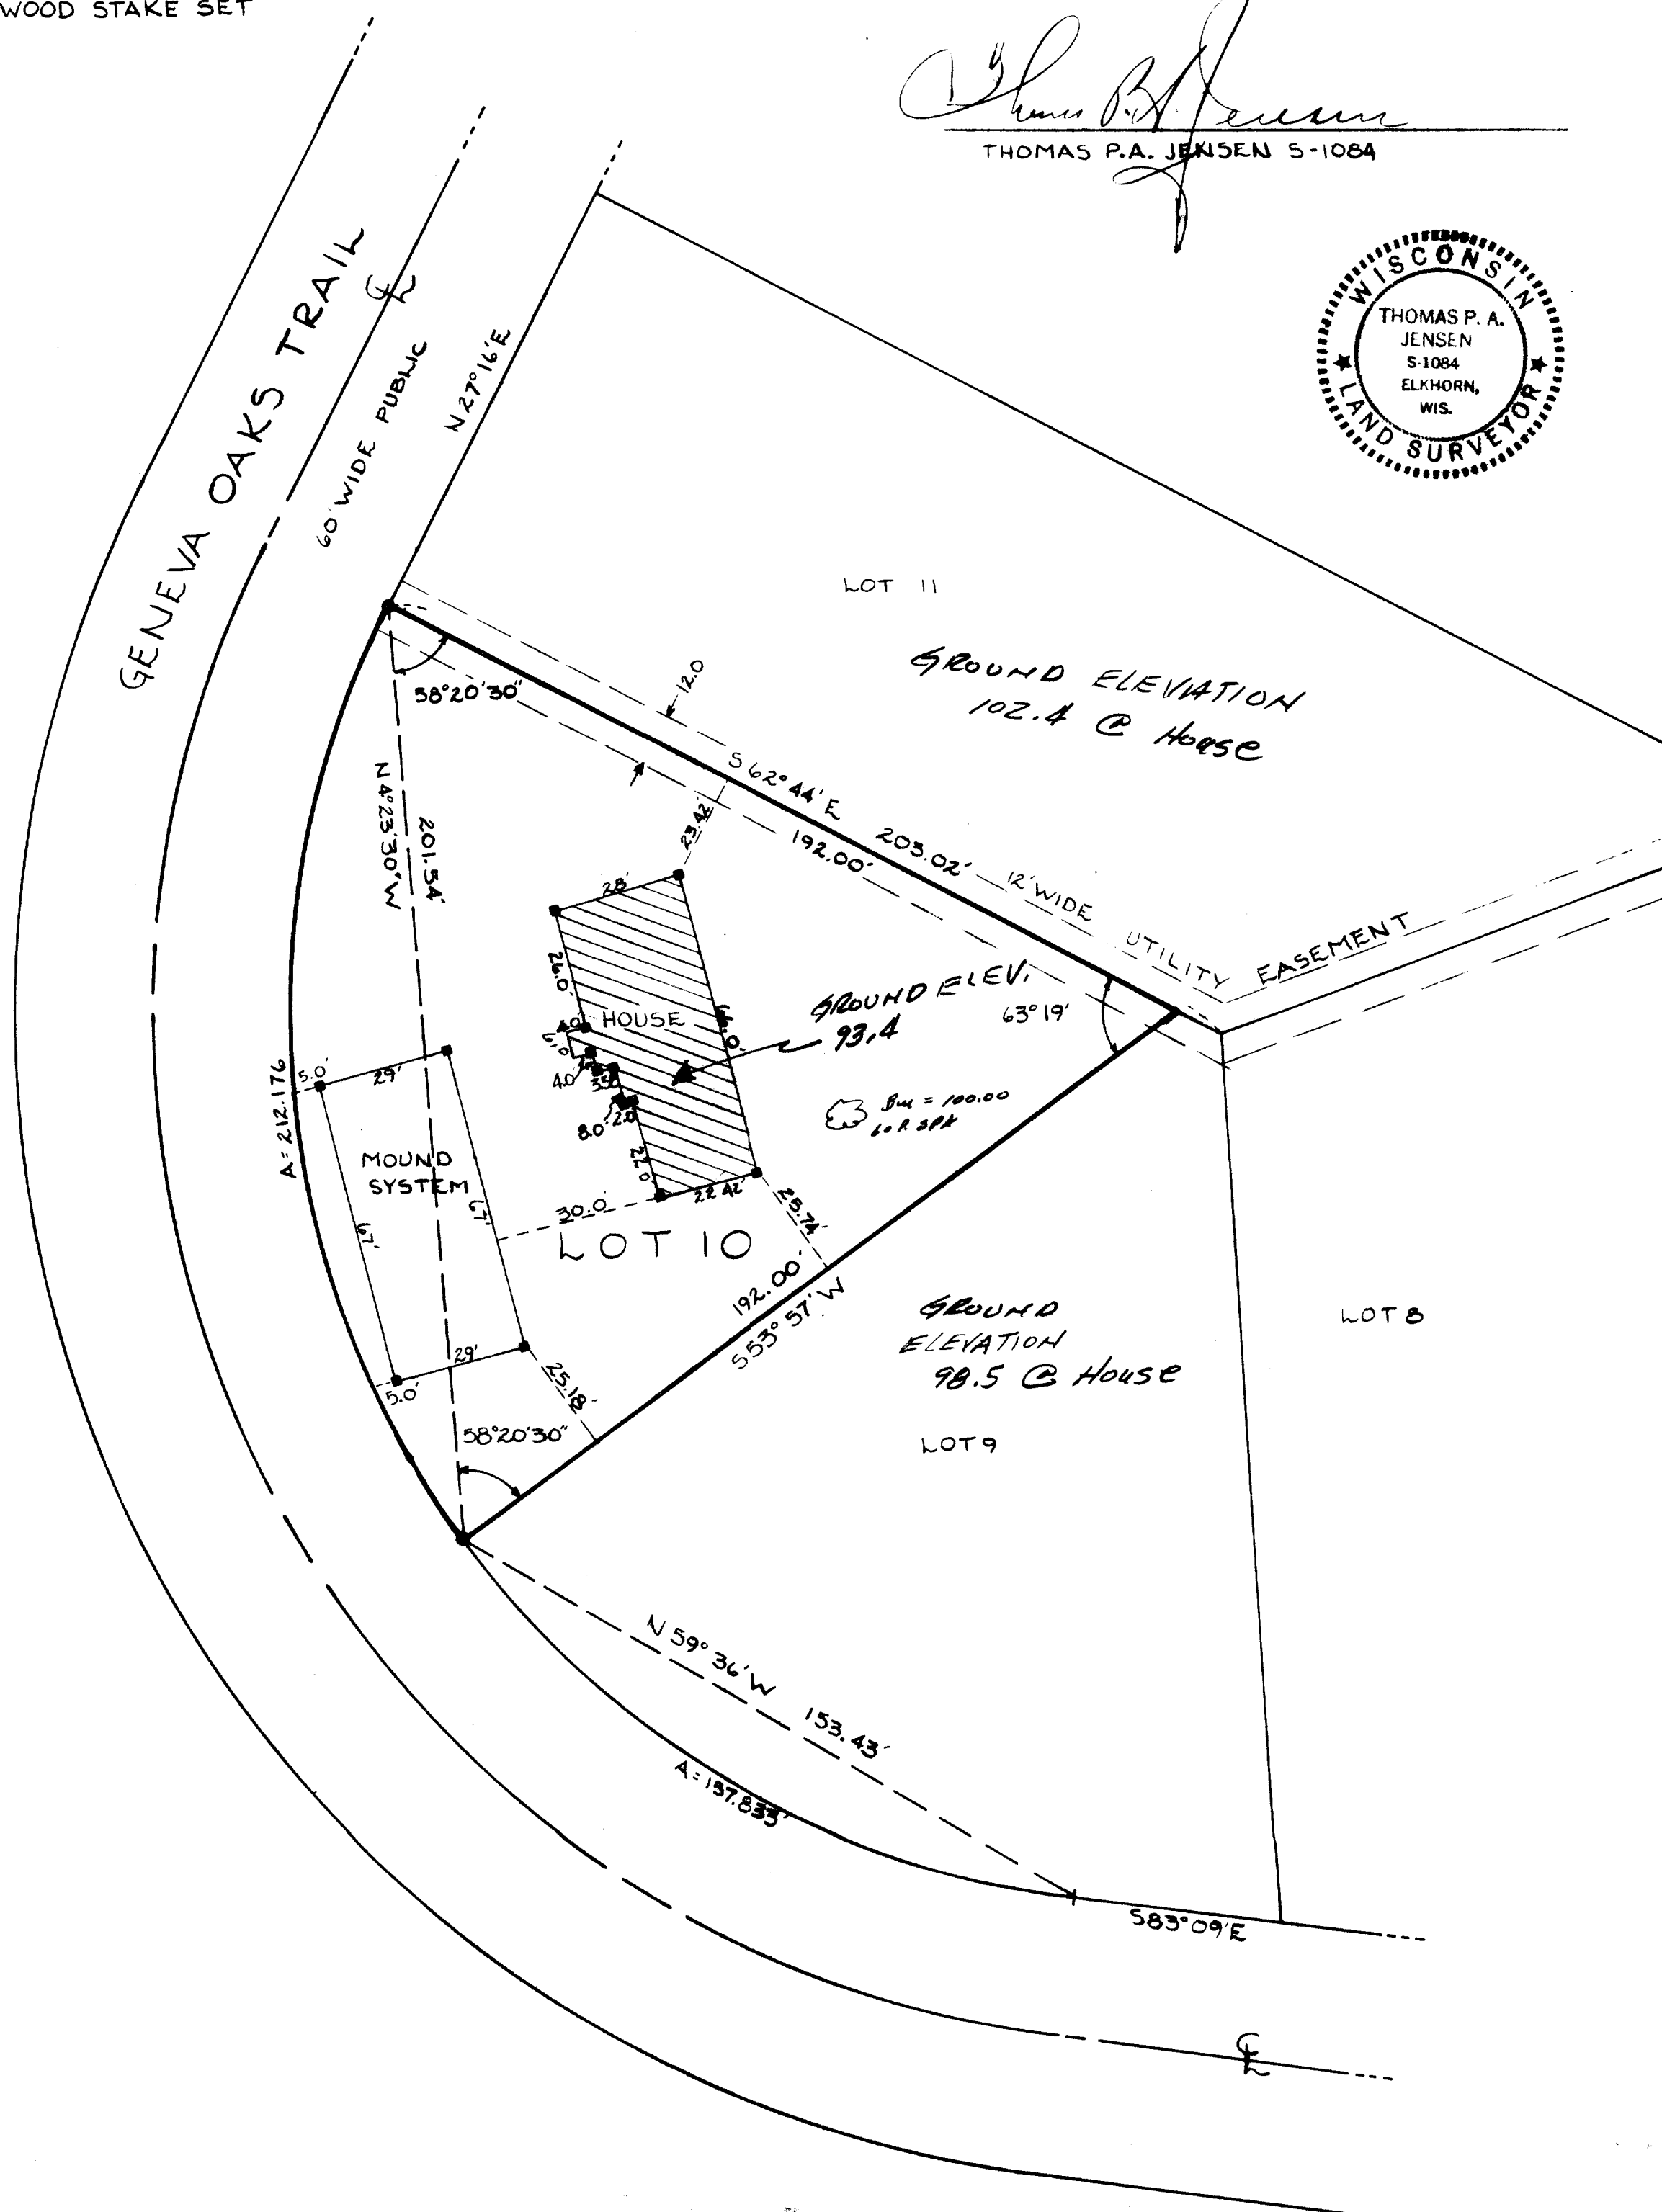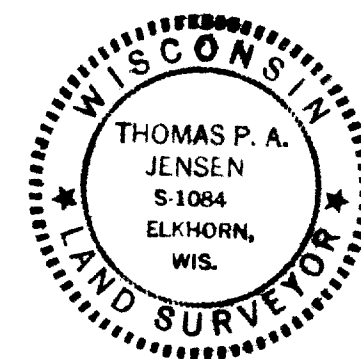

1982.053

IG0-10

117-645-J