


CORNER UNDER WATER
FOUND IRON PIPE BENT
SET 60 PENNY SPIKE AT
CORNER.

PLAT OF SURVEY OF



LOT 7, BLOCK 1, ~~TRINKE~~ ESTATES LOCATED
IN TOWNSHIP 1 NORTH, RANGE 17 EAST,
WALWORTH COUNTY, WISCONSIN.

ORDERED BY: MRS. MORTAN EINSTEIN
3625 BERNAY DRIVE
NORTHBROOK, IL. 60062

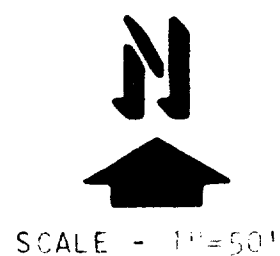

LEGEND

- o - IRON PIPE FOUND
- o - IRON PIPE SET
- - IRON ROD FOUND
- () - RECORDED TO

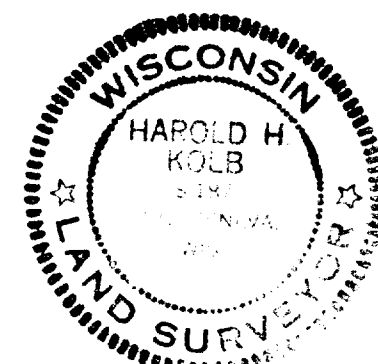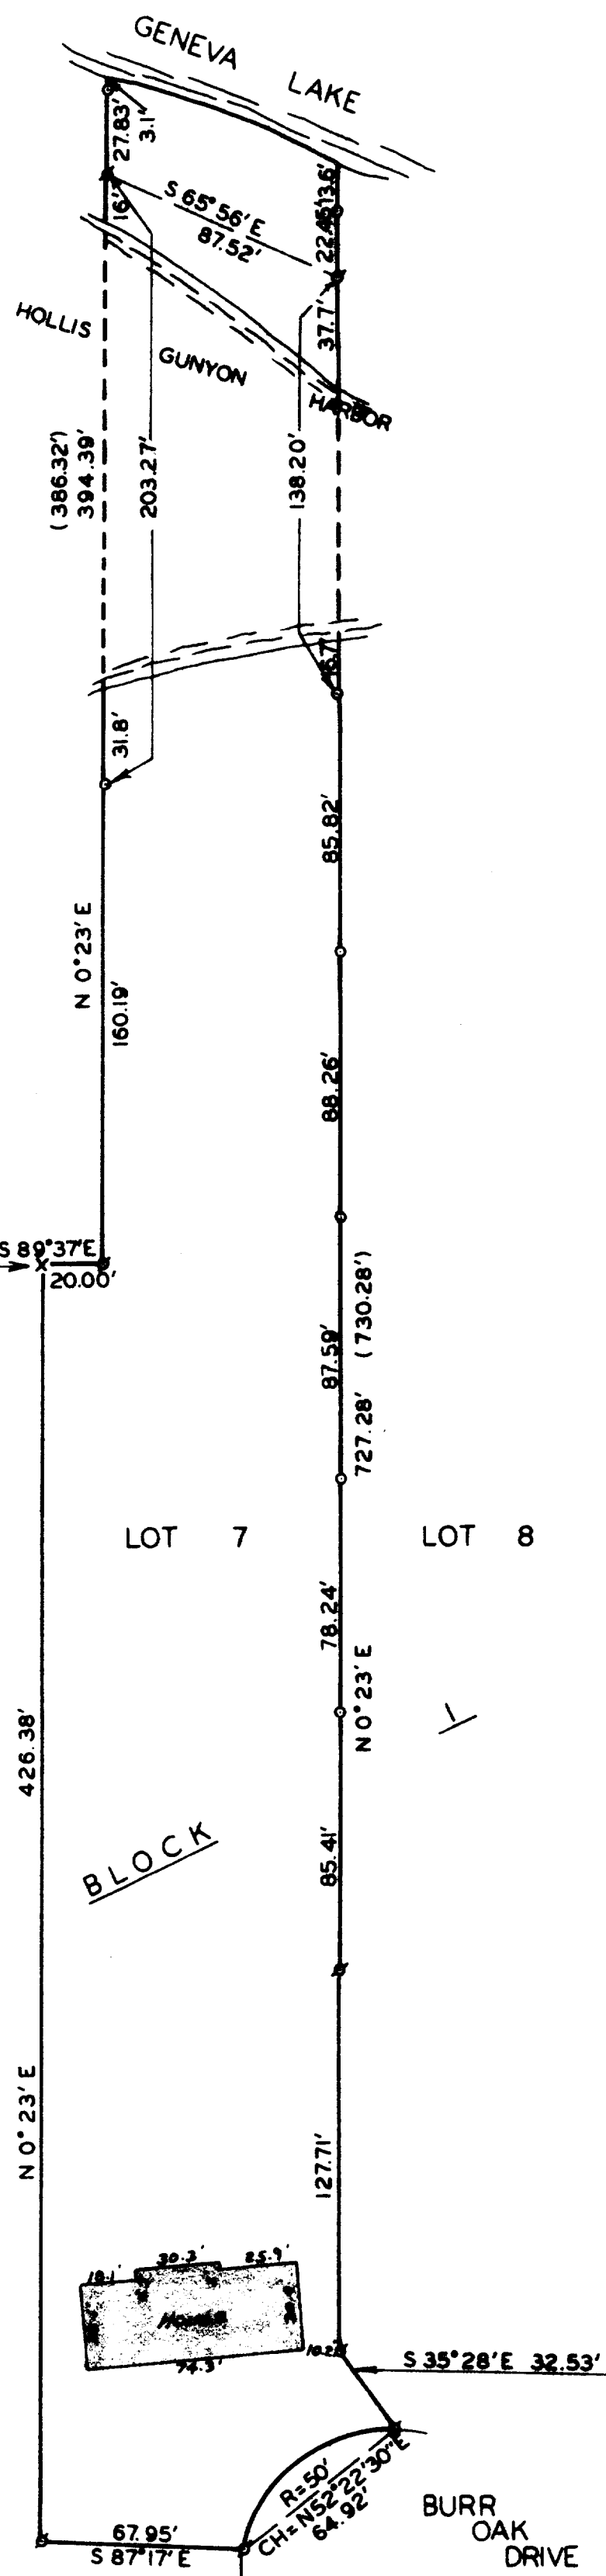

I, HAROLD H. KOLB, DO HEREBY CERTIFY THAT
I HAVE SURVEYED THE PROPERTY HEREON DE-
SCRIBED ACCORDING TO THE OFFICIAL RECORDS,
AND THAT THE PLAT HEREON IS A CORRECT
REPRESENTATION OF THE LOT LINES TO THE
BEST OF MY KNOWLEDGE AND BELIEF.

Harold H. Kolb

HAROLD H. KOLB
WISCONSIN REGISTERED LAND SURVEYOR, S-187

DATE March, 19, 1979

REVISED: AUGUST 15, 1979