


ENGINEERING, SURVEYING AND LAND PLANNING
715 W. WALWORTH ST. - P.O. BOX 487 - ELKHORN, WI 53121
OFFICE: 414/723-2098

(XXXX) = RECORD DIMENSION - SEE PREVIOUS SURVEY
THIS LOT BY 5-187 DATED 5-23-62
REC. AT CSR #117124

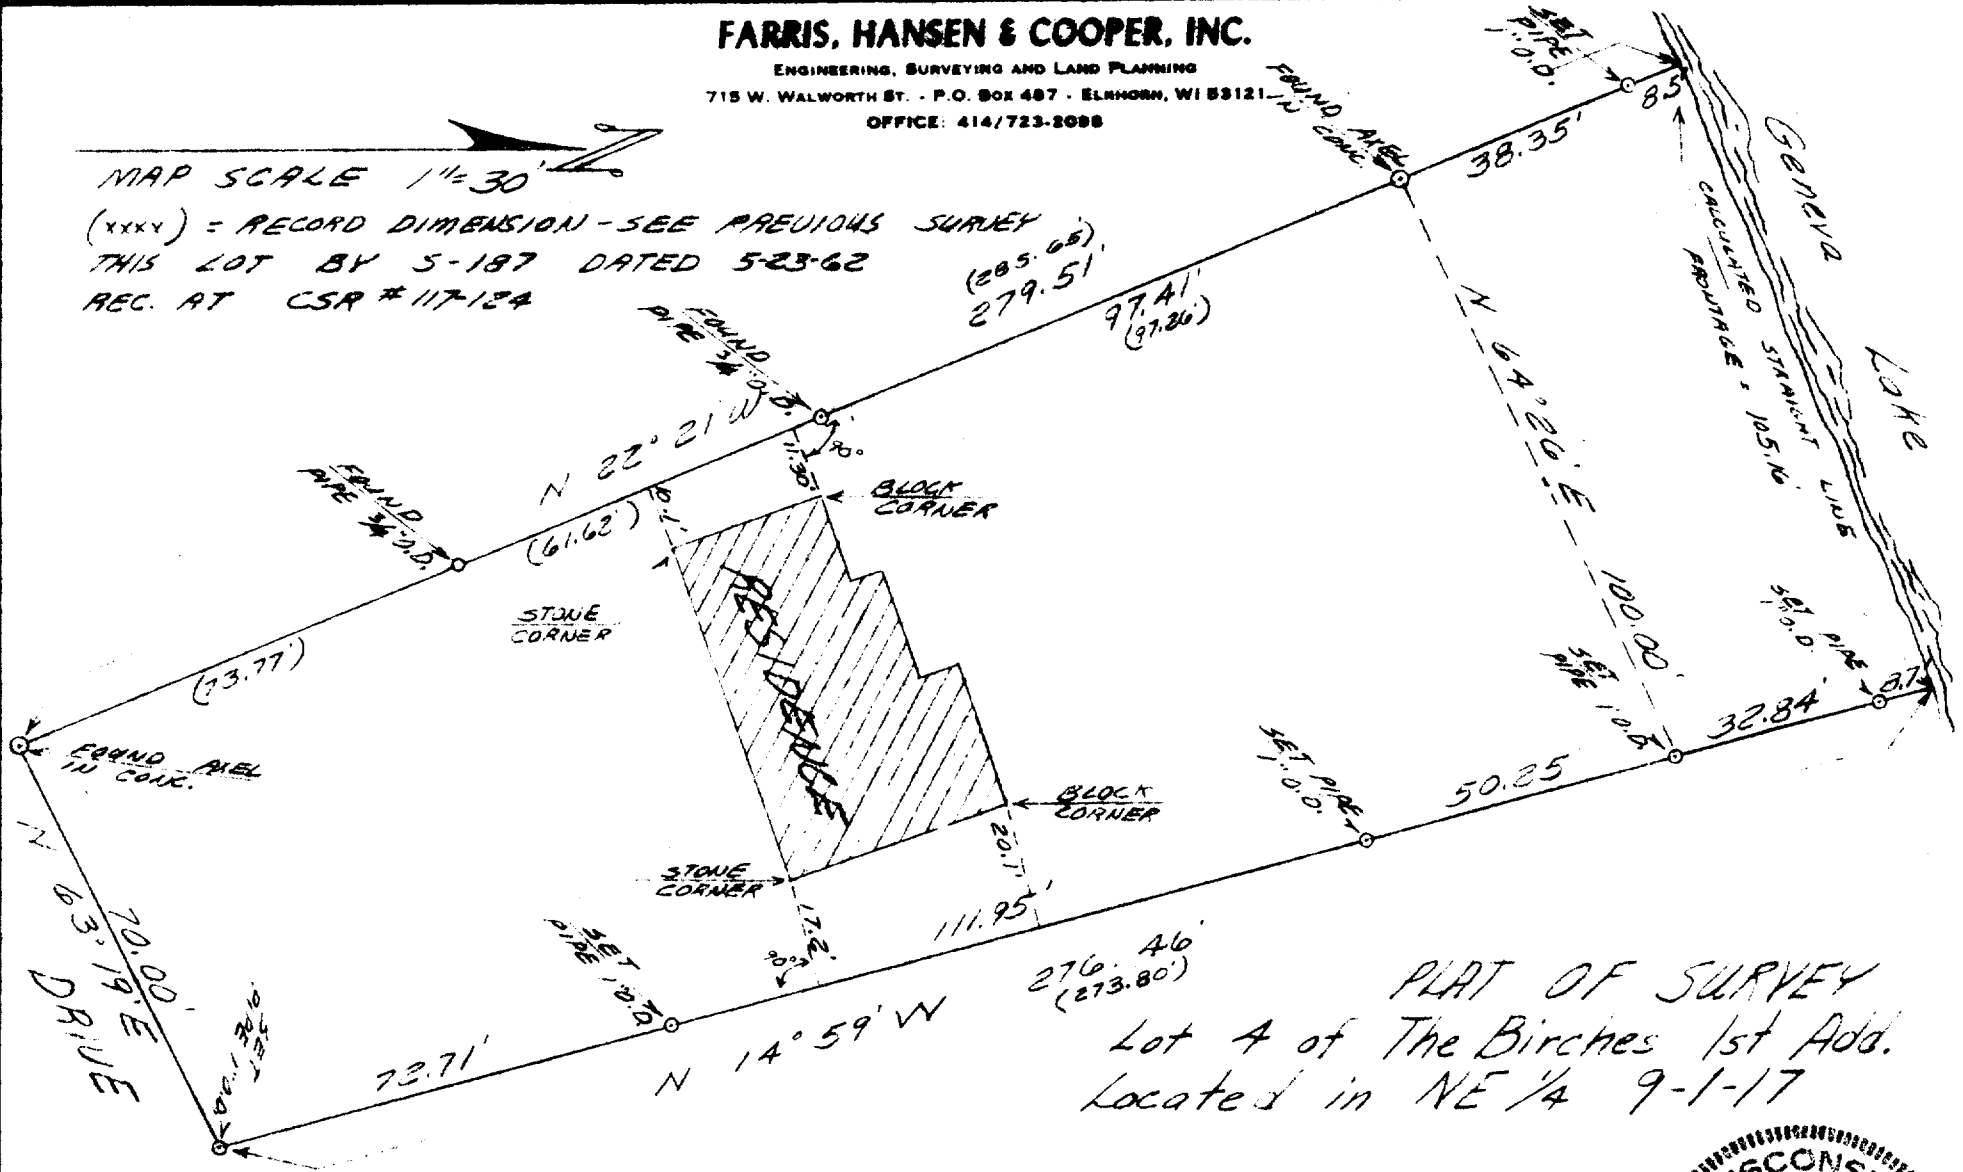

PLAT OF SURVEY
Lot 4 of The Birches 1st Add.
Located in NE 1/4 9-1-17

I HEREBY CERTIFY THAT, AT THE DIRECTION OF HARRY HOSTETLER, I HAVE SURVEYED THE PROPERTY DESCRIBED HEREON AND THAT THIS PLAT OF SURVEY IS A TRUE AND ACCURATE REPRESENTATION OF THE LOT LINES AND OF THE BUILDING CORNERS TO THE BEST OF MY PROFESSIONAL KNOWLEDGE AND BELIEF



15 JUNE 1982

DRAWING NUMBER 1968

117-651-F