


DUNHAM SURVEYING, S.C.
SURVEYING & SUBDIVIDING
DELAVER, WISCONSIN 53115

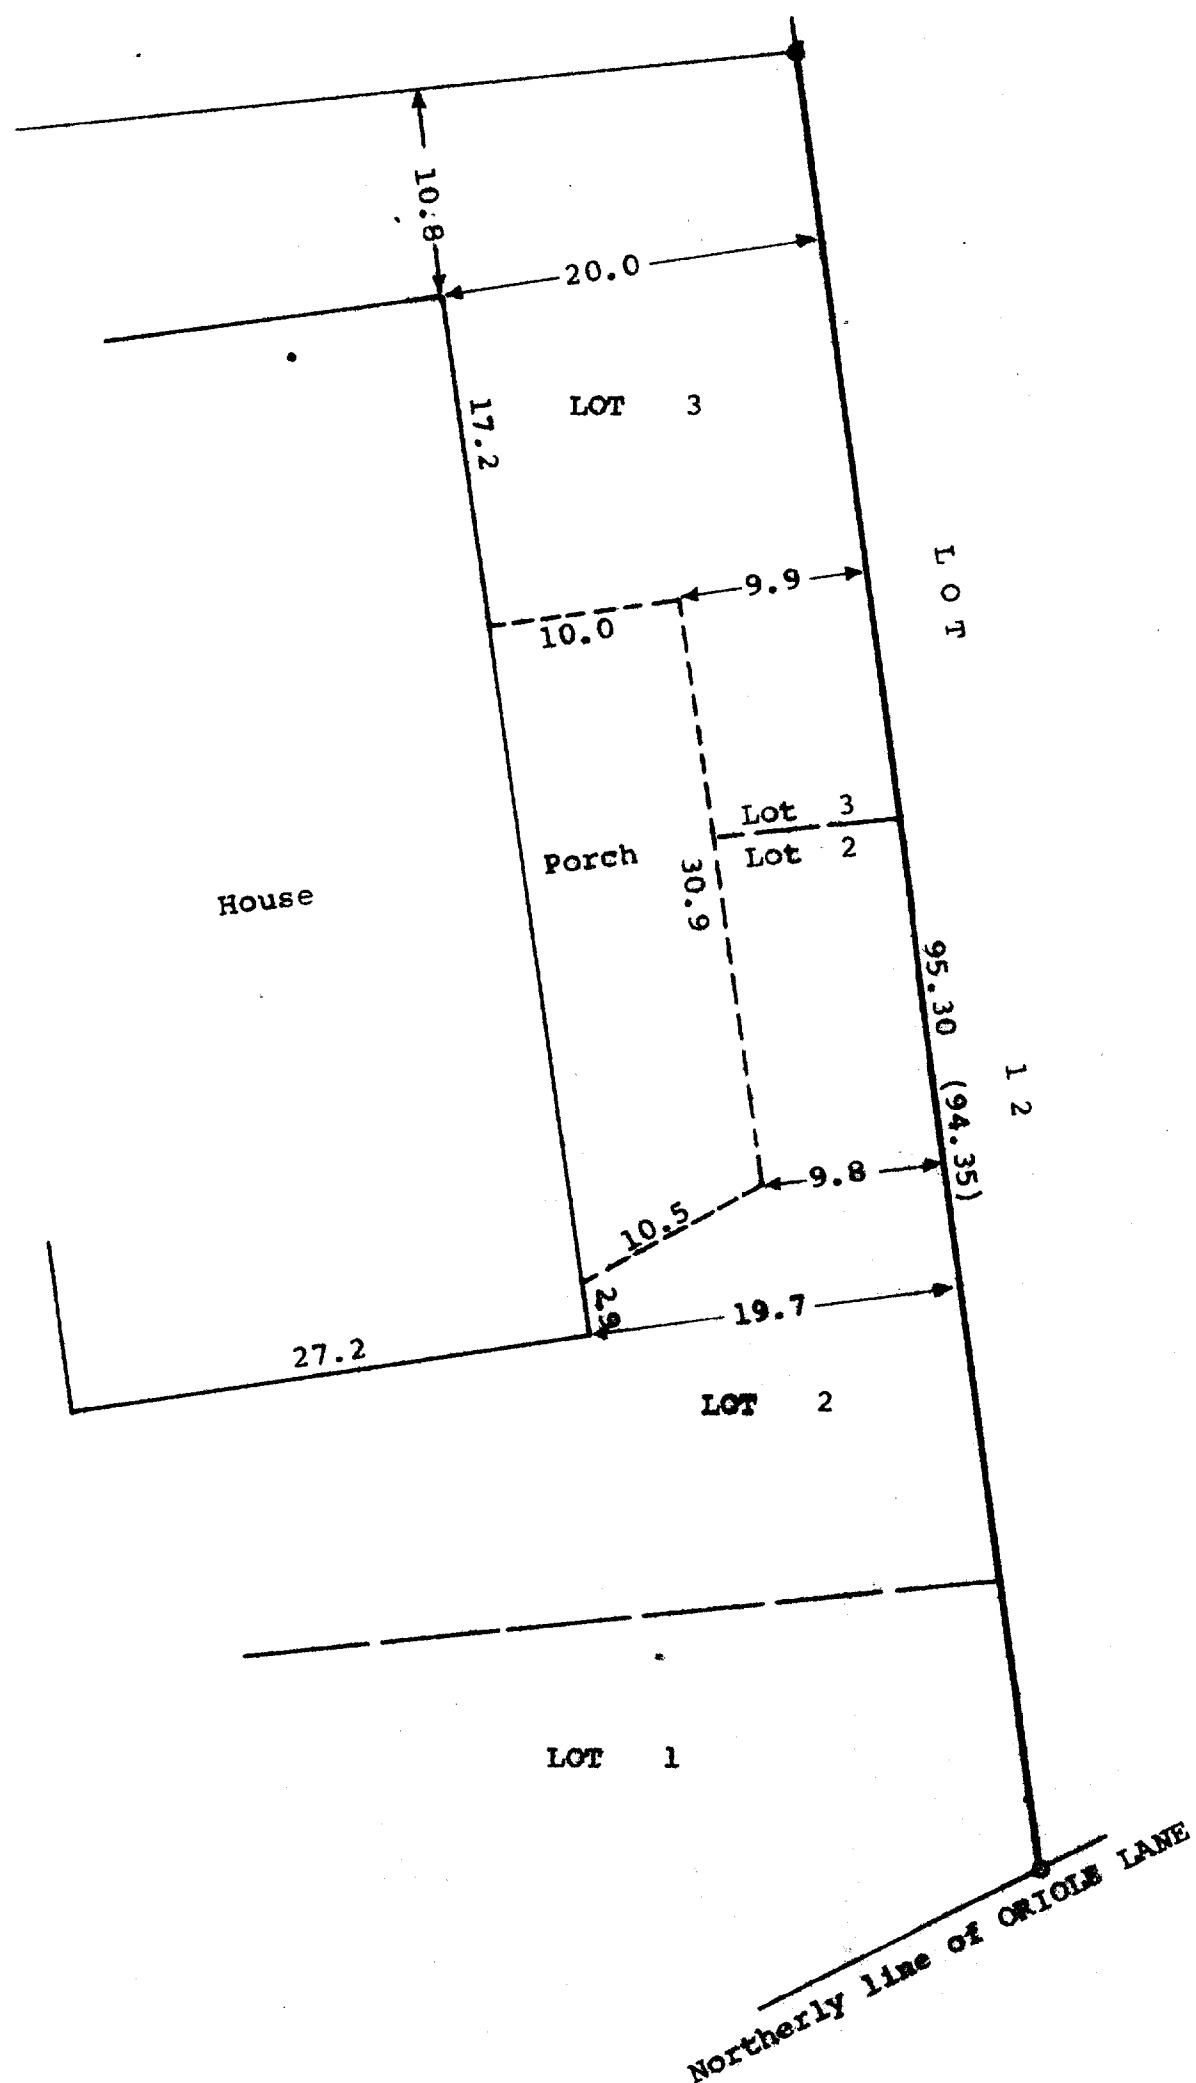

N

Scale - 1" = 10'
● = Concrete Monument Found
○ = Iron Pipe Found
(0.00) = Recorded As

Plat of a survey of:
The East line of Lots 1, 2, 3, Block Lettered "E" in
Cisco Beach, being a subdivision located in Section 5,
T1N, R17E, Town of Lian, Walworth County, Wisconsin.
October 8, 1981.

James M. Dunham
James M. Dunham, Surveyor

