


BKG. REF THIS PLAT - W. LINE LOT 3 - N 0° 23' E AS RECORDED
N 0° 23' E 197.70' (197.50')

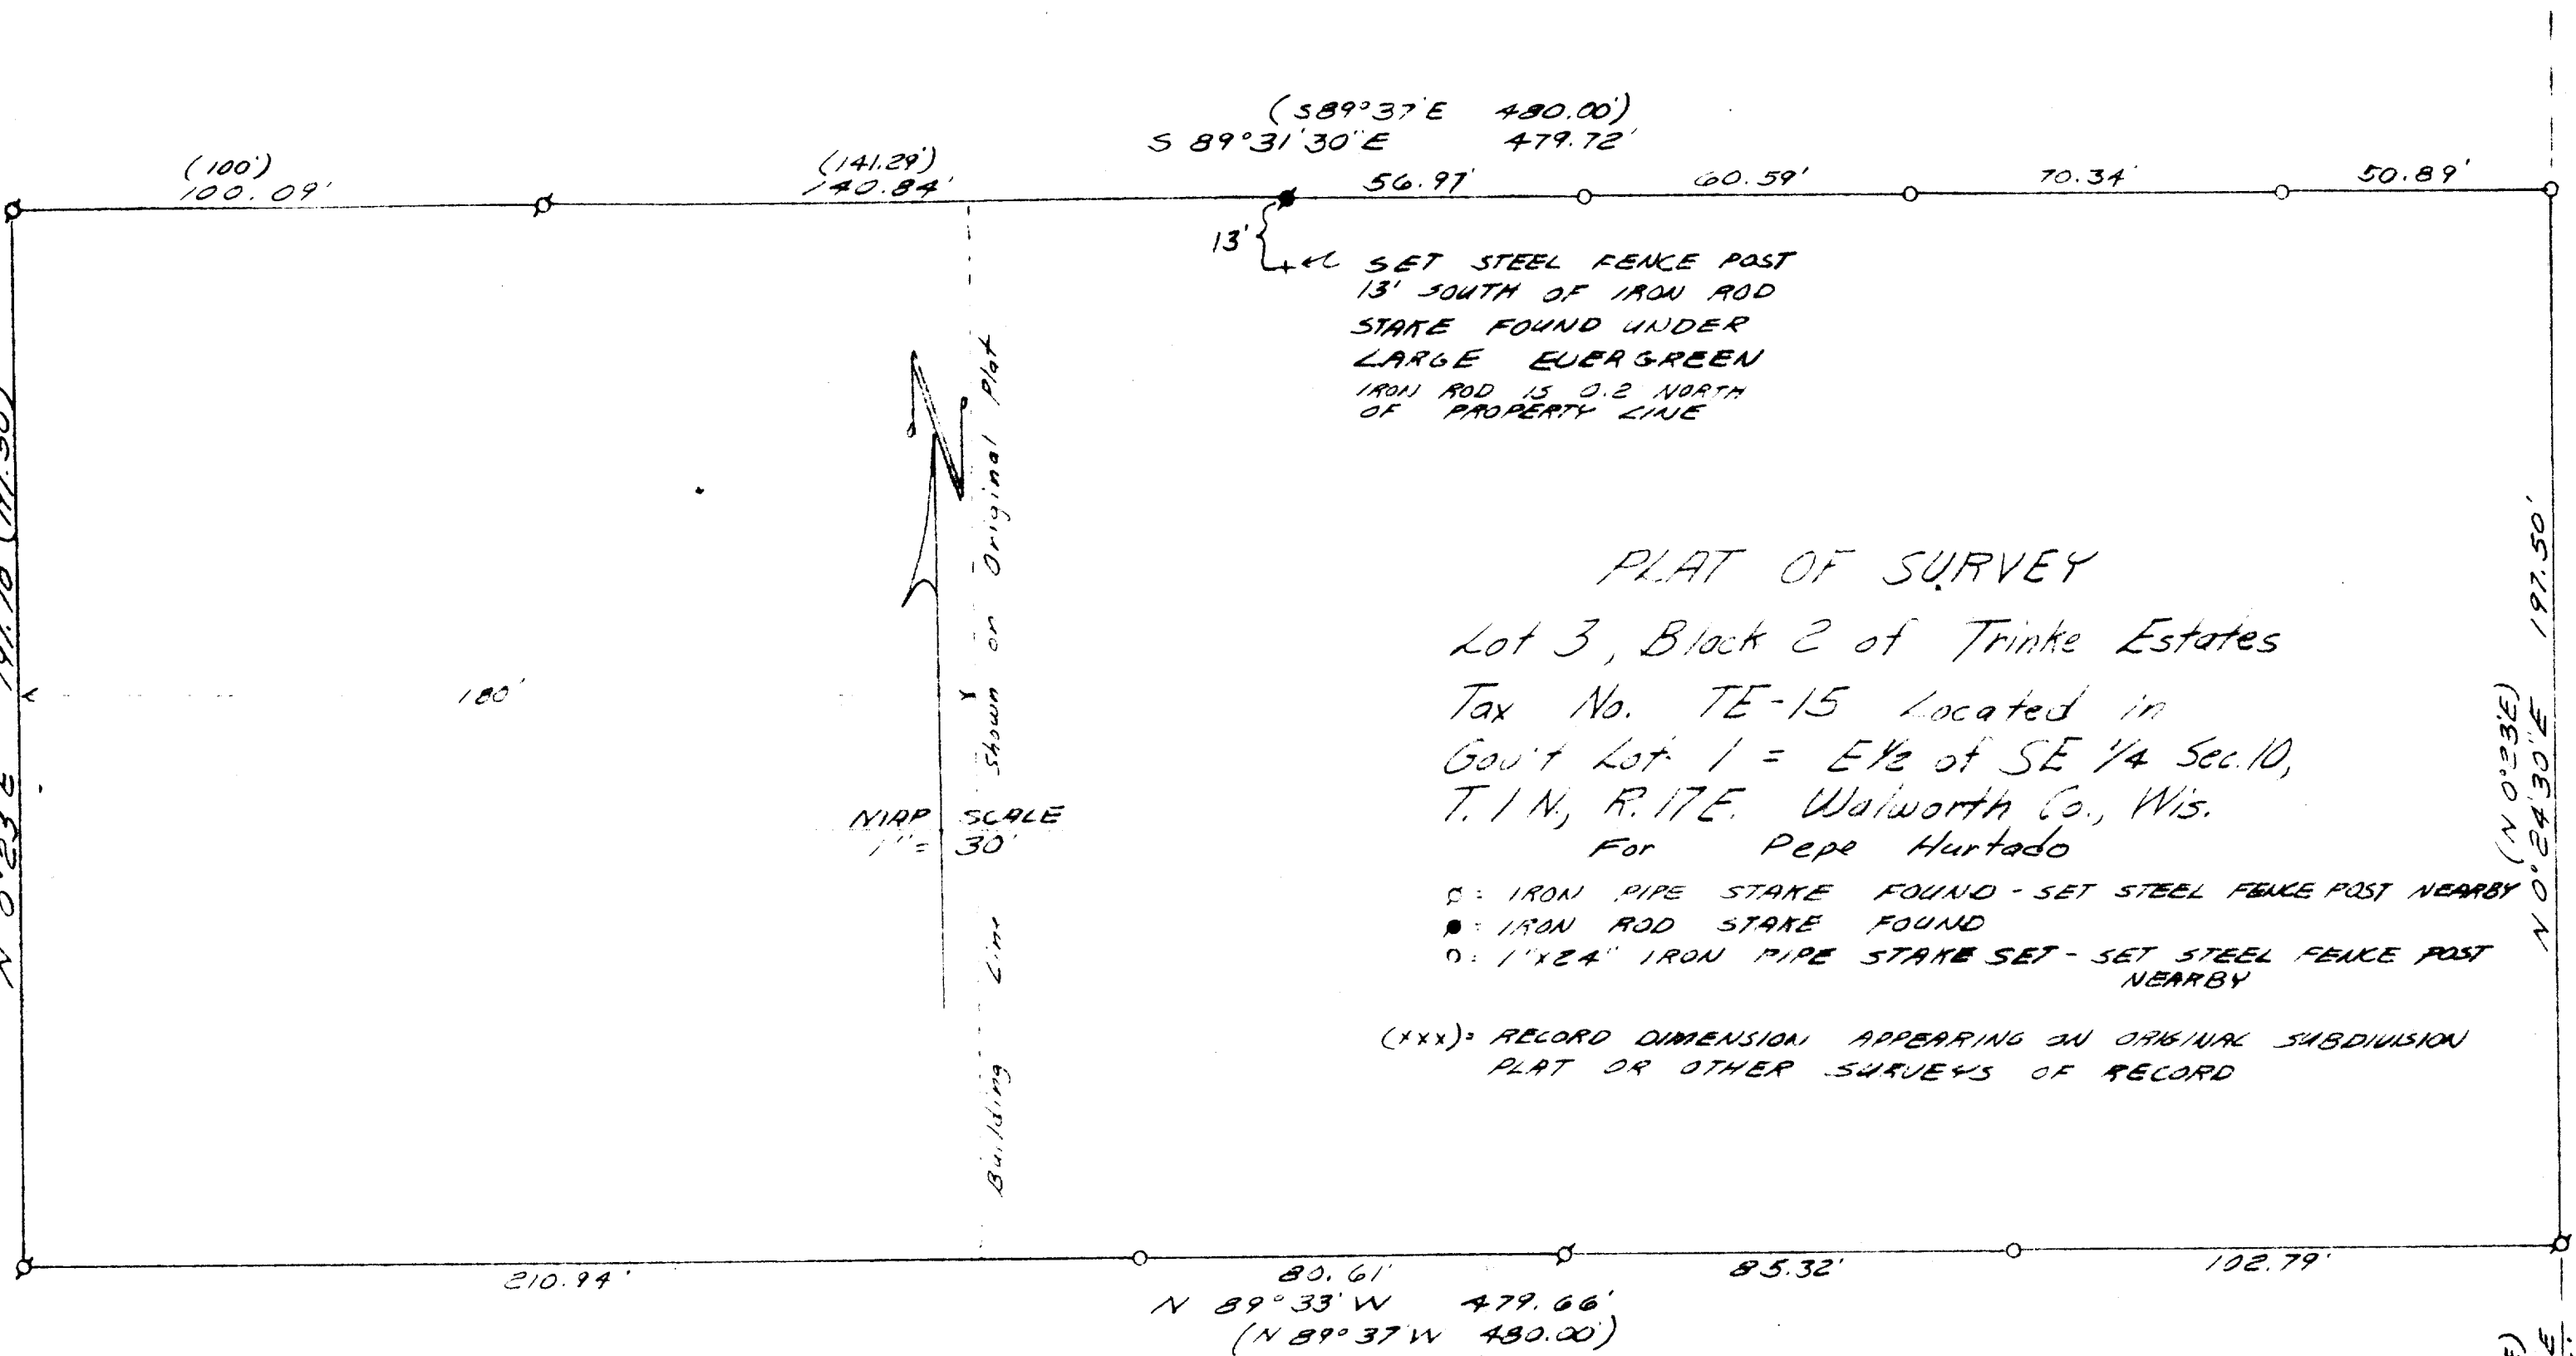

PLAT OF SURVEY
Lot 3, Block 2 of Trinke Estates
Tax No. TE-15 Located in
Gov't Lot 1 = E 1/2 of SE 1/4 Sec. 10,
T. 1 N., R. 17 E. Walworth Co., Wis.
For Pepe Hurtado


- = IRON PIPE STAKE FOUND - SET STEEL FENCE POST NEARBY
- = IRON ROD STAKE FOUND
- = 1" X 24" IRON PIPE STAKE SET - SET STEEL FENCE POST NEARBY

(xxx) = RECORD DIMENSION APPEARING ON ORIGINAL SUBDIVISION
PLAT OR OTHER SURVEYS OF RECORD

I HEREBY CERTIFY THAT THIS LOT HAS BEEN SURVEYED
UNDER MY DIRECTION AND THAT THIS PLAT IS A
TRUE & ACCURATE REPRESENTATION OF THE LOT LINES
TO THE BEST OF MY PROFESSIONAL KNOWLEDGE
AND BELIEF.

DATED THIS 15TH DAY OF JULY, 1983

Robert A. Farris

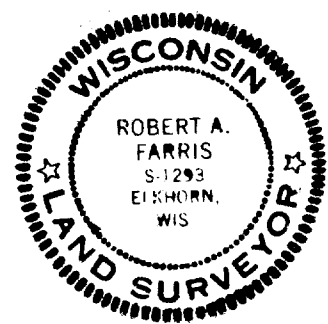

FARRIS, HANSEN & ASSOCIATES, INC.
715 W. Walworth St. P.O. Box 487
Elkhorn, WI 53121

117-653-F
Project No. 2005