


FARRIS, FARRIS & SONS, INC.


Land Surveyors, Wisconsin
712 W. Wisconsin St. - P.O. Box 107 - Elkhorn, WI 53121
Office: 614/783-2800

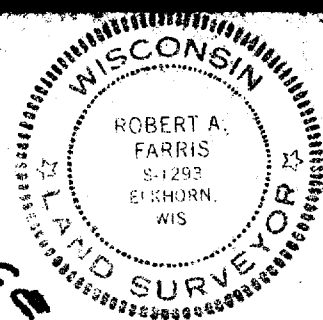

PLAT OF SURVEY OF LOTS 5, 6, AND PART
OF LOT 7 OF BLOCK F OF CISCO BEACH,
WALWORTH COUNTY, WISCONSIN AS RECORDED IN
WARRANTY DEED DGC. NO 40523, VOL 222/PG 603
OF WALWORTH COUNTY RECORDS

MAP SCALE
1" = 20'

Work Ordered By:
Bette C. Costello

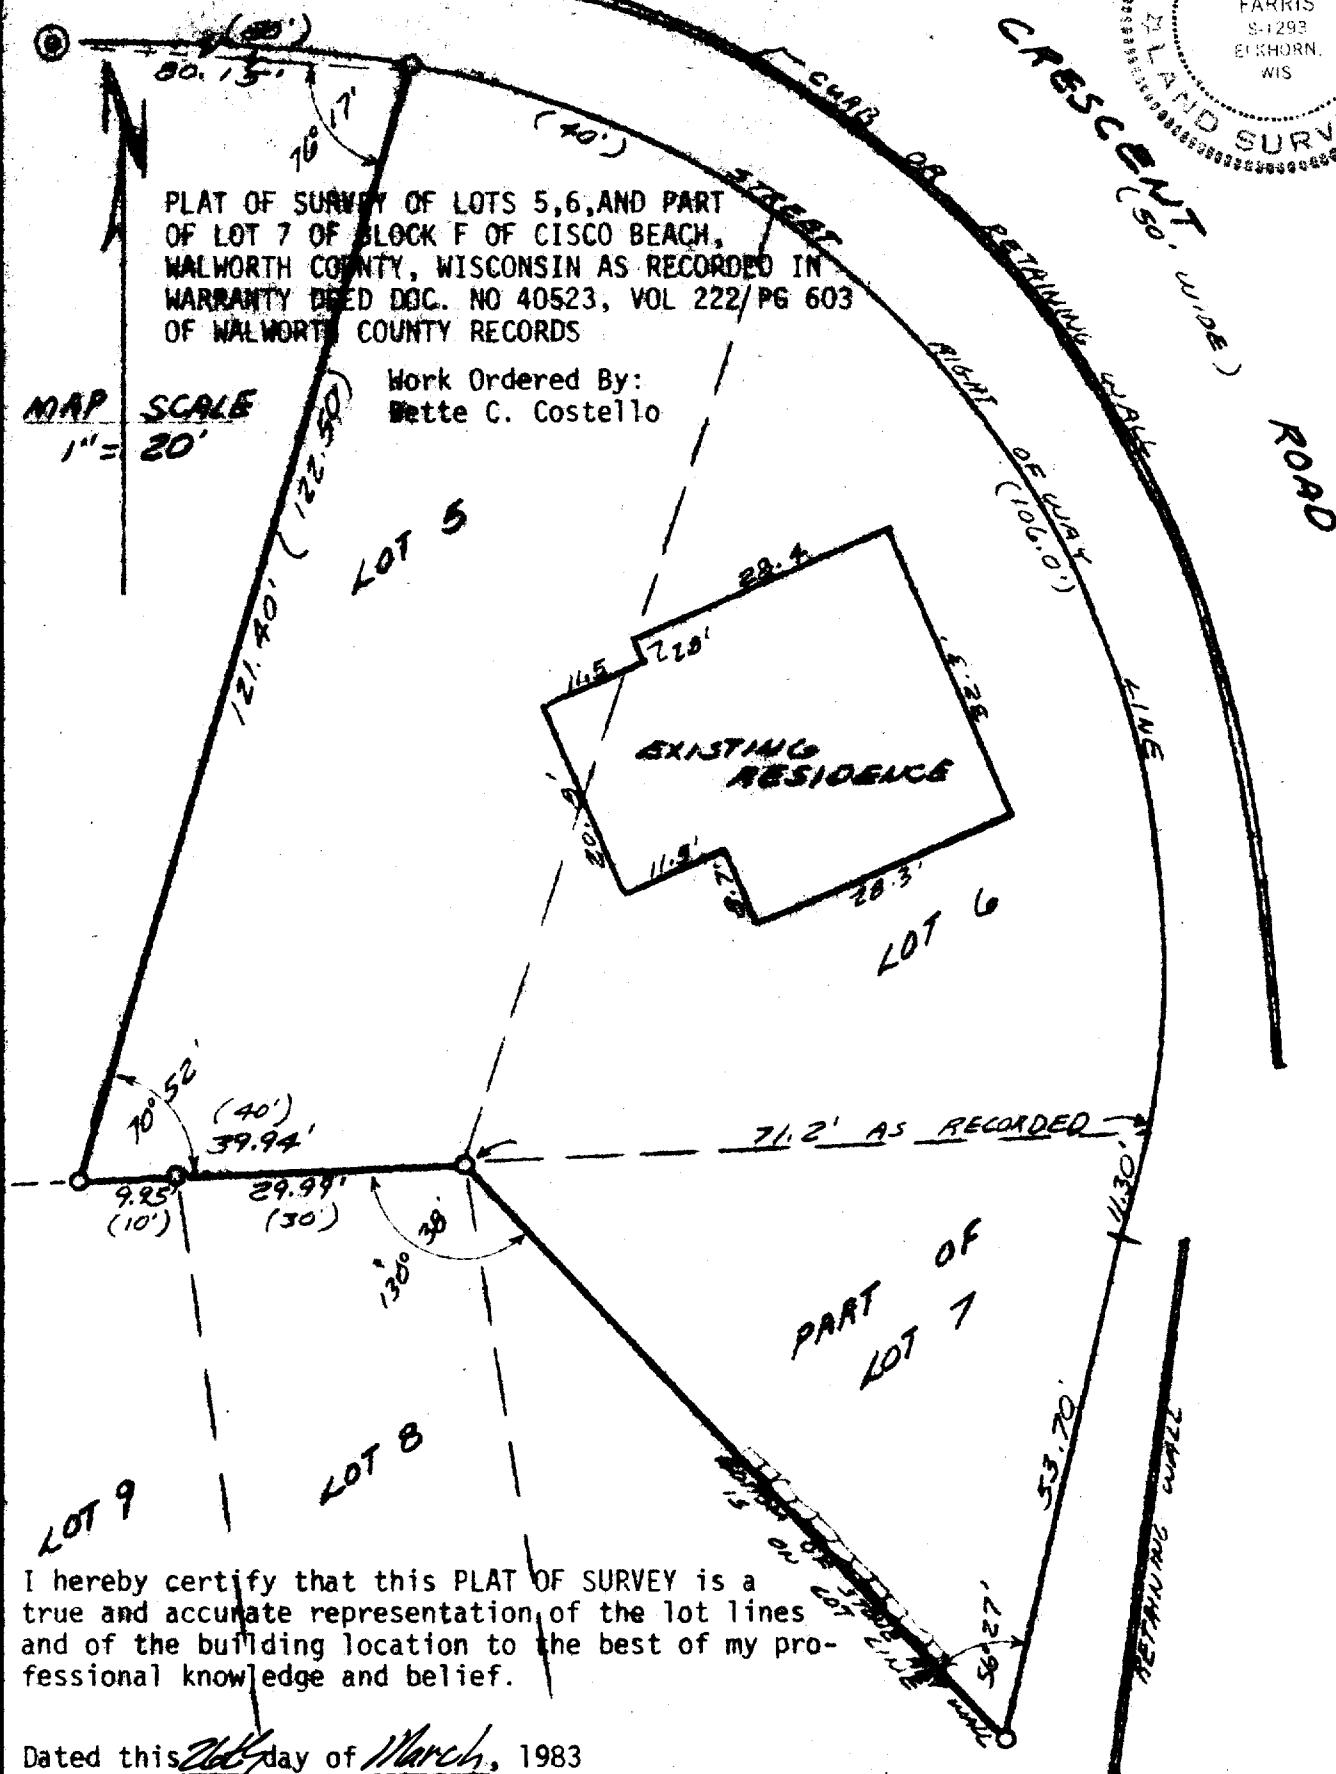

(xxx) = Deed or record plat dimension
○ = Iron pipe survey stake found
◎ = Concrete survey monument found

I hereby certify that this PLAT OF SURVEY is a
true and accurate representation of the lot lines
and of the building location to the best of my pro-
fessional knowledge and belief.

Dated this 26th day of March, 1983

Robert A. Farris

DRAWING NUMBER 2065