


GEORGE T. DUNHAM  
SURVEYING & SUBDIVIDING  
DELAVER, WISCONSIN

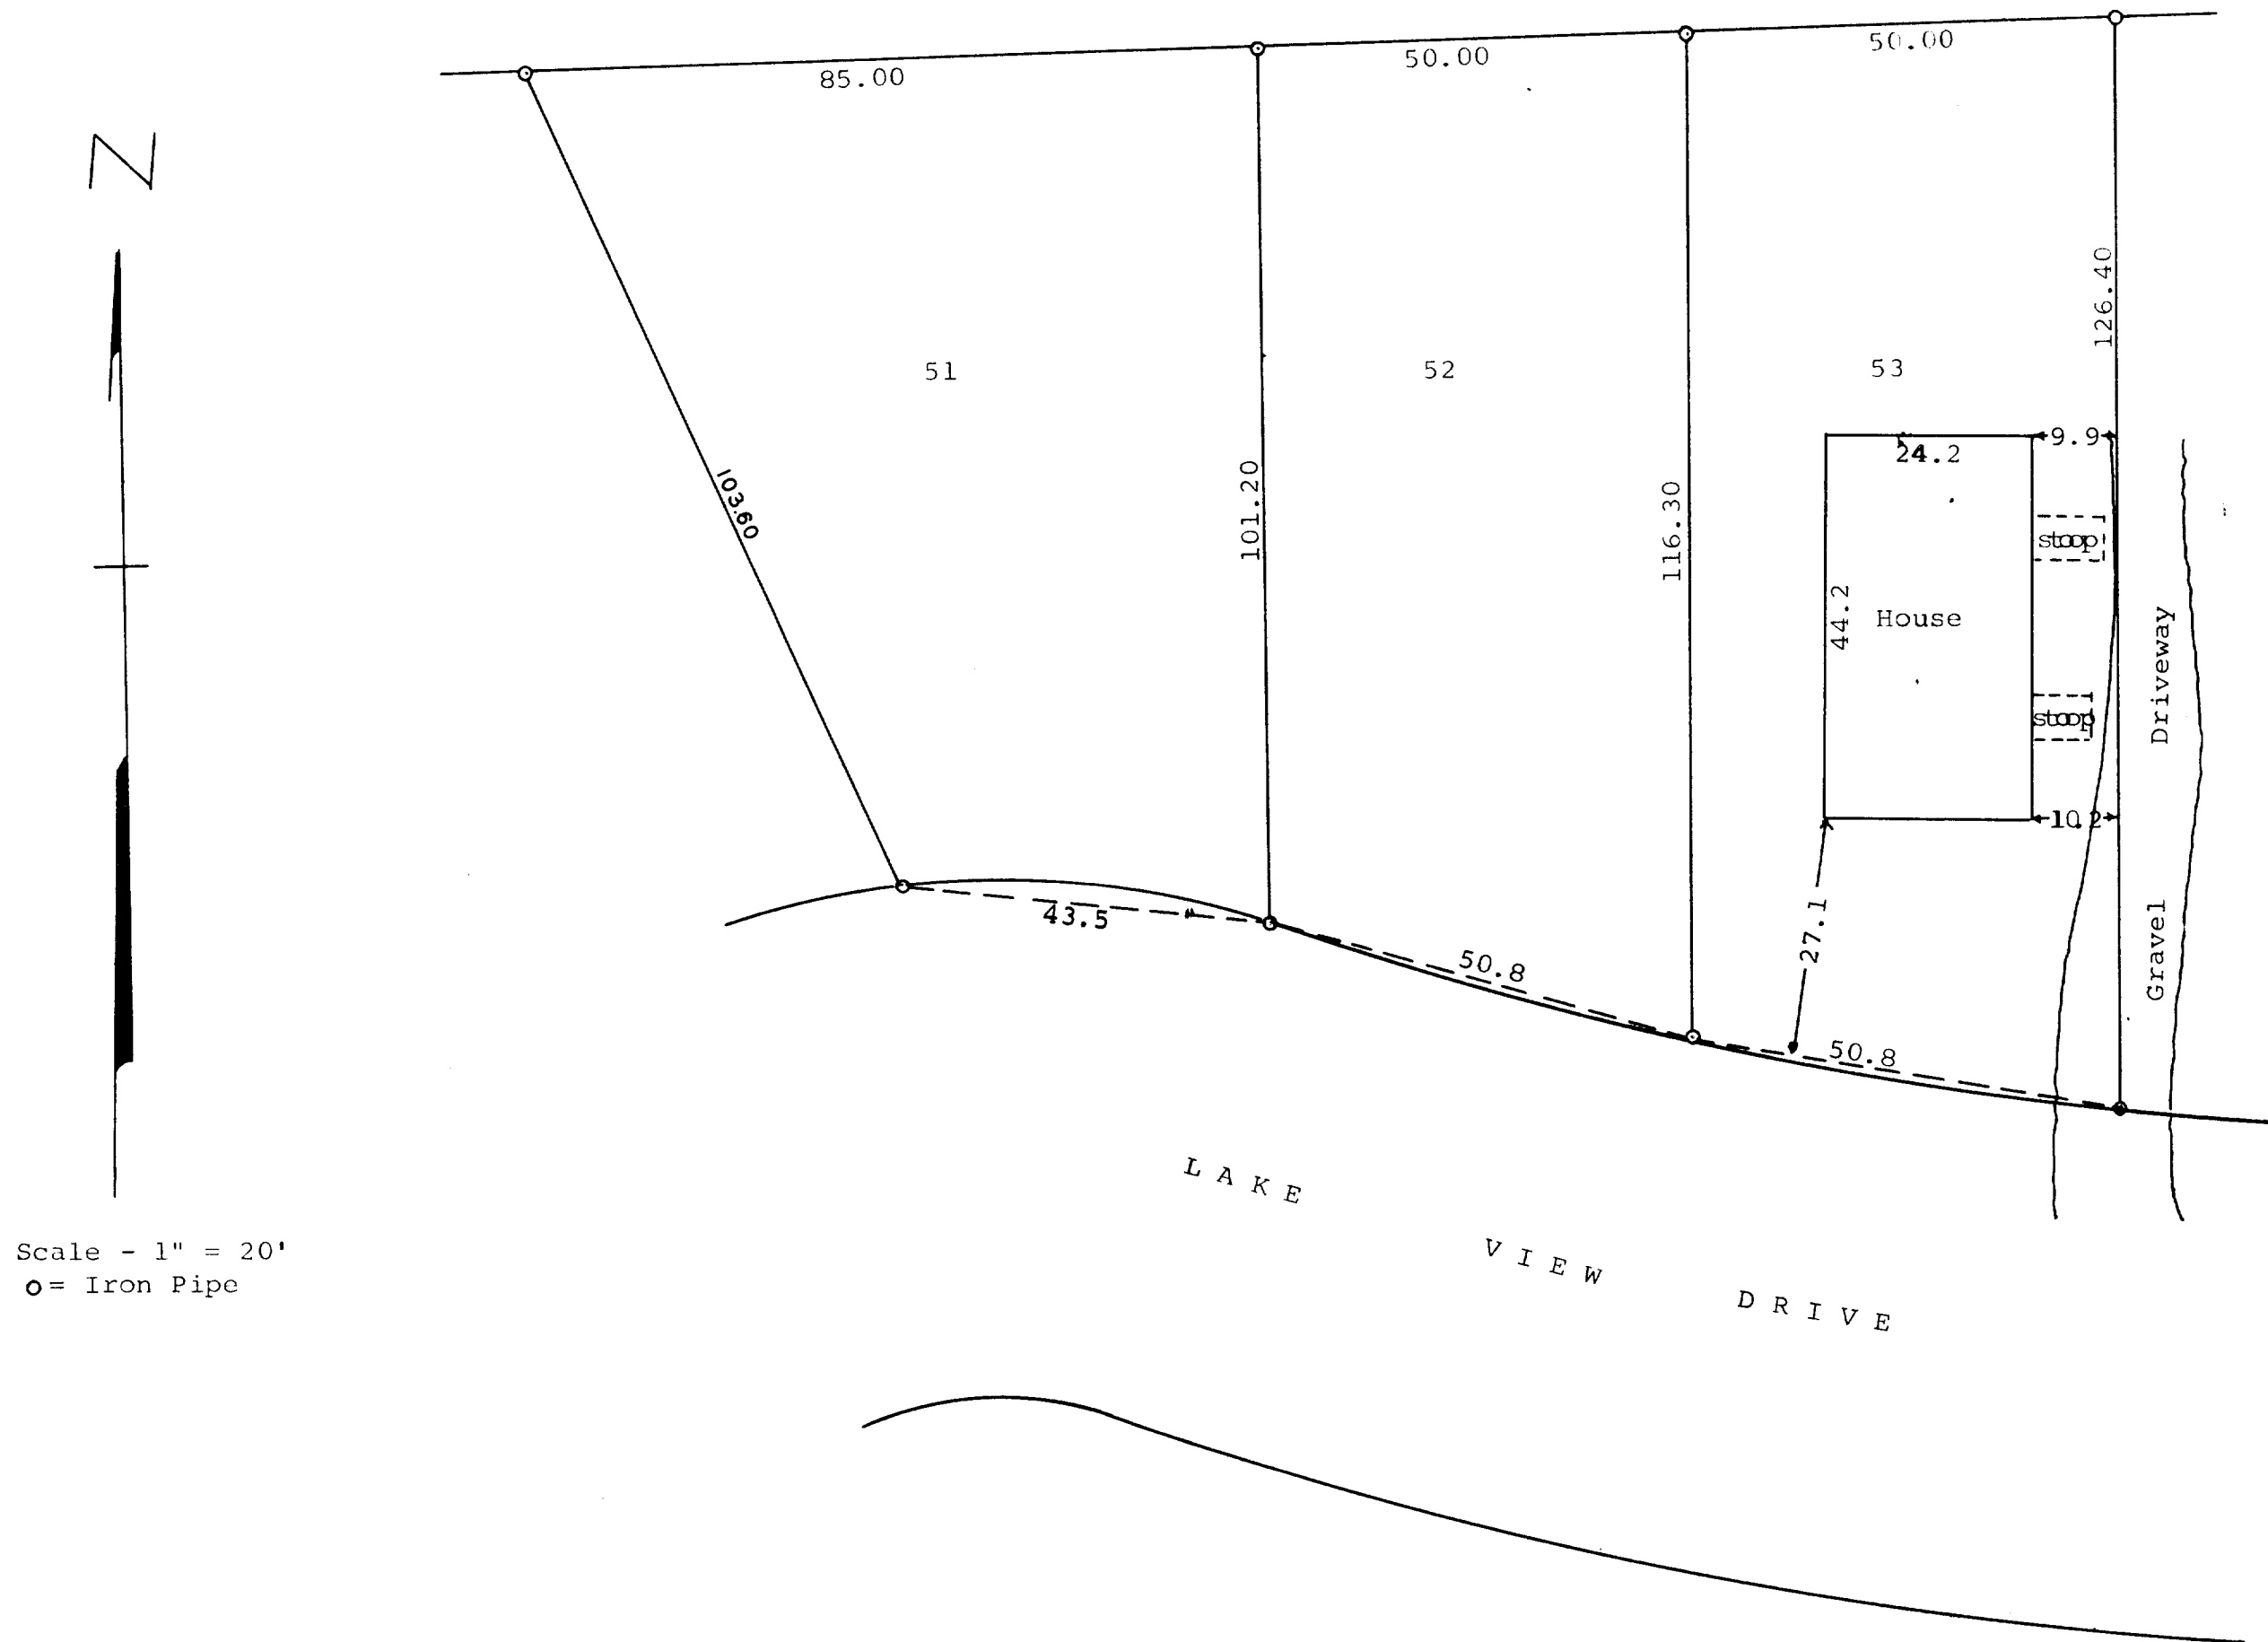

Scale - 1" = 20'  
○ = Iron Pipe

Plat of survey of Lots 51, 52, and 53 in Block 2 of Lake View Park,  
located in the Town of Linn, Walworth County, Wisconsin.  
June 27, 1967

*George T. Dunham*  
George T. Dunham, Surveyor

117-66

1VVP-80, 8D