

PLAT OF SURVEY

Lots 13, 14 and 15, The Birches Second Addition, located in Section 10, T.1N., R.17E., Walworth County, Wisconsin.


I certify that I have surveyed the above described property and that the plat shown hereon is an accurate survey and a true representation thereof and correctly shows the exterior boundary lines and all divisions of said property. The above described survey is a lot line adjustment.

Date of Survey: August 26, 1983

Thomas P.A. Jensen


THOMAS P.A. JENSEN S-1084
JENSEN SURVEYING & MAPPING
P.O. Box 322 Elk Horn, Wisconsin 53121
Phone: (414) 723-3434

Surveyed For: JOHN SONTAG
Rt. 1 Box 360
Lake Geneva, Wisconsin 53147

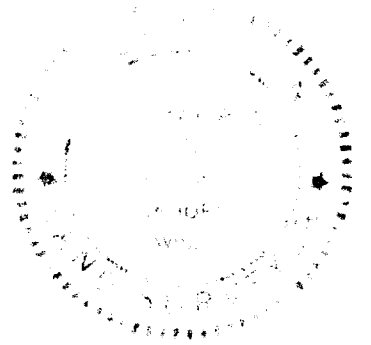

Scale: 1" = 60'

- c = Found Posey Pin
- o = Found Iron Pipe
- = Found Conc. Monument
- = Set 3/4" dia. Iron Rod

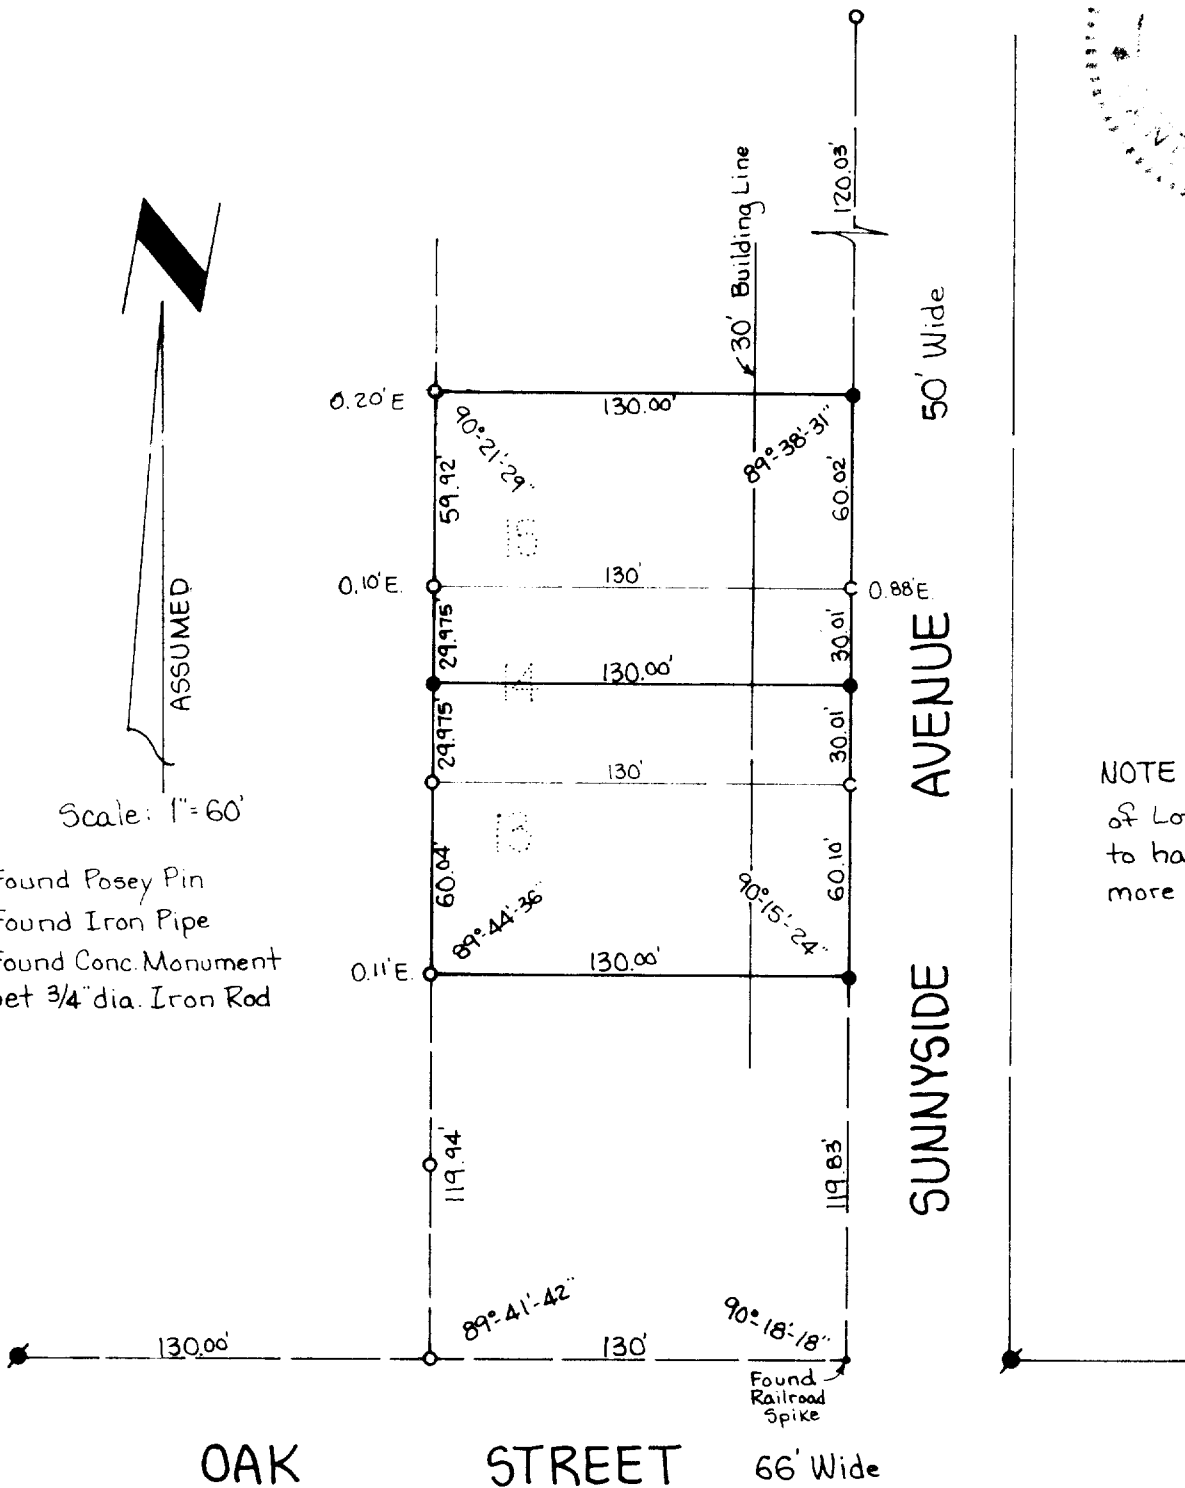

NOTE: The S.E. corner of Lot 15 appears to have been set 1 foot, more or less, too far East.