


# KOLB LAND CONSULTING, INC.

LAND SURVEYING • SUBDIVIDING • LAND PLANNING

LAKE GENEVA, WISCONSIN 53147



WHITEWATER, WISCONSIN 53190

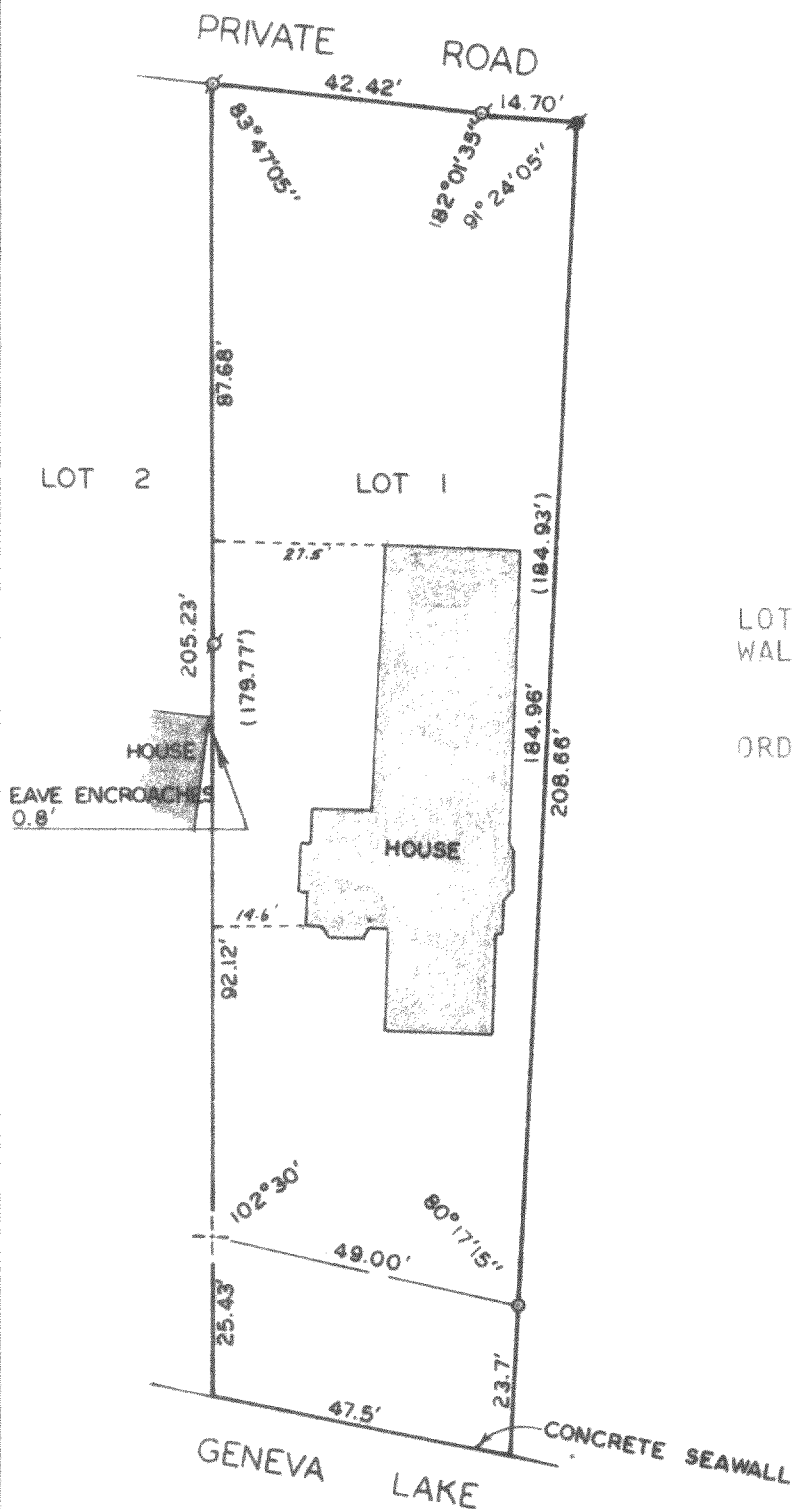

PLAT OF SURVEY OF

LOT 1, ELGIN CLUB, T1N, R17E,  
WALWORTH COUNTY, WISCONSIN.

ORDERED BY: BRUCE A. POPE  
PIER 107 ELGIN CLUB  
LAKE GENEVA, WI 53147

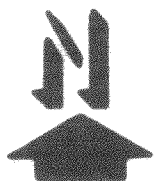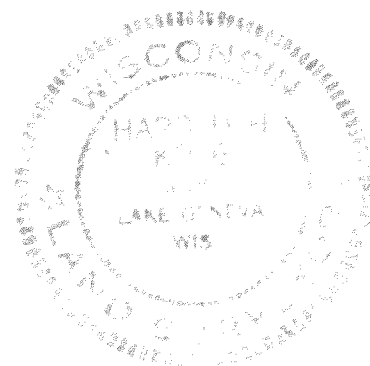

SCALE - 1"=30'

## LEGEND

- ⊙ - IRON PIPE FOUND
- - IRON PIPE SET
- + - CUT CROSS IN CONCRETE FOUND
- ( ) - RECORDED AS
- - CONCRETE MONUMENT FOUND

I, HAROLD H. KOLB, DO HEREBY CERTIFY  
THAT I HAVE SURVEYED THE PROPERTY  
HEREON DESCRIBED ACCORDING TO THE  
OFFICIAL RECORDS, AND THAT THE PLAT  
HEREON IS A CORRECT REPRESENTATION  
OF THE LOT LINES TO THE BEST OF MY  
KNOWLEDGE AND BELIEF.

*Harold H. Kolb*  
HAROLD H. KOLB  
WISCONSIN REGISTERED LAND SURVEYOR, S-187  
DATE NOV. 4, 1983

117-669-K

1EC-1