


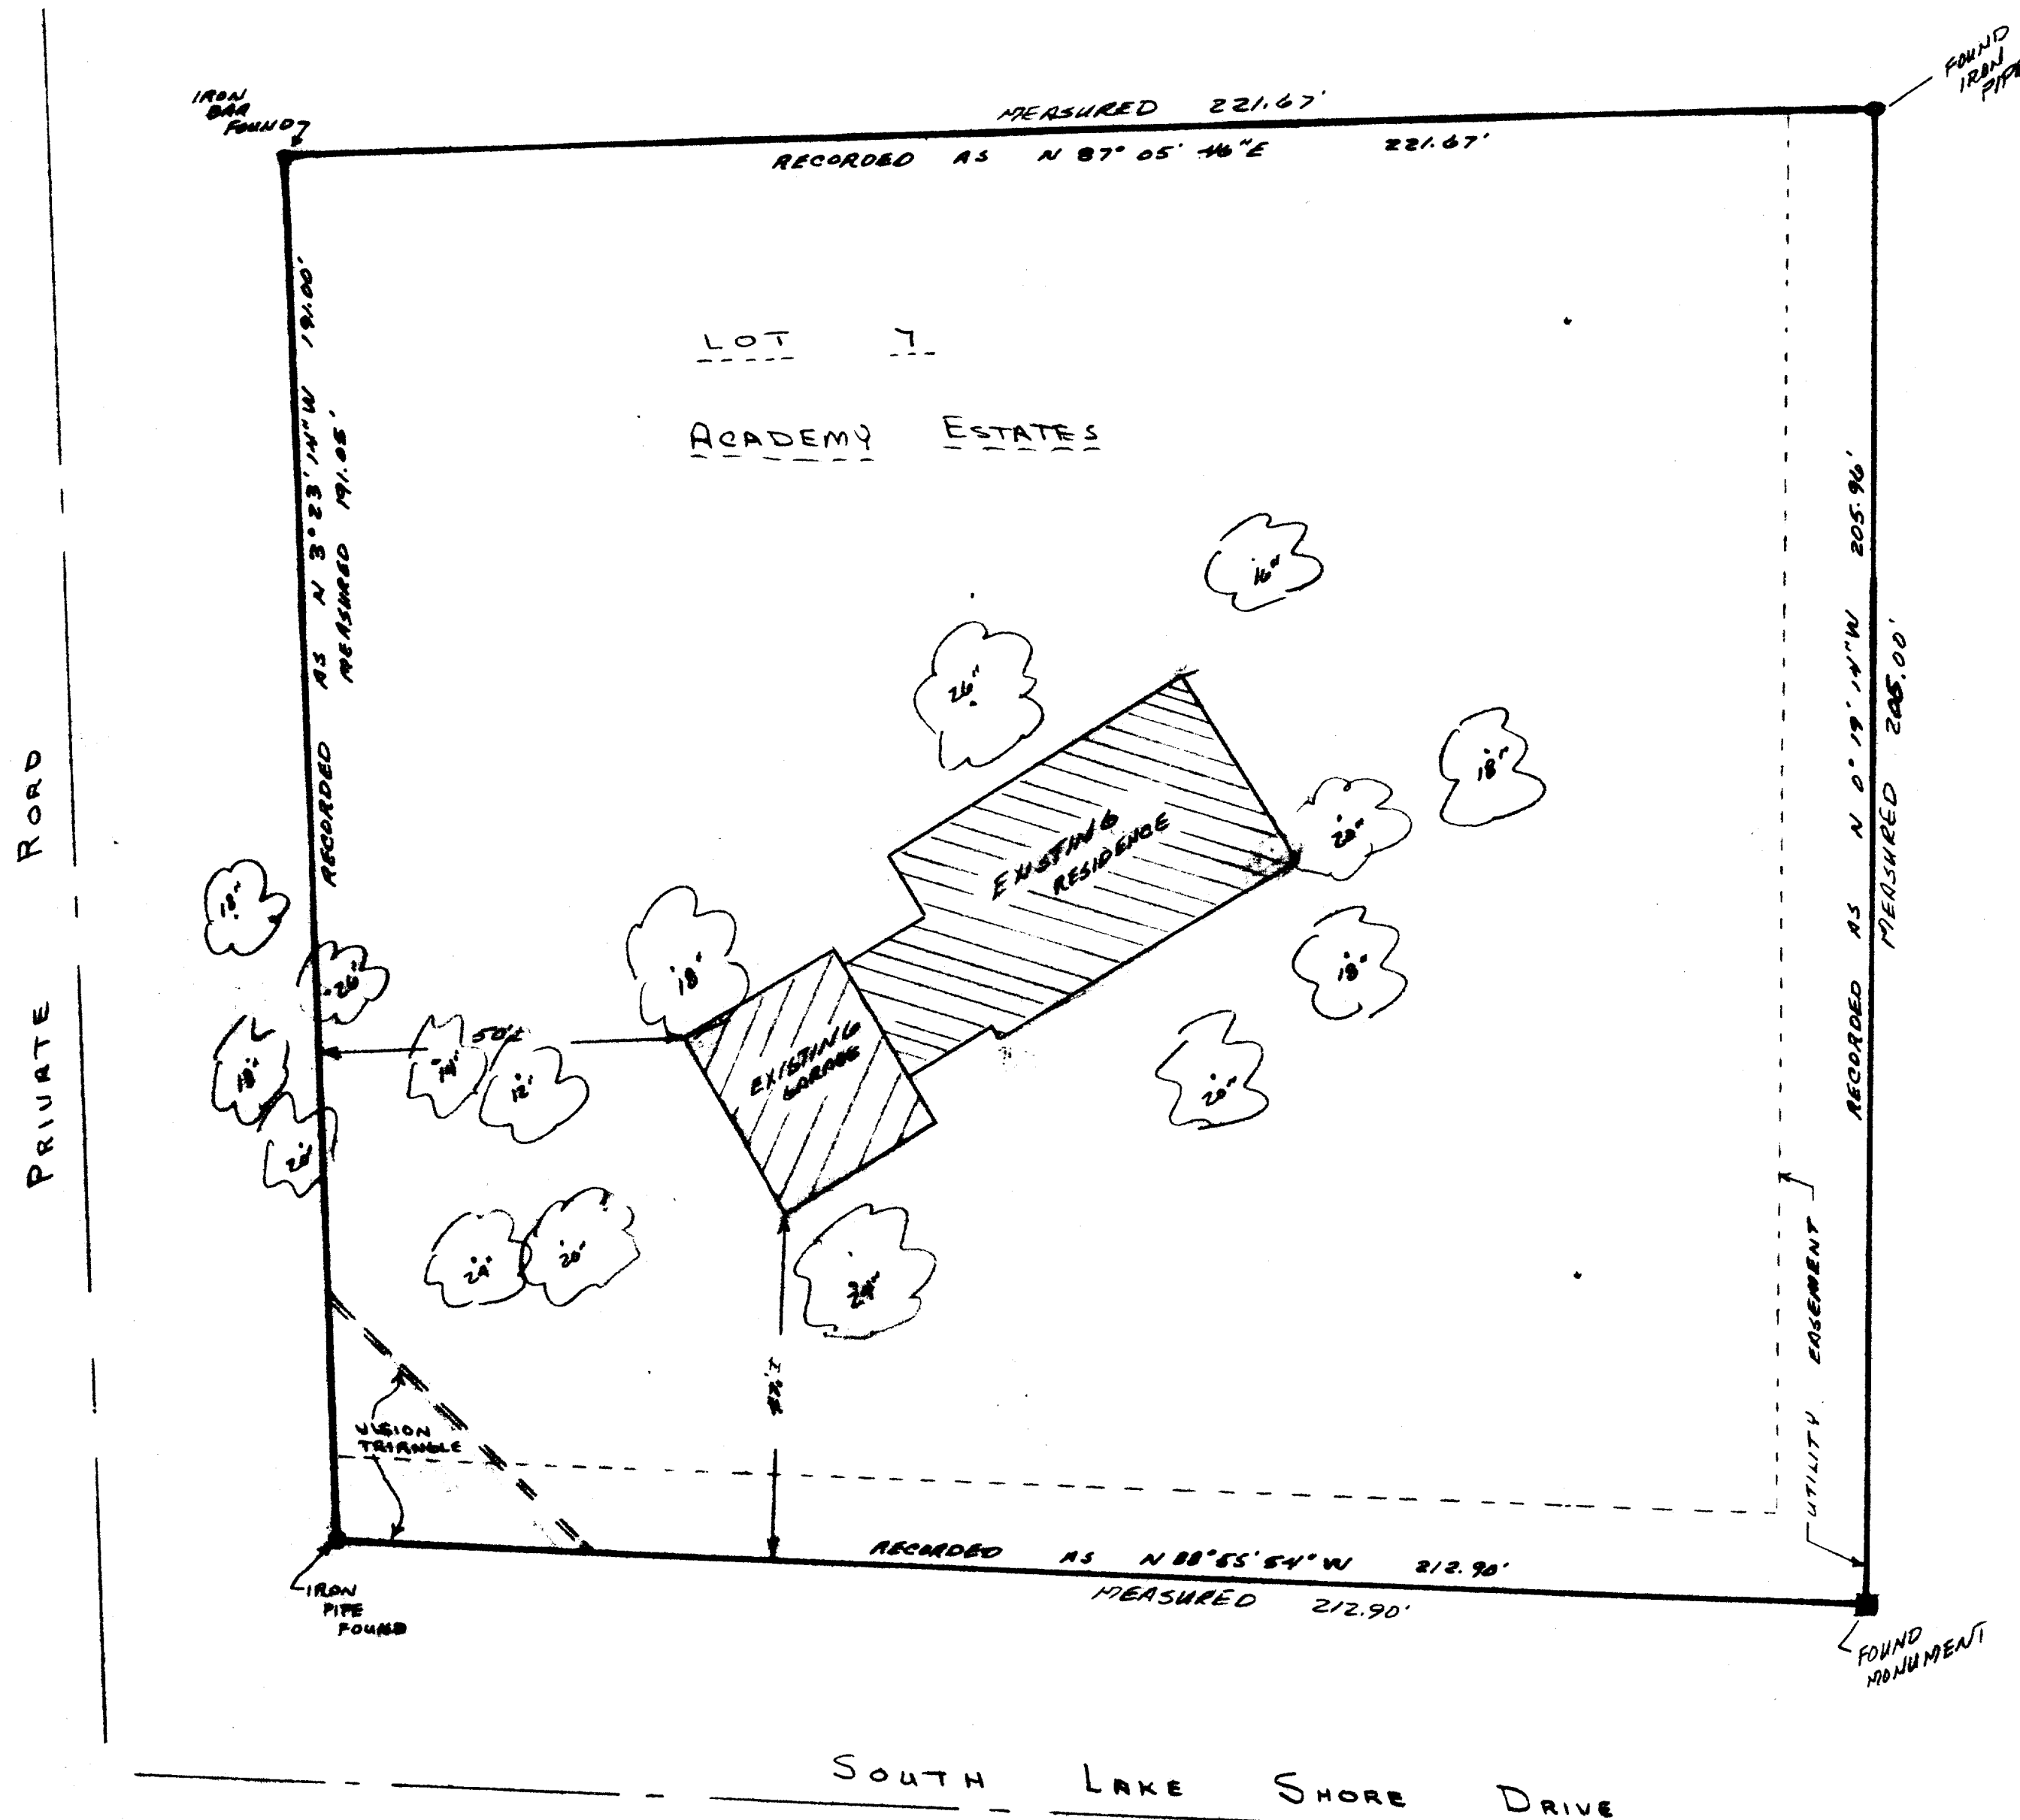

SCALE 1" = 20'


Note: Only trees near the proposed residence were located.

Plat of House and tree locations on Lot 7 of Academy Estates, being a Subdivision located in Section 18, Town 1 North, Range 17 East, Town of Linn, Walworth County Wisconsin.

I hereby certify that I have staked the house as shown hereon and that the above map is a true and accurate representation thereof and shows the size of the property and trees located near the proposed house to the best of my professional knowledge and belief.

Dated this 2 day of Oct, 1981

David D. Cooper

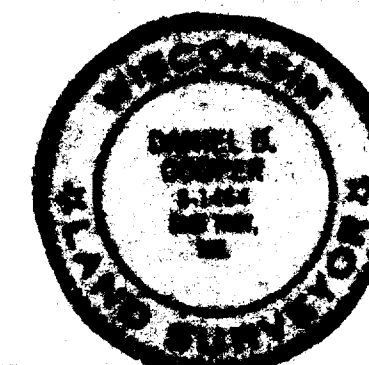

REVISED TO SHOW EXISTING STRUCTURES THIS 10TH DAY OF Aug, 1983