


KOLB LAND CONSULTING, INC.

LAND SURVEYING • SUBDIVIDING • LAND PLANNING

LAKE GENEVA, WISCONSIN 53147

SOUTH STREET 66' WIDE

WILMOT BOULEVARD 40' WIDE

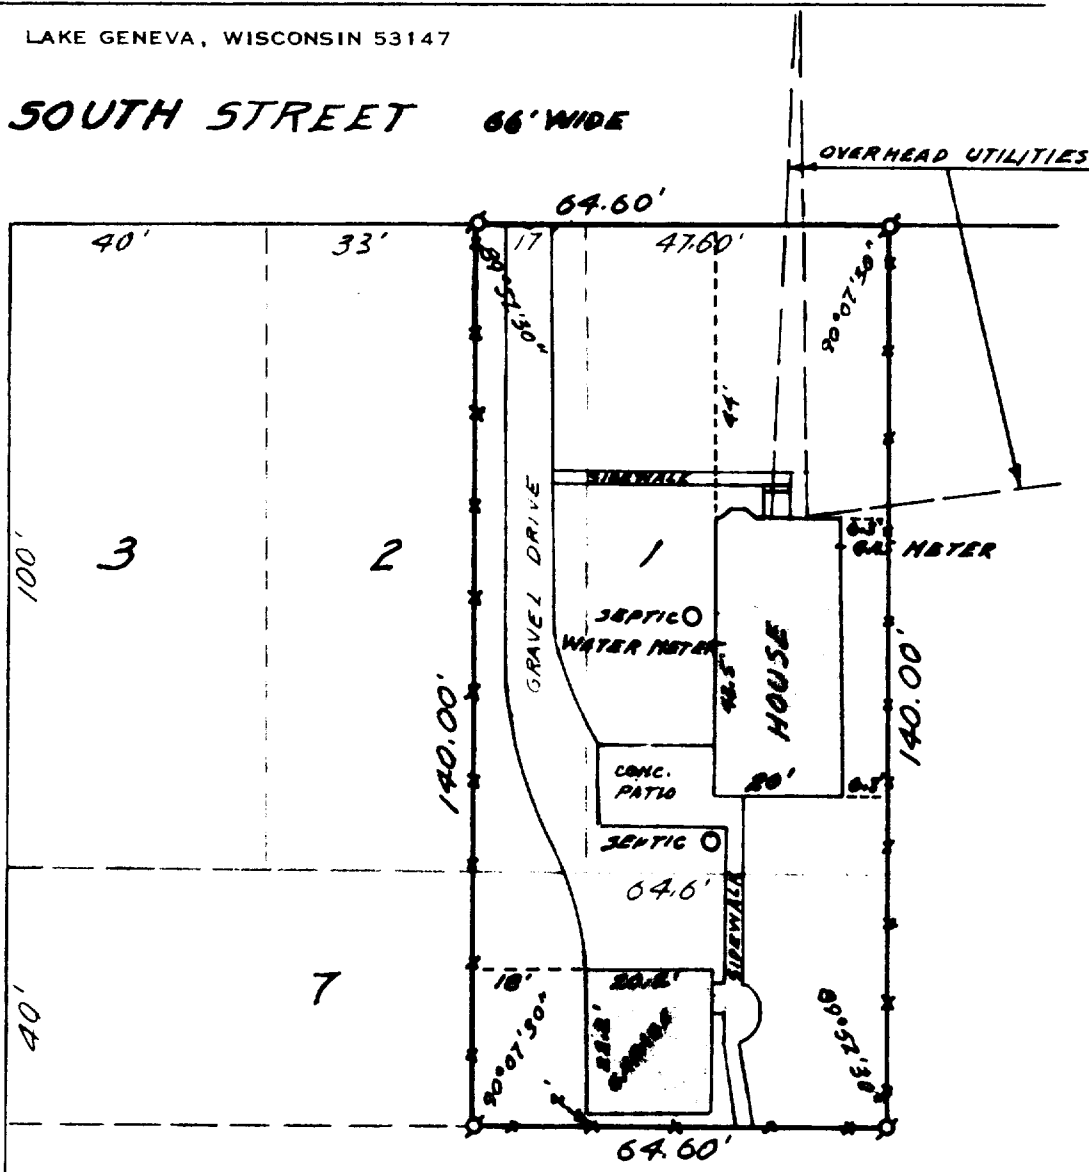

PLAN OF SURVEY OF
LOT 1, THE EAST 17 FEET OF LOT 2 AND THE EAST 47.6 FEET
OF LOT 7, PARADISE VISTA, A SUBDIVISION LOCATED IN THE
SOUTHEAST 1/4 OF SECTION 1, T. 1 N., R. 17 E., TOWN OF LINN,
WALWORTH COUNTY, WISCONSIN.
ORDERED BY: THE TARRANT AGENCY
236 MAIN STREET
LAKE GENEVA, WI 53147



SCALE: 1"=30'

LEGEND
□ IRON PIPE FOUND
— FENCE

I HEREBY CERTIFY THAT I HAVE SURVEYED THE
ABOVE DESCRIBED PROPERTY AND THAT THE ABOVE
MAP IS A TRUE REPRESENTATION THEREOF AND
SHOWS THE SIZE AND LOCATION OF THE PROPERTY,
ITS EXTERIOR BOUNDARIES, THE LOCATION OF ALL
VISIBLE STRUCTURES AND DIMENSIONS OF ALL
PRINCIPAL BUILDINGS THEREON, BOUNDARY FENCES,
APPARENT EASEMENTS, ROADWAYS AND VISIBLE
ENCROACHMENTS, IF ANY.

THIS SURVEY IS MADE FOR THE USE OF THE
PRESENT OWNERS OF THE PROPERTY, AND ALSO
THOSE WHO PURCHASE, MORTGAGE, OR GUARANTEE
THE TITLE THEREIN WITHIN ONE (1) YEAR FROM
THE DATE HEREOF.

Harold H. Kolb

WISCONSIN REGISTERED LAND SURVEYOR, S-187
DATE MAY 20, 1983



117-664-K