


KOLB LAND CONSULTING, INC.
 LAND SURVEYING • SUBDIVIDING • LAND PLANNING

LAKE GENEVA, WISCONSIN 53147

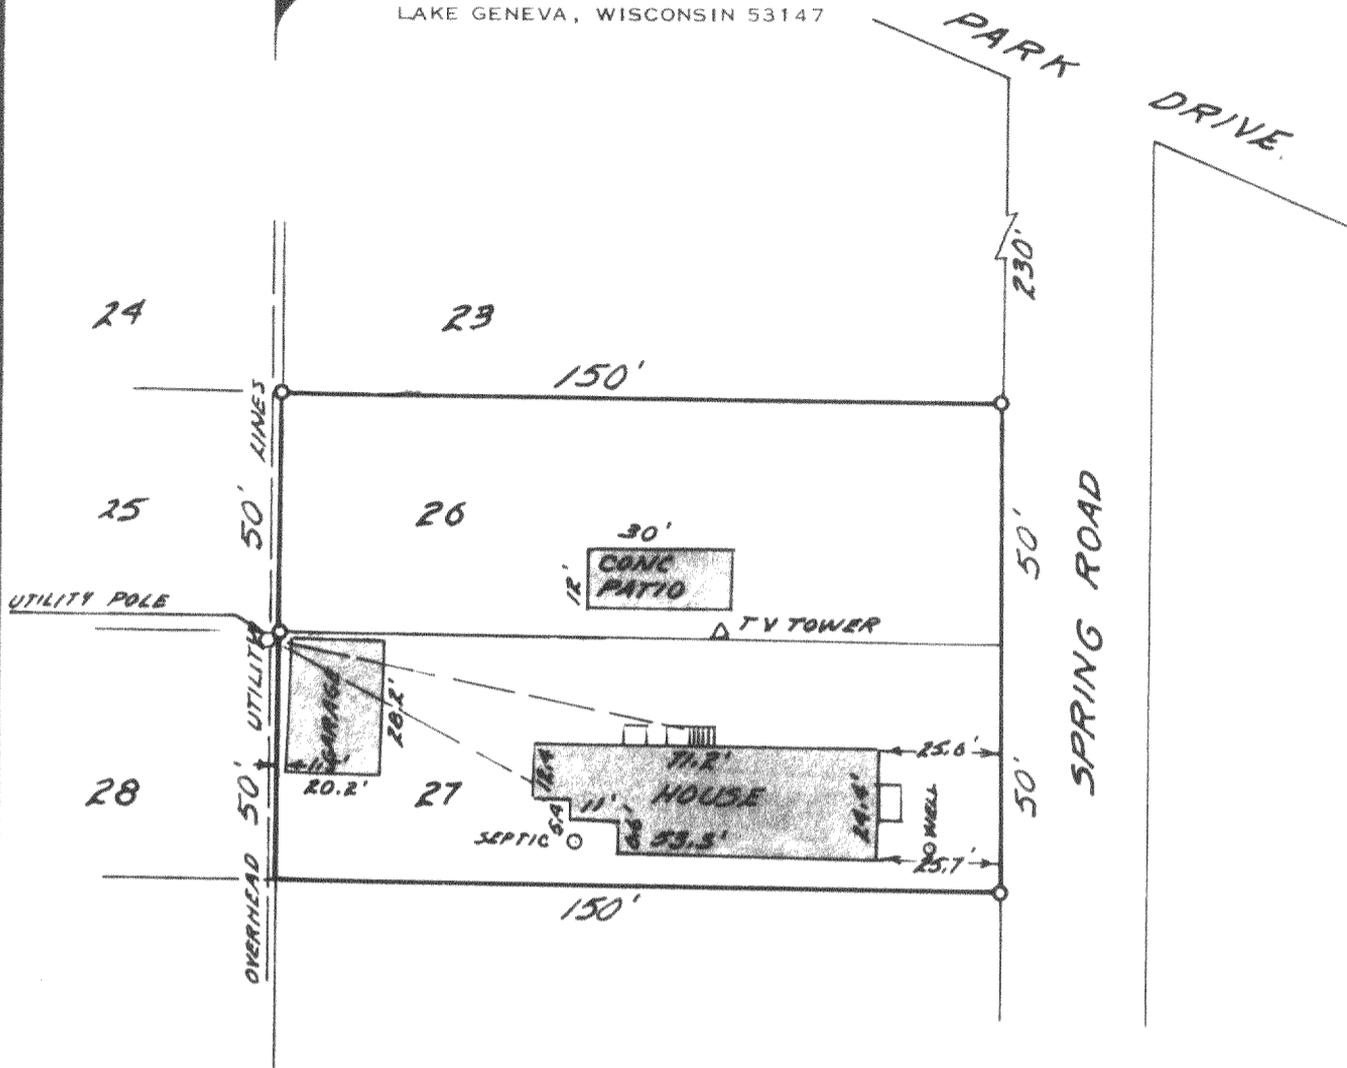

MORTGAGE INSPECTION OF

LOTS 26 & 27, LAKE GENEVA BEACH, A SUBDIVISION LOCATED
 IN SECTION 11, T 1 N, R 17 E, TOWN OF LINN, WALWORTH
 COUNTY, WISCONSIN. TAX NO. 1LGB-21

COMPLIANCE WITH A-E 3, 5(F), 6(A), (B), (C), (D) AND 7
 HAS BEEN WAIVED BY THE CLIENT, IN AGREEMENT WITH THE
 SURVEYOR, AS PERMITTED IN A-E 5.01(B).

ORDERED BY: ANCHOR SAVINGS & LOAN ASSOCIATION
 500 E. WALWORTH AVE.
 DELAVAN, WI. 53115

BUYER: WILLIAM D. CRONIN & SHEILA CRONIN



SCALE: 1"=40'

LEGEND
 ○ IRON PIPE FOUND

Harold H. Kolb

HAROLD H. KOLB
 WISCONSIN REGISTERED LAND SURVEYOR, S-187
 DATE APRIL 4, 1984

117-667