


KOLB LAND CONSULTING, INC.
 LAND SURVEYING • SUBDIVIDING • LAND PLANNING

LAKE GENEVA, WISCONSIN 53147

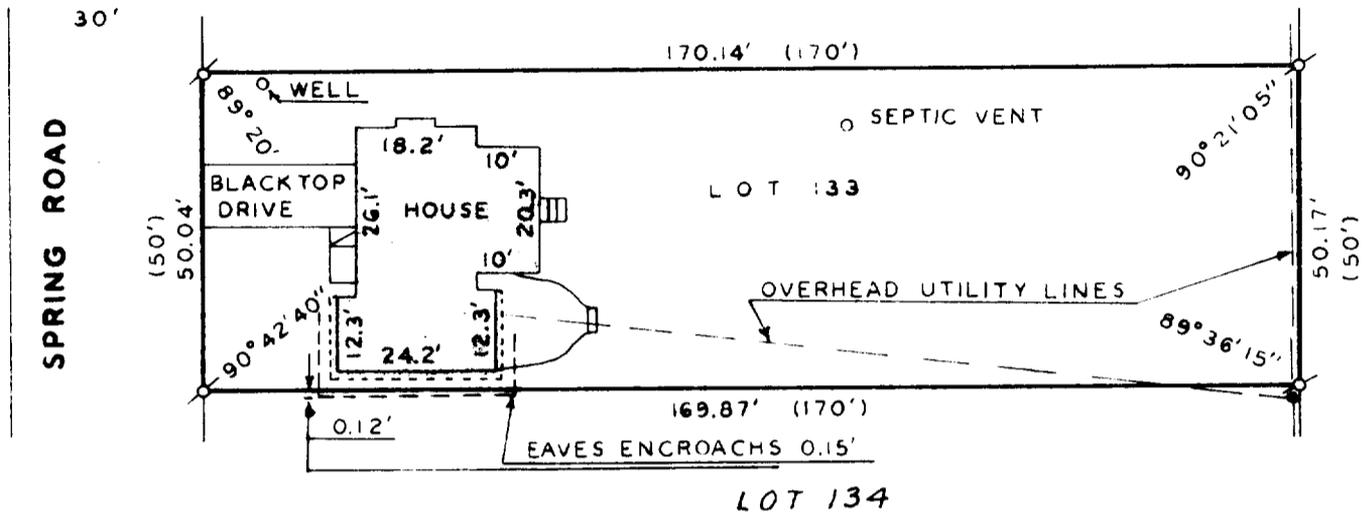

LOT 134
 PLAT OF SURVEY OF

LOT 133, LAKE GENEVA BEACH SUBDIVISION, TOWN 1 NORTH,
 RANGE 17 EAST, WALWORTH COUNTY, WISCONSIN.
 ALSO AN EASEMENT OVER THE NORTH 12 INCHES OF LOT 134,
 AS DESCRIBED IN VOLUME 19 OF RECORDS, PAGE 596,
 WALWORTH COUNTY RECORDS.

ORDERED BY: KENNETH A. ABRAHAM & ASSOCIATES
 301 SOUTH CASS AVENUE
 DARIEN, IL. 60559

TAX PARCEL LGB-120



SCALE - 1"=30'

LEGEND

- ⊙ IRON PIPE FOUND
- UTILITY POLE
- () RECORDED AS

I HEREBY CERTIFY THAT I HAVE SURVEYED THE ABOVE DESCRIBED PROPERTY AND THAT THE ABOVE MAP IS A TRUE REPRESENTATION THEREOF AND SHOWS THE SIZE AND LOCATION OF THE PROPERTY, ITS EXTERIOR BOUNDARIES, THE LOCATION OF ALL VISIBLE STRUCTURES AND DIMENSIONS OF ALL PRINCIPAL BUILDINGS THEREON, BOUNDARY FENCES, APPARENT EASEMENTS, ROADWAYS AND VISIBLE ENCROACHMENTS, IF ANY.

THIS SURVEY IS MADE FOR THE USE OF THE PRESENT OWNERS OF THE PROPERTY, AND ALSO THOSE WHO PURCHASE, MORTGAGE, OR GUARANTEE THE TITLE THERETO WITHIN ONE (1) YEAR FROM DATE HEREOF.

Harold H. Kolb

HAROLD H. KOLB
 WISCONSIN REGISTERED LAND SURVEYOR, S-187
 DATE JULY 25, 1984

117-678

1-17-LGB-120