




WALWORTH COUNTY
SURVEYING & MAPPING
LAKE GENEVA, WISCONSIN

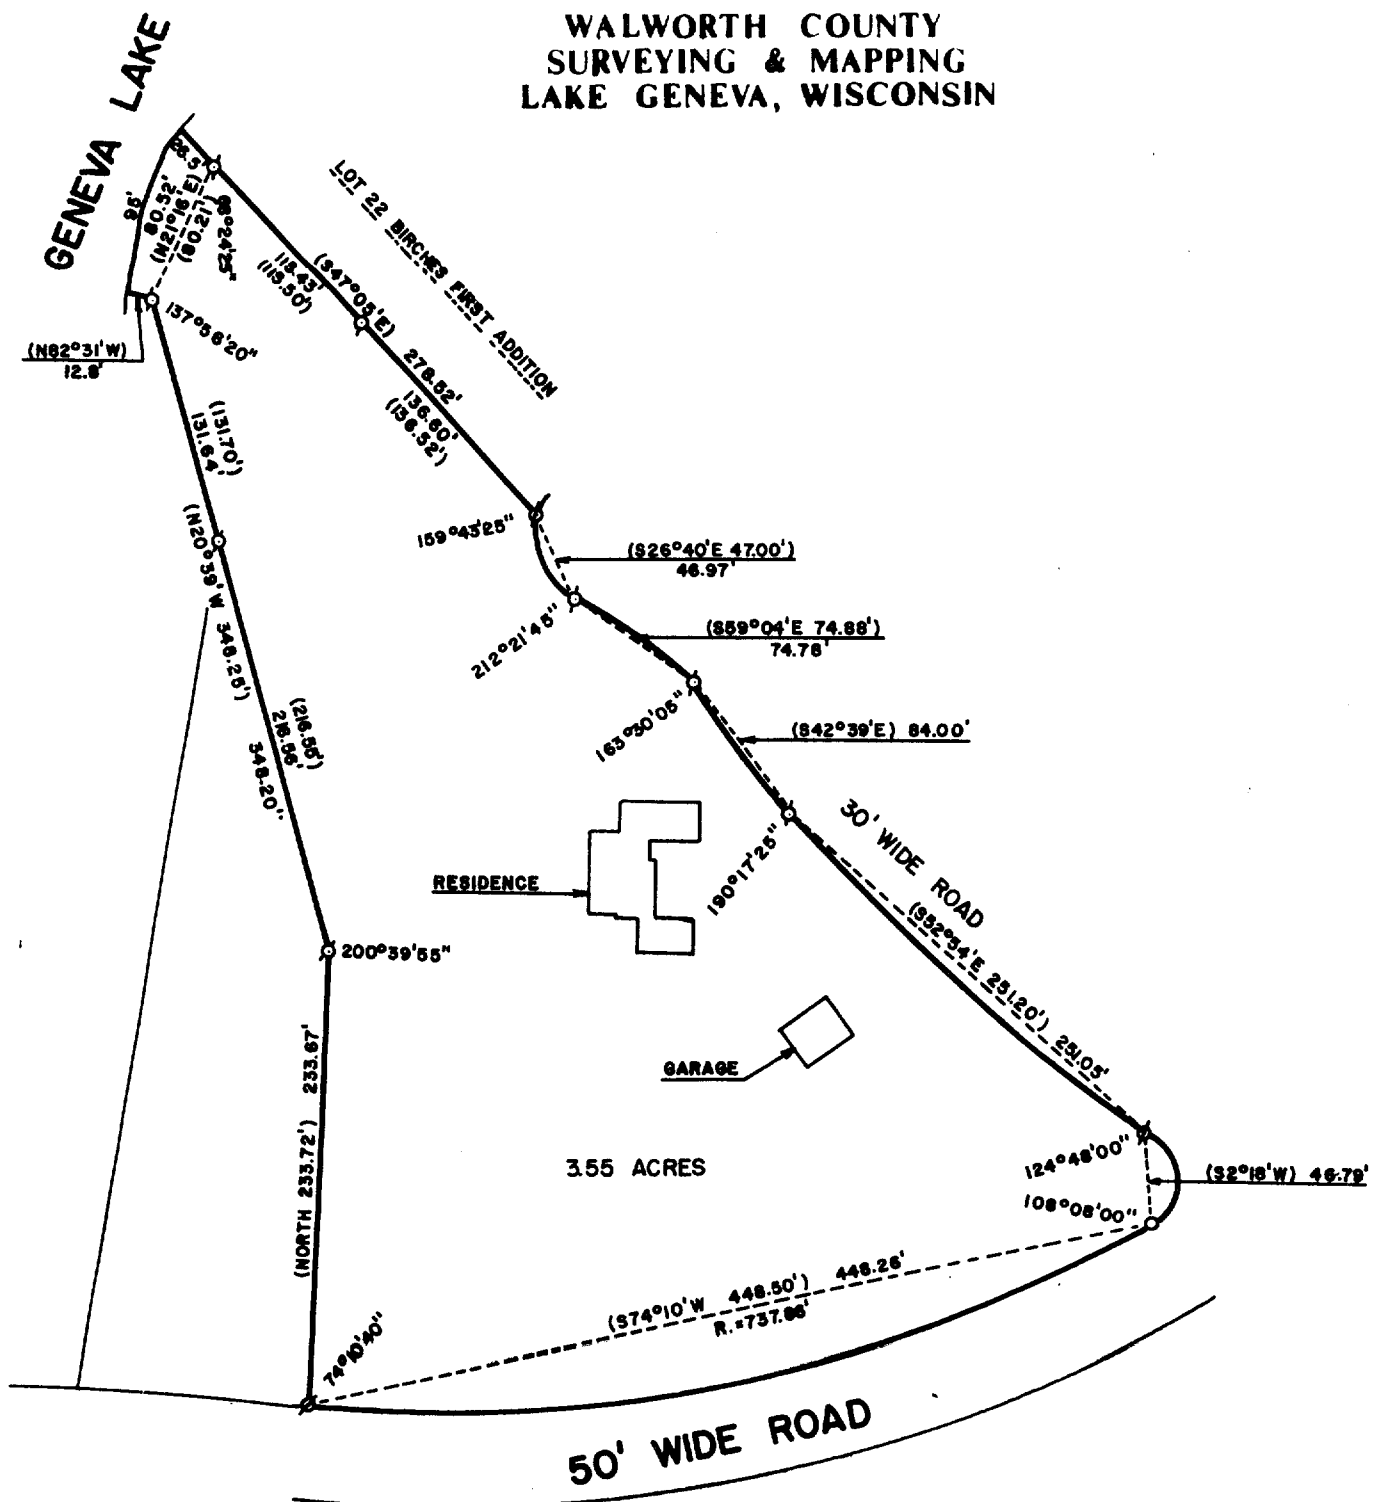

PLAT OF SURVEY OF

A PARCEL OF LAND LOCATED IN THE NORTHEAST 1/4 OF SECTION 9, T 1 N, R 17 E, WALWORTH COUNTY, WISCONSIN AND DESCRIBED IN VOL. 301, PAGE 56 OF RECORDS, WALWORTH COUNTY, WISCONSIN.

ORDERED BY: JOHN FOXLEY
P. O. BOX 515
CHICAGO, ILLINOIS 60690

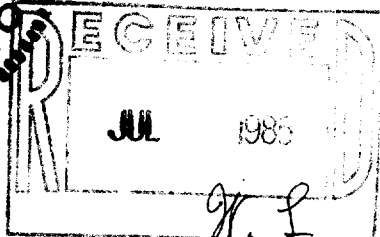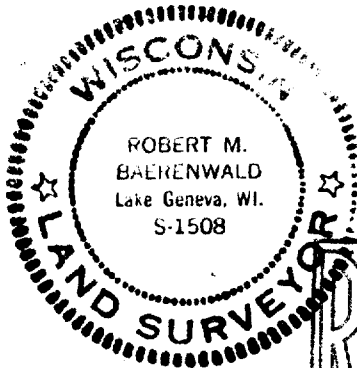

SCALE: 1"=100'

- σ - IRON PIPE FOUND
- ø - IRON ROD FOUND
- o - IRON PIPE PLACED
- () - RECORDED AS

I, ROBERT M. BAERENWALD, DO HEREBY CERTIFY THAT I HAVE SURVEYED THE PROPERTY HEREON DESCRIBED ACCORDING TO THE OFFICIAL RECORDS AND THAT THE PLAT HEREON IS A CORRECT REPRESENTATION OF THE PROPERTY LINES TO THE BEST OF MY KNOWLEDGE AND BELIEF.

Robert M. Baerenwald
ROBERT M. BAERENWALD
WISCONSIN REGISTERED LAND SURVEYOR, S-1508

DATE Aug 20, 1984
JOB NO. 0105

L-9-1A9 & 7-1A1

117-679-B