



WALWORTH COUNTY
SURVEYING & MAPPING
LAKE GENEVA, WISCONSIN

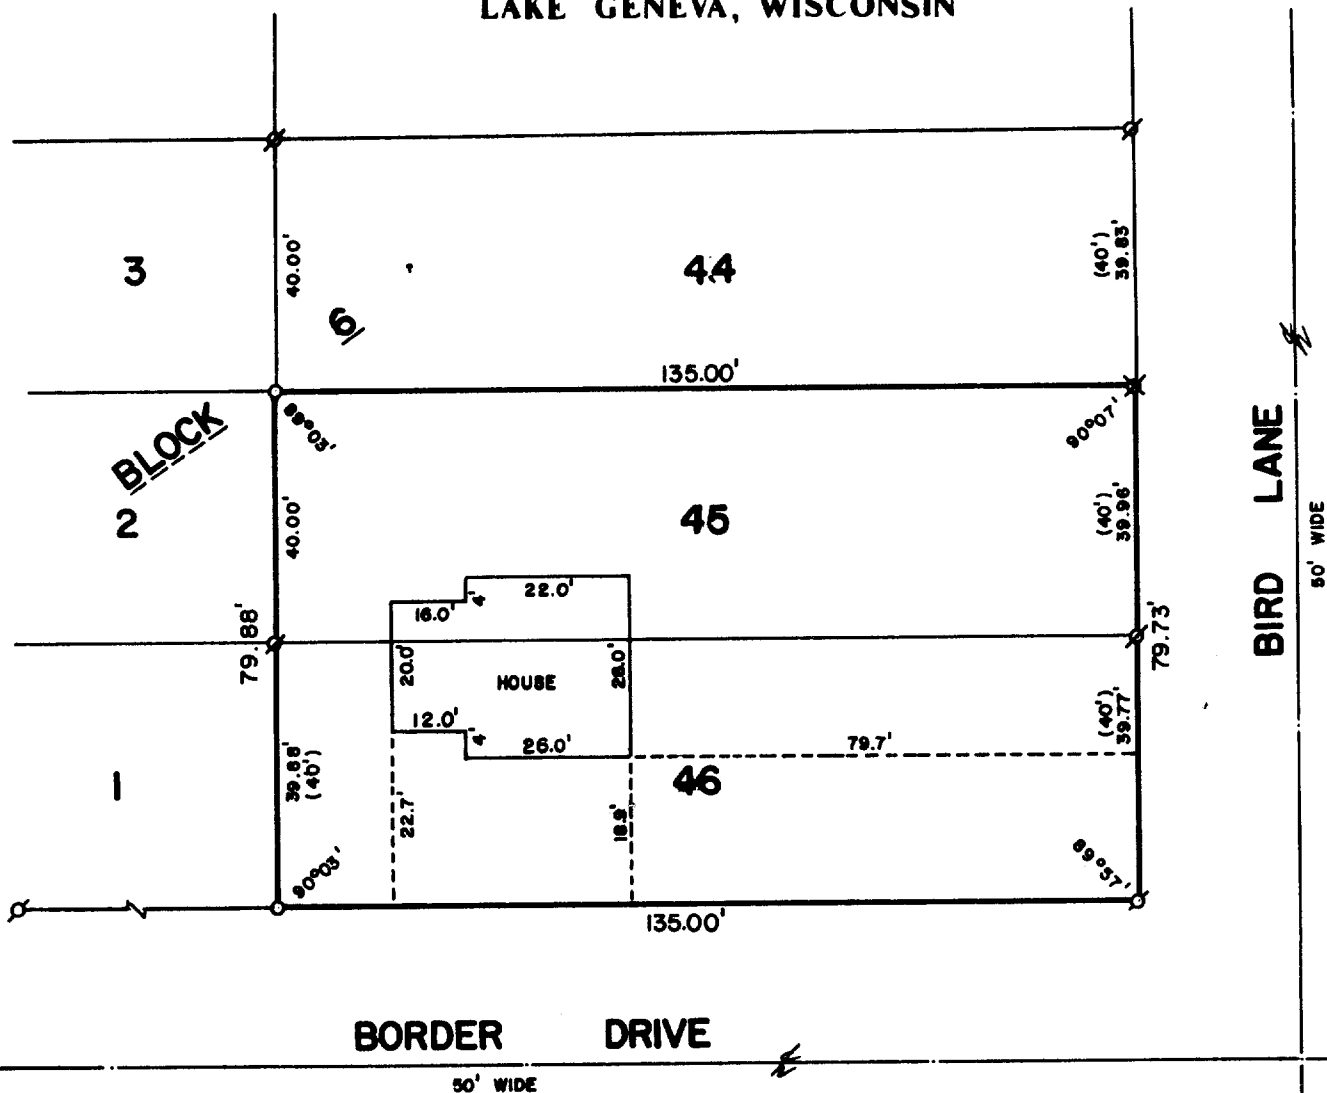


PLAT OF SURVEY OF

LOTS 45 AND 46, BLOCK 6 OF MAPLE HILLS
SUBDIVISION, LOCATED IN SECTION 18, T 1 N,
R 17 E, WALWORTH COUNTY, WISCONSIN.

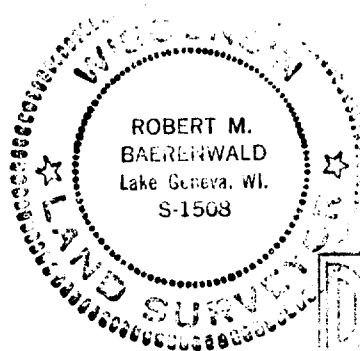

ORDERED BY: KEEFE REAL ESTATE
P. O. BOX 268
WALWORTH, WISCONSIN 53184

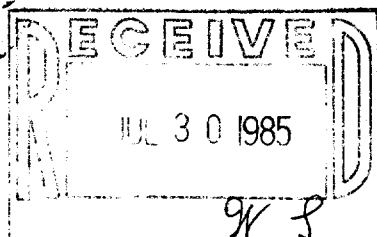

SCALE: 1"=30'

- ⊗ - IRON PIPE FOUND
- ⊘ - IRON ROD FOUND
- ⊗ - IRON ROD FOUND, IRON PIPE PLACED
- - IRON PIPE PLACED

() - RECORDED AS

I, ROBERT M. BAERENWALD, DO HEREBY CERTIFY THAT I HAVE SURVEYED THE PROPERTY HEREON DESCRIBED ACCORDING TO THE OFFICIAL RECORDS AND THAT THE PLAT HEREON IS A CORRECT REPRESENTATION OF THE PROPERTY LINES TO THE BEST OF MY KNOWLEDGE AND BELIEF.

Robert M. Baerenwald
ROBERT M. BAERENWALD
WISCONSIN REGISTERED LAND SURVEYOR, S-1508

DATE *January 6, 1985* JOB NO. 0185

117-682-13