

LAKE GENEVA, WISCONSIN 53147

LOT 14

LOT 9

LOT 10

LOT 8

BLOCK 2

HOUSE

Overhead Deck

Septic Cover

Sidewalk

Overhead Utility Lines

LAKEVIEW ROAD


PLAT OF SURVEY OF

LOT 9, BLOCK 2, WOODDALE ADDITION, T1N, R17E, WALWORTH COUNTY, WISCONSIN.

ORDERED BY: KENOSHA SAVINGS & LOAN
410 BROAD STREET
LAKE GENEVA, WI 53147

LOT 9, BLOCK 2, WOODDALE
ADDITION, T1N, R17E,
WALWORTH COUNTY, WISCONSIN.

ORDERED BY: KENOSHA SAVINGS
& LOAN
410 BROAD STREET
LAKE GENEVA, WI 53147

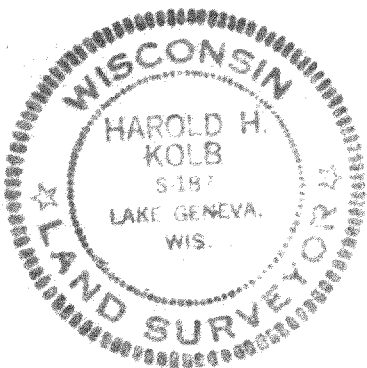

LEGEND

- Ø - IRON PIPE FOUND
○ - IRON PIPE SET
() - RECORDED AS

I HEREBY CERTIFY THAT I HAVE SURVEYED THE ABOVE DESCRIBED PROPERTY AND THAT THE ABOVE MAP IS A TRUE REPRESENTATION THEREOF AND SHOWS THE SIZE AND LOCATION OF THE PROPERTY, ITS EXTERIOR BOUNDARIES, THE LOCATION OF ALL VISIBLE STRUCTURES AND DIMENSIONS OF ALL PRINCIPAL BUILDINGS THEREON, BOUNDARY FENCES, APPARENT EASEMENTS, ROADWAYS AND VISIBLE ENCROACHMENTS, IF ANY.

THIS SURVEY IS MADE FOR THE USE OF THE PRESENT OWNERS OF THE PROPERTY, AND ALSO THOSE WHO PURCHASE, MORTGAGE, OR GUARANTEE THE TITLE THERETO WITHIN ONE (1) YEAR FROM DATE HEREOF.

Harold H. Kohl

HAROLD H. KOLB
WISCONSIN REGISTERED LAND SURVEYOR, S- 187
DATE AUGUST 8, 1984

117-684^v

1-17-445