


PLAT OF SURVEY OF LOTS 124 & 125 OF
LAKE GENEVA BEACH SUBDIVISION
AS REC. IN VOL. 9 OF PLATS PG. 27
LOCATED IN SEC. 11, T. 1N., R. 17E
TOWN OF LINN, WALWORTH COUNTY, WISCONSIN

PARK DR.

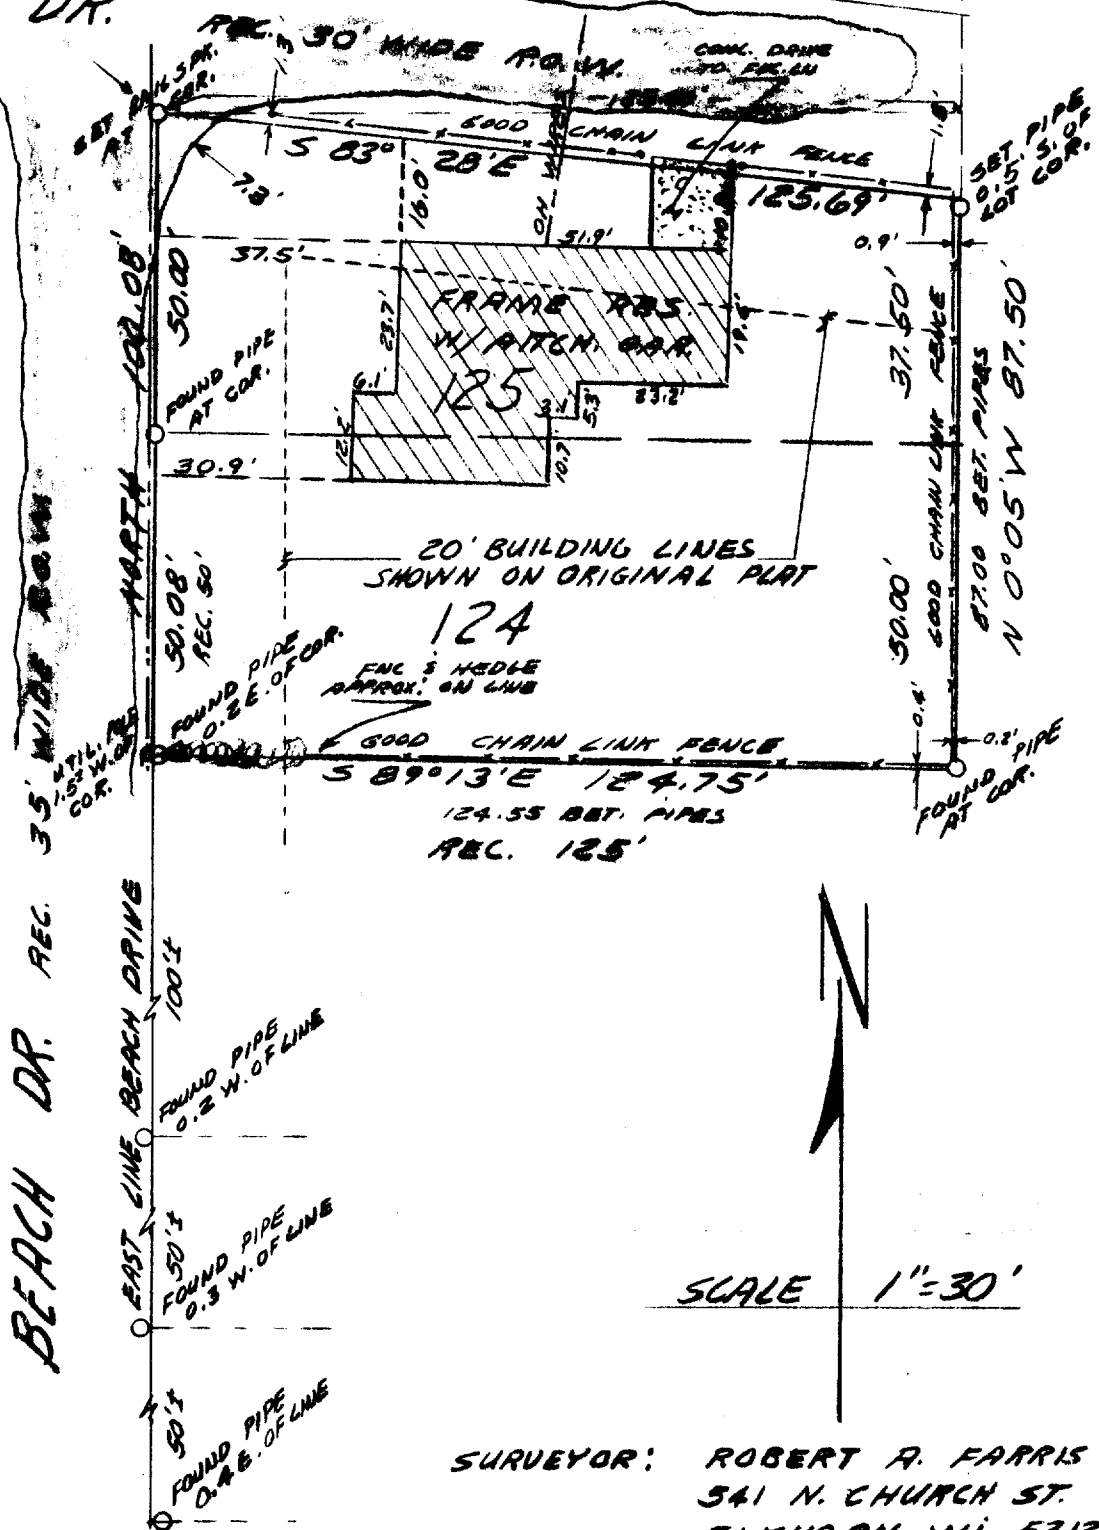

SURVEYOR: ROBERT A. FARRIS
341 N. CHURCH ST.
ELKHORN, WI. 53121


ORDERED BY: GEORGE BRADSHAW
550 PENNSYLVANIA AVE.
GLEN ELLYN IL. 60137

OWNER ACK: JOHN & HAZEL TUSCHALL
TO TAX LISTOR 919 SO. COUNTY LINE RD.
HINSDALE, IL 60521

I hereby certify that I have surveyed the above described property and that the above map is a true representation thereof and shows the size and location of the property, its exterior boundaries, the location of all visible structures and dimensions of all principal buildings thereon, boundary fences, apparent easements, roadways and visible encroachments, if any.

This survey is made for the use of the present owners of the property, and also those who purchase, mortgage, or guarantee the title thereto within one (1) year from date hereof.

Robert A. Farris

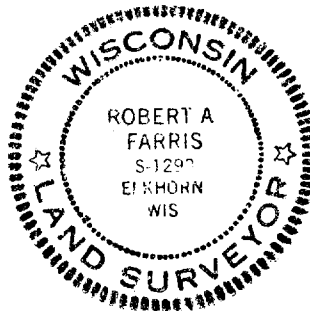

DATED 4/24/85

PROJ#1303.001

117-686✓