



RECEIVED
AUG 5 1985
K. L.

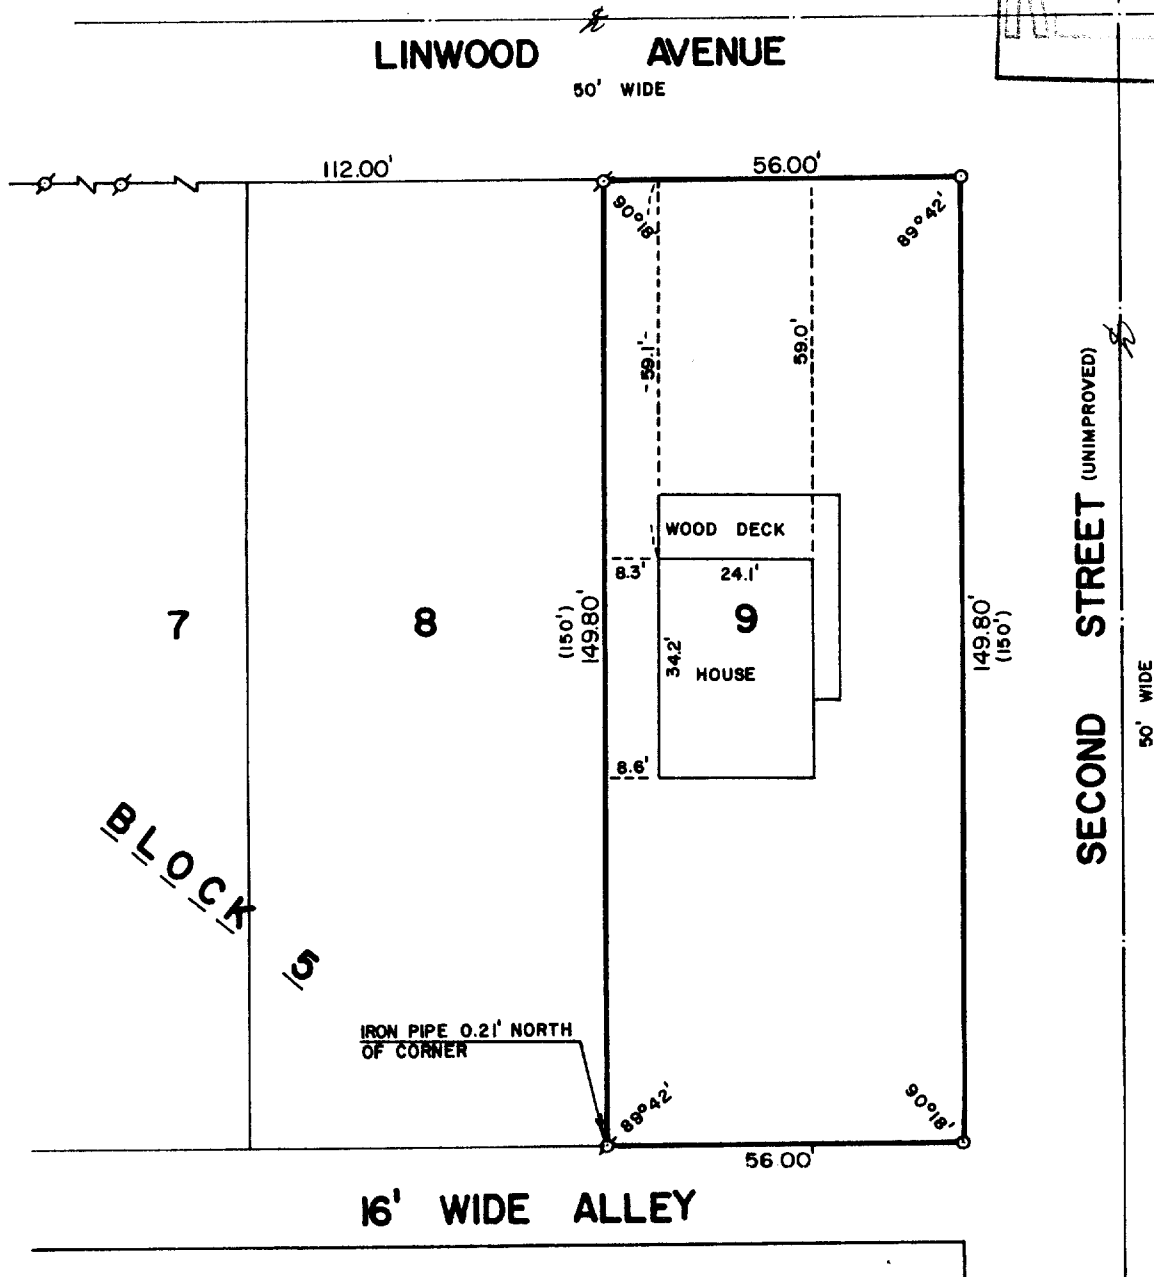

LOT 9, BLOCK 5 OF GENEVISTA, A
SUBDIVISION LOCATED IN T 1 N, R 17 E,
WALWORTH COUNTY, WISCONSIN.

ORDERED BY: KEVIN MCENEELY
2416 THAYER
EVANSTON, ILLINOIS 60201

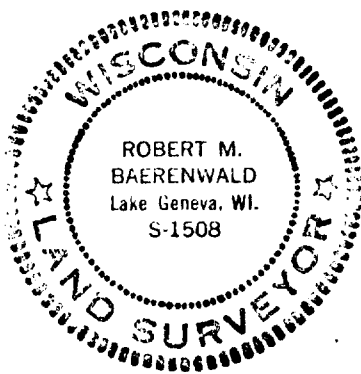

I, ROBERT M. BAERENWALD, DO HEREBY CERTIFY THAT I HAVE SURVEYED THE PROPERTY HEREON DESCRIBED ACCORDING TO THE OFFICIAL RECORDS AND THAT THE PLAT HEREON IS A CORRECT REPRESENTATION OF THE PROPERTY LINES TO THE BEST OF MY KNOWLEDGE AND BELIEF.

DATE April 27, 1985 JOB NO. 0248

Ø - IRON PIPE FOUND
○ - IRON PIPE PLACED
() - RECORDED AS

117-693 ✓