



WALWORTH COUNTY
SURVEYING & MAPPING
LAKE GENEVA, WISCONSIN

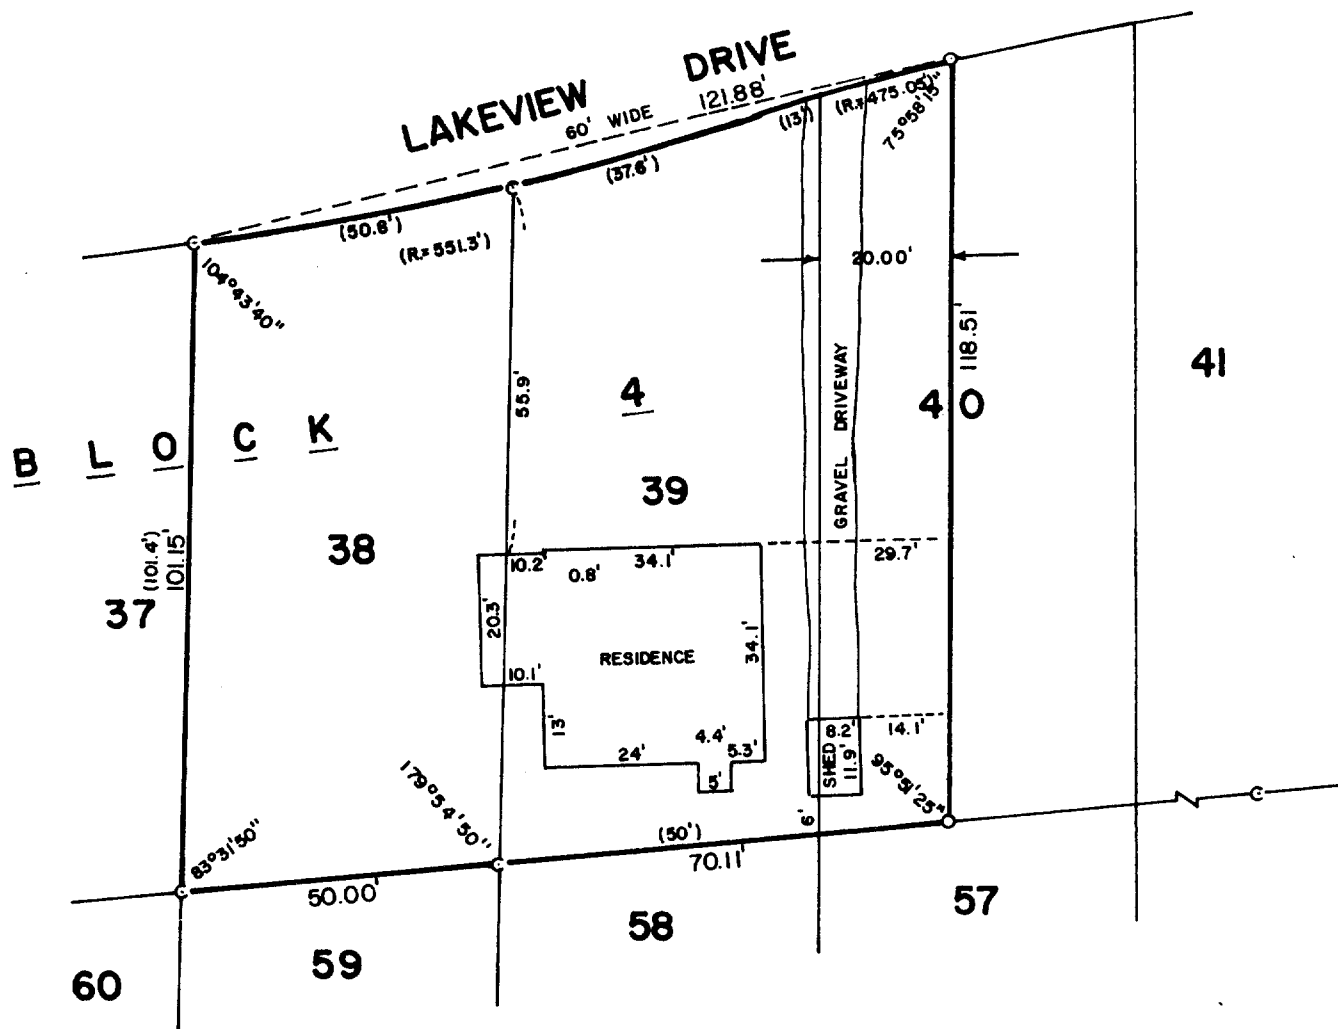

PLAT OF SURVEY OF

LOTS 38, 39 AND THE WESTERLY 20 FEET
OF LOT 40, BLOCK 4 OF LAKEVIEW PARK,
A SUBDIVISION LOCATED IN T 1 N, R 17 E,
WALWORTH COUNTY, WISCONSIN.

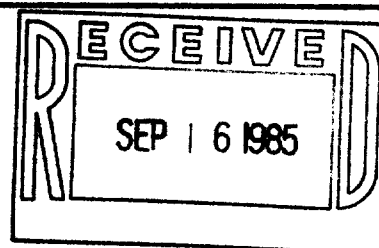

ORDERED BY: JAN TERMAAT
113 ST. ANDREWS TRAIL
FONTANA, WISCONSIN
53125

I, ROBERT M. BAERENWALD, DO HEREBY CERTIFY THAT I
HAVE SURVEYED THE PROPERTY HEREON DESCRIBED ACCORDING
TO THE OFFICIAL RECORDS AND THAT THE PLAT HEREON IS A
CORRECT REPRESENTATION OF THE PROPERTY LINES TO THE
BEST OF MY KNOWLEDGE AND BELIEF.

Robert M. Baerenwald
ROBERT M. BAERENWALD
WISCONSIN REGISTERED LAND SURVEYOR, S-1508

DATE *Aug. 29, 1985* JOB NO. 0352



SCALE: 1"=30'

c - IRON PIN FOUND
o - IRON ROD SET
() - RECORDED AS

TLVP-00020

117-694-B 2 ✓