
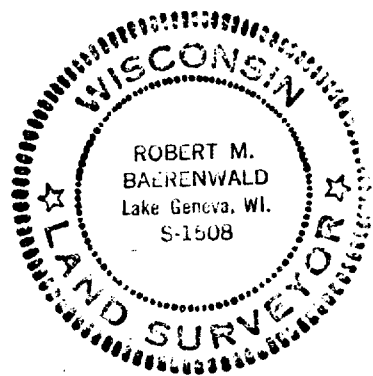


WALWORTH COUNTY
SURVEYING & MAPPING
LAKE GENEVA, WISCONSIN

ORDERED BY: COLDWELL BANKER
GENEVA LAKES AREA
REALTORS
838 MAIN STREET
LAKE GENEVA, WISCONSIN
53147

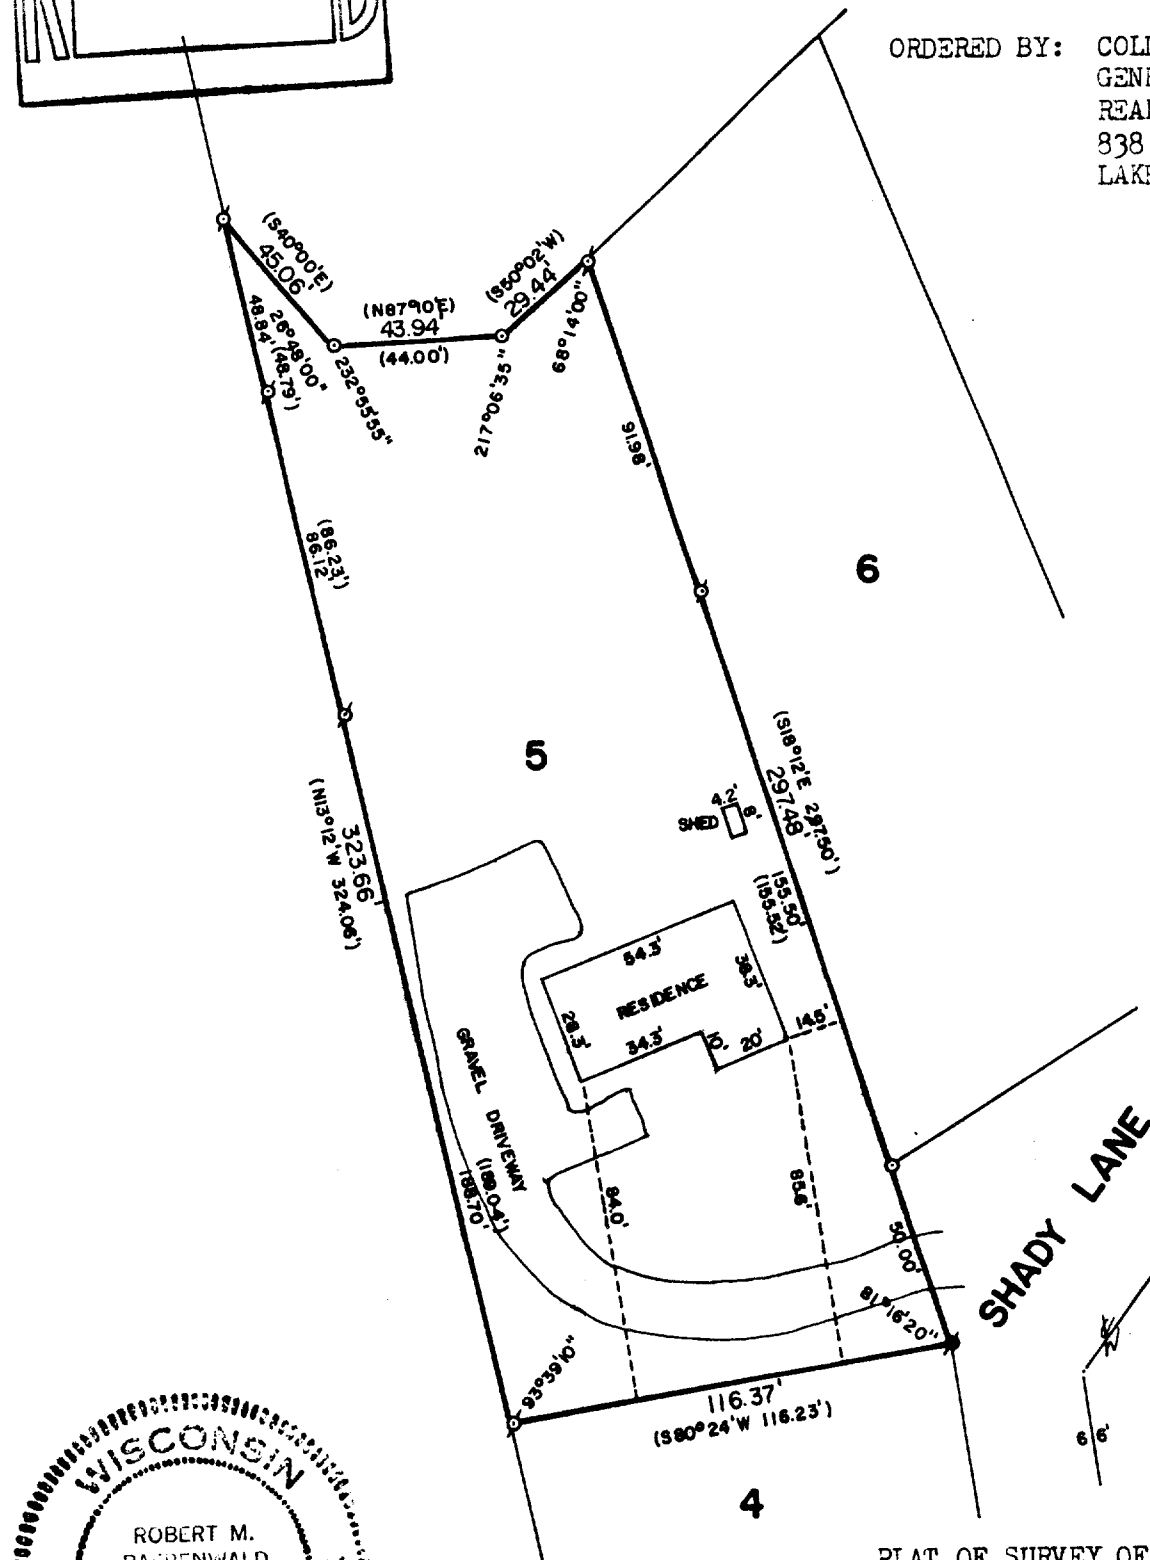

PLAT OF SURVEY OF

LOT 5 OF FOREST REST SUBDIVISION, LOCATED
IN SECTION 2, T 1 N, R 17 E, WALWORTH
COUNTY, WISCONSIN.



SCALE: 1"=50'

- Ø - IRON PIPE FOUND
- - CONCRETE MONUMENT FOUND
- - IRON ROD SET
- () - RECORDED AS

I, ROBERT M. BAERENWALD, DO HEREBY CERTIFY THAT I
HAVE SURVEYED THE PROPERTY HEREON DESCRIBED ACCORDING
TO THE OFFICIAL RECORDS AND THAT THE PLAT HEREON IS A
CORRECT REPRESENTATION OF THE PROPERTY LINES TO THE
BEST OF MY KNOWLEDGE AND BELIEF.

Robert M. Baerenwald
ROBERT M. BAERENWALD
WISCONSIN REGISTERED LAND SURVEYOR, S-1508

Oct. 15, 1985
DATE JOB NO. 0400

117-695-B