


RECEIVED
OCT 22 1985

OCT 22 1985

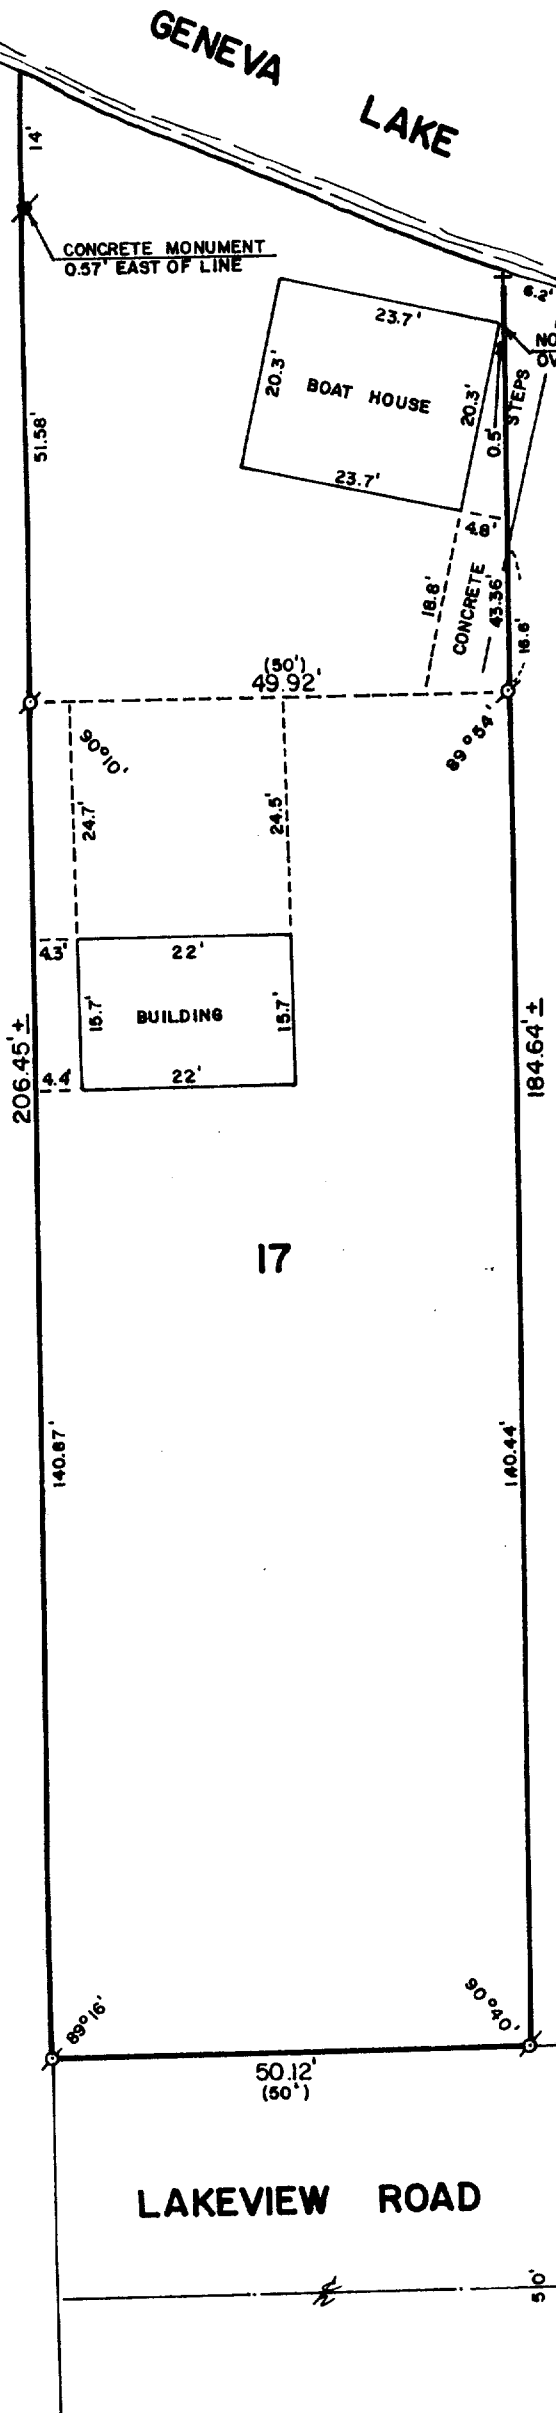

WISCONSIN

ROBERT M.
BAERENWALD
Lake Geneva, WI.
S-1508

LAND SURVEYOR



δ-IRON PIPE FOUND
 + -CUT CROSS IN CONCRETE FOUND
 ()-RECORDED AS

Robert M. Baerenwald
ROBERT M. BAERENWALD
WISCONSIN REGISTERED LAND SURVEYOR, S-1508

DATE Oct. 12, 1985 JOB NO. 0395

117-696-B[✓]