


RECEIVED
SEP 30 1985


KOLB LAND CONSULTING, INC.
LAND SURVEYING • SUBDIVIDING • LAND PLANNING

929 WILLIAMS STREET LAKE GENEVA, WISCONSIN 53147 414-248-3697

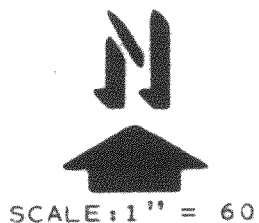

LEGEND

- Ø - IRON PIPE FOUND
- - IRON PIPE PLACED
- SW - SIDE WALK
- Δ - UTILITY POLE
- OVERHEAD UTILITY LINE
- ✕ - IRON ROD FOUND

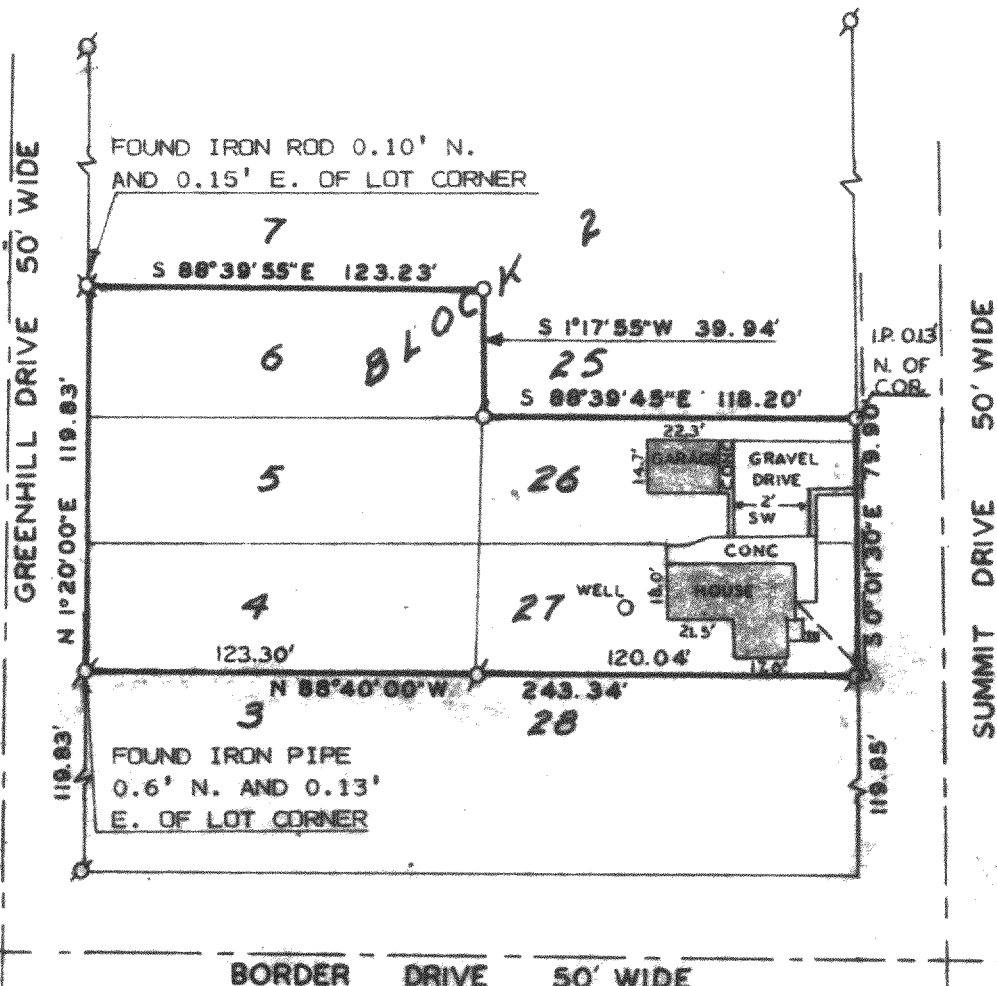


ORDERED BY: PETER KING
P.O. BOX 374
FONTANA, WI. 53125

PLAT OF SURVEY OF

LOTS 4, 5, 6, 26 AND 27, BLOCK 2, MAPLE HILLS "A", A
SUBDIVISION LOCATED IN SECTION 18, T 1 N, R 17 E, TOWN
OF LINN, WALWORTH COUNTY, WISCONSIN.

NOTE: BEARINGS ARE ASSUMED
THE SOUTH LINE OF BLOCK 2
IS AS SHOWN ON THE RECORD-
ED PLAT.

I HEREBY CERTIFY THAT I HAVE SURVEYED THE ABOVE
DESCRIBED PROPERTY AND THAT THE ABOVE MAP IS A
TRUE REPRESENTATION THEREOF AND SHOWS THE SIZE
AND LOCATION OF THE PROPERTY, IT'S EXTERIOR BOUN-
DARIES, THE LOCATION OF ALL VISIBLE STRUCTURES
AND DIMENSIONS OF ALL PRINCIPAL BUILDINGS THERE-
ON, BOUNDARY FENCES, APPARENT EASEMENTS, ROADWAYS
AND VISIBLE ENCROACHMENTS, IF ANY, TO THE BEST
OF MY KNOWLEDGE AND BELIEF.
THIS SURVEY IS MADE FOR THE USE OF THE PRESENT
OWNERS OF THE PROPERTY, AND ALSO THOSE WHO PUR-
CHASE, MORTGAGE, OR GUARANTEE THE TITLE THERETO
WITHIN ONE (1) YEAR FROM DATE THEREOF.

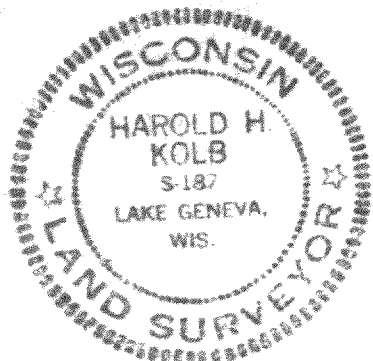

Harold H. Kolb
HAROLD H. KOLB

WISCONSIN REGISTERED LAND SURVEYOR, S-187

DATE JULY 24, 1985

REVISED

REVISED

117-698-K

1-17 114H 15, 16 & 35