


HAROLD H. KOLB
REGISTERED PROFESSIONAL LAND SURVEYOR
LAKE GENEVA, WISCONSIN

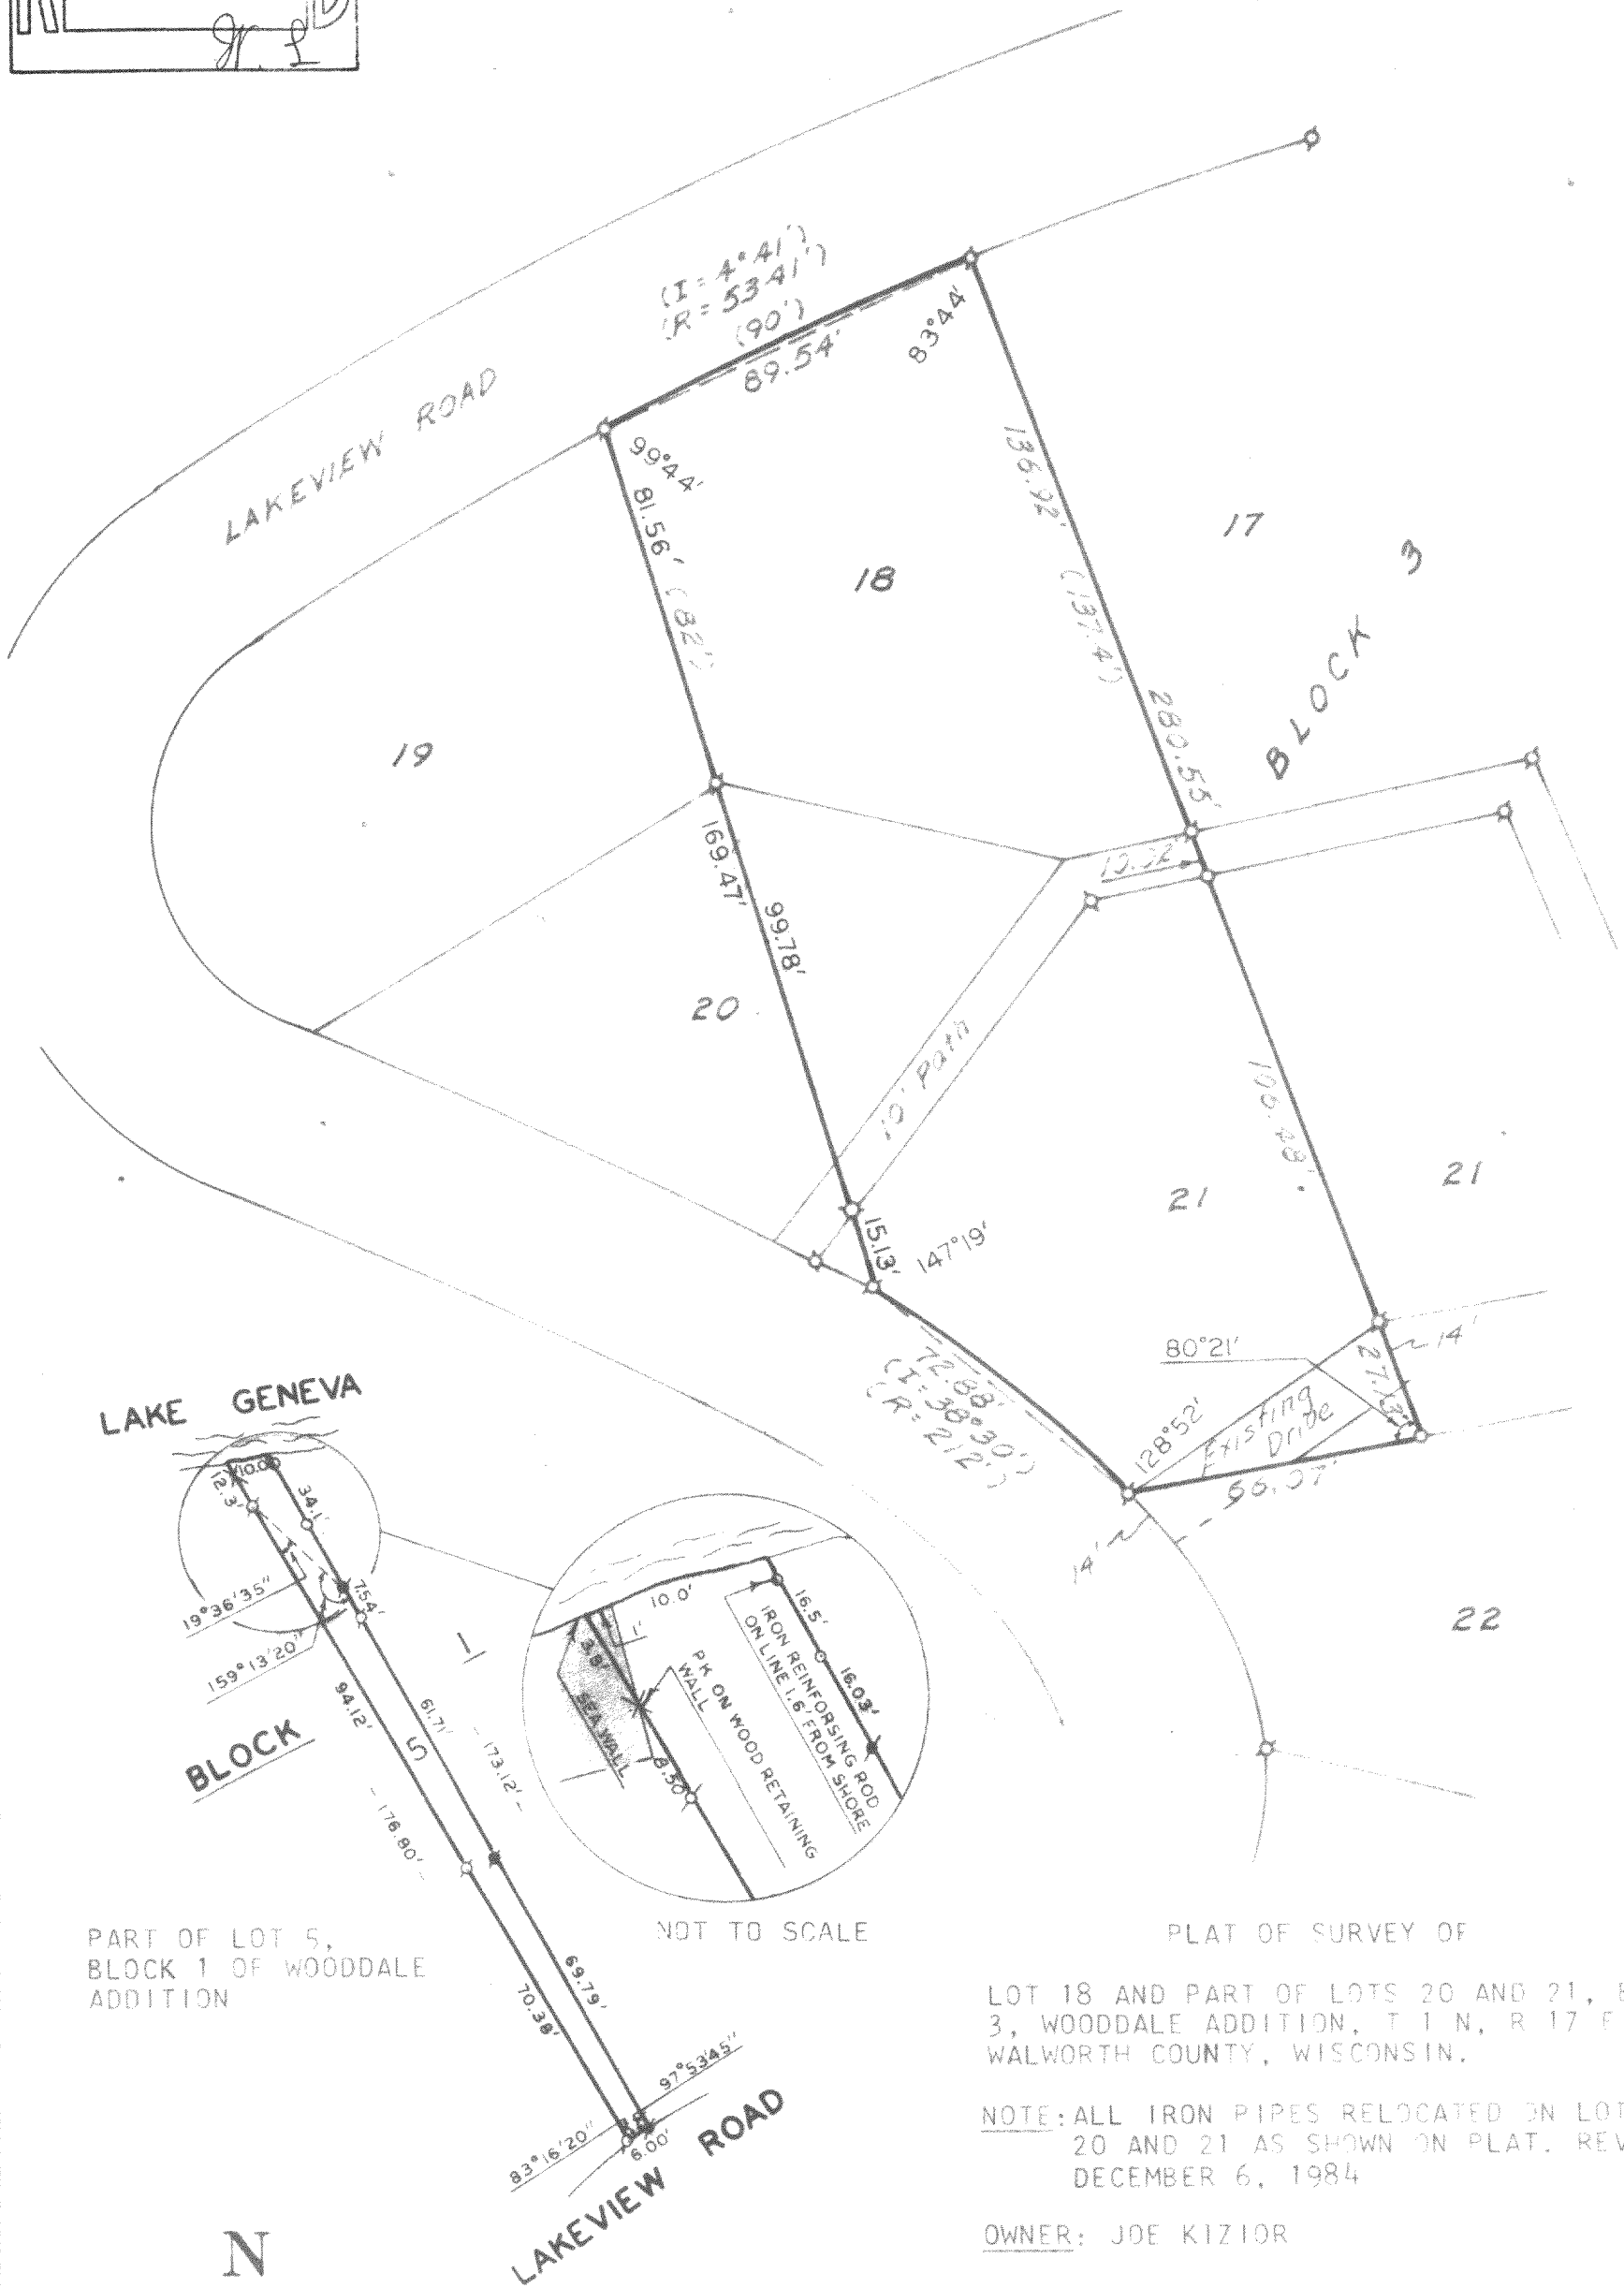

PART OF LOT 5,
BLOCK 1 OF WOODDALE
ADDITION

NOT TO SCALE

PLAT OF SURVEY OF

LOT 18 AND PART OF LOTS 20 AND 21, BLOCK
3, WOODDALE ADDITION, T 1 N, R 17 E,
WALWORTH COUNTY, WISCONSIN.

NOTE: ALL IRON PIPES RELOCATED ON LOTS 18,
20 AND 21 AS SHOWN ON PLAT. REVISED
DECEMBER 6, 1984

OWNER: JOE KIZIOR



SCALE 1"=40'

LEGEND

- - IRON PIPE FOUND
- - IRON PIPE PLACED
- - CONCRETE MONUMENT FOUND
- x -
- () - As platted



I, HAROLD H. KOLB, DO HEREBY CERTIFY THAT I HAVE
SURVEYED THE PROPERTY HEREON DESCRIBED ACCORDING
TO THE OFFICIAL RECORDS, AND THAT THE PLAT HEREON
IS A CORRECT REPRESENTATION OF THE LOT LINES.

Harold H. Kolb
HAROLD H. KOLB
WISCONSIN REGISTERED LAND SURVEYOR, S-187
DATE May 11, 1968
REVISED: March 20, 1972
REVISED: DECEMBER 6, 1984
REVISED: APRIL 11, 1985

117-699-K

1-17-129