



Plat of Survey

Survey For: First Financial Savings
Location: Fire No. 610 Lakeview Road

John F. Tucker

Description: LOT 5 in LAKE GENEVA HIGHLANDS, a subdivision of part of the North 1/2 of the Southeast 1/4 of Section 8, Township 1 North, Range 17 East, of the 4th Principal Meridian, according to the plat of said subdivision of record, in the office of the Register of Deeds for Walworth County, Wisconsin, in Volume 7, of Plats, at page 106.

Inman Survey and Associates, Inc.
11221 W. Forest Home Ave.
HALES CORNERS, WIS. 53130
(414) 425-2060

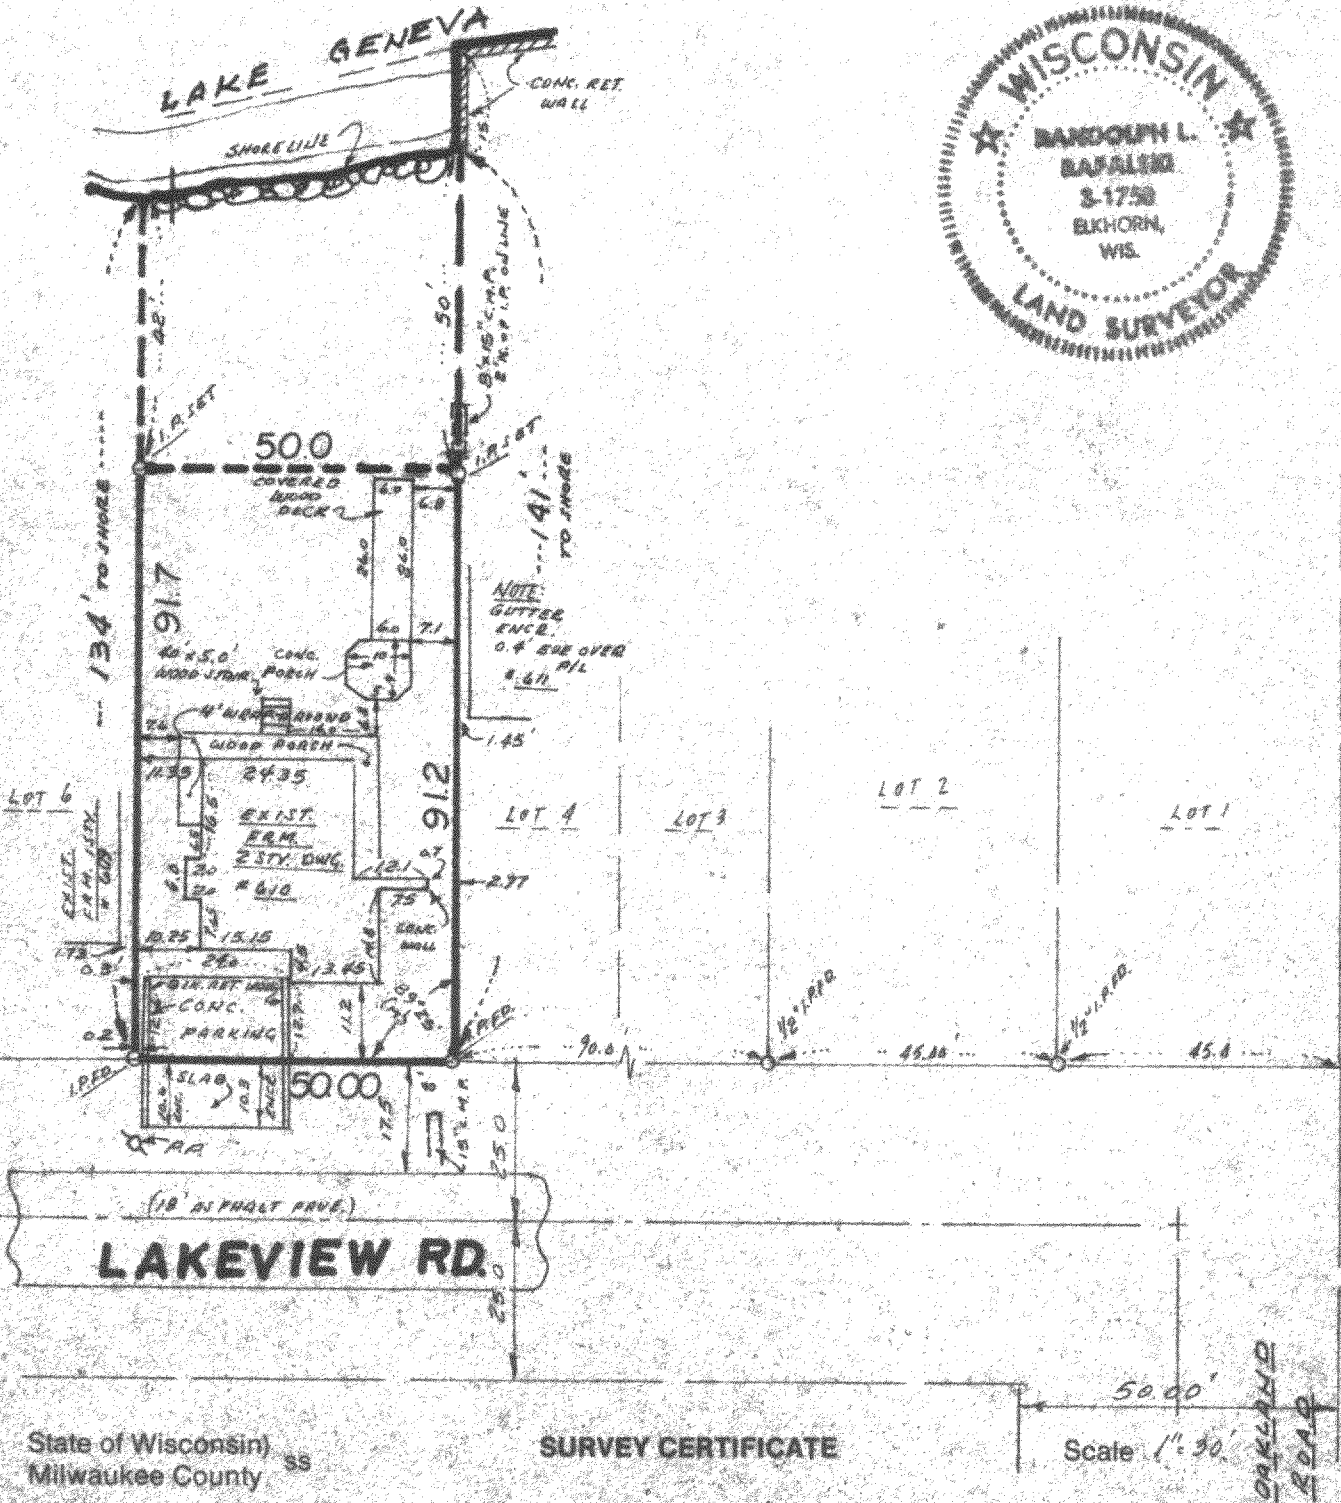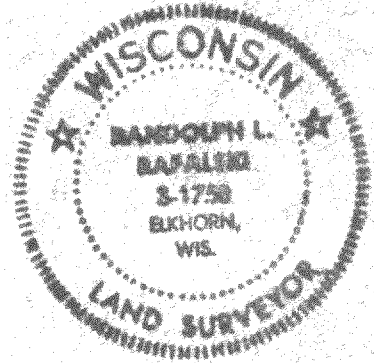

State of Wisconsin) ss
Milwaukee County

SURVEY CERTIFICATE

Scale 1" = 30'

We, Inman Survey and Associates, Inc., certify that we have surveyed the above described property and the above map is a true representation thereof, and shows the size and location of the property, its exterior boundaries, the location and dimensions of all visible structures thereon, fences, apparent easements and roadways and visible encroachments, if any.

This survey is made for the exclusive use of the present owners of the Property, and also those who purchase, mortgage, or guarantee the title thereto, within one (1) year from date hereof.

Randolph L. Rafalick
Wisconsin Registered Land Surveyor

Date: 10-5-85
Job No: 12348

117-700-R