

PLAT OF SURVEY


- of -

Lot 2, Block 5 of Genevista, a subdivision
located in the S.W. 1/4 of the S.W. 1/4 of Section 10,
T1N, R17E, Walworth County, Wisconsin.

Surveyed For: Phil Scheffler


3N 002 Timberline Dr.

W. Chicago 60185

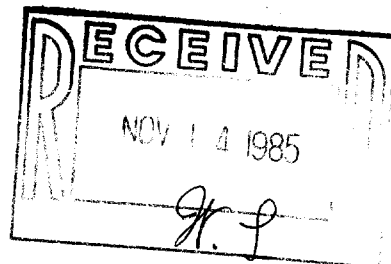

Linwood Ave.

50' WIDE

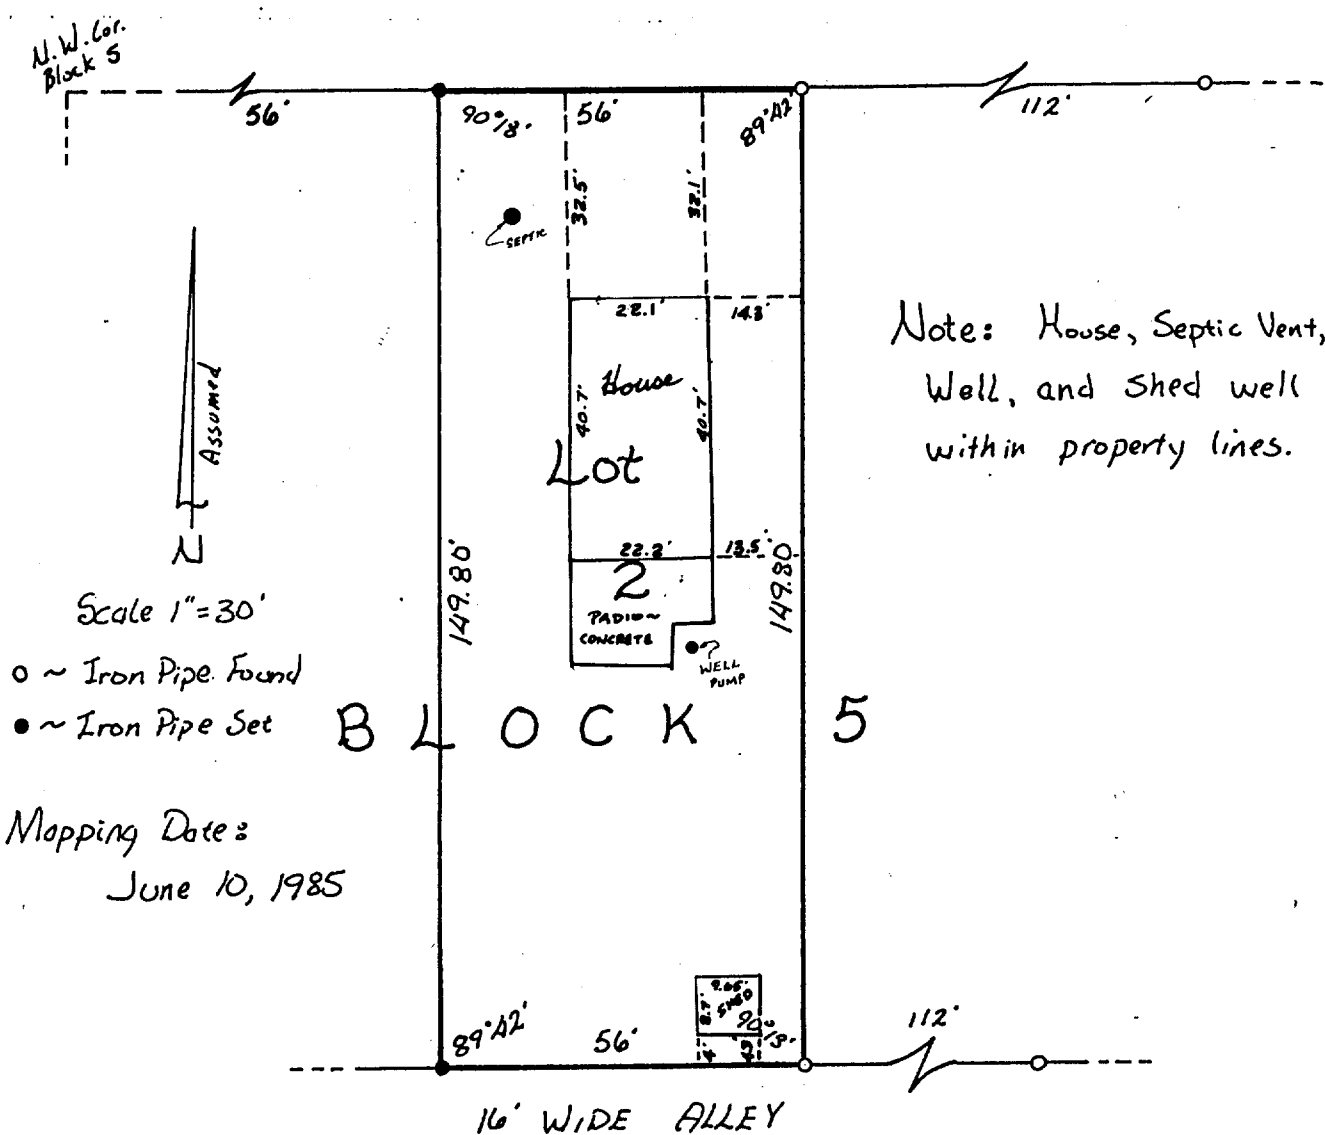

Note: House, Septic Vent,
Well, and Shed well
within property lines.

Scale 1"=30'

○ ~ Iron Pipe Found

● ~ Iron Pipe Set


B L O C K 5

Mapping Date:

June 10, 1985

I, Thomas P.A. Jensen, Wis. Registered Land Surveyor,
do hereby certify that this survey was performed by me,
or under my direction, in full compliance with the owner's/
agent's instructions and chapter A-E 5 of the Wis. Admin.
Code "Minimum Standards For Property Surveys"; and that this
map is an accurate representation thereof to the best of my
knowledge and belief.

Thomas P.A. Jensen S-1084
Jensen Surveying & Mapping, S.C.
45 S. Wisconsin St.
Elkhorn, Wis. 53121
414-723-3434

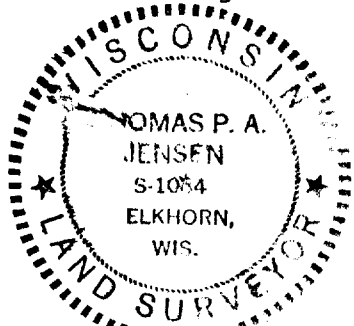

LIEN WAIVER REQUIRED FROM JENSEN SURVEYING & MAPPING S.C.
1985.041

117-701-J