



RECEIVED
AUG 5 1985
G. I.

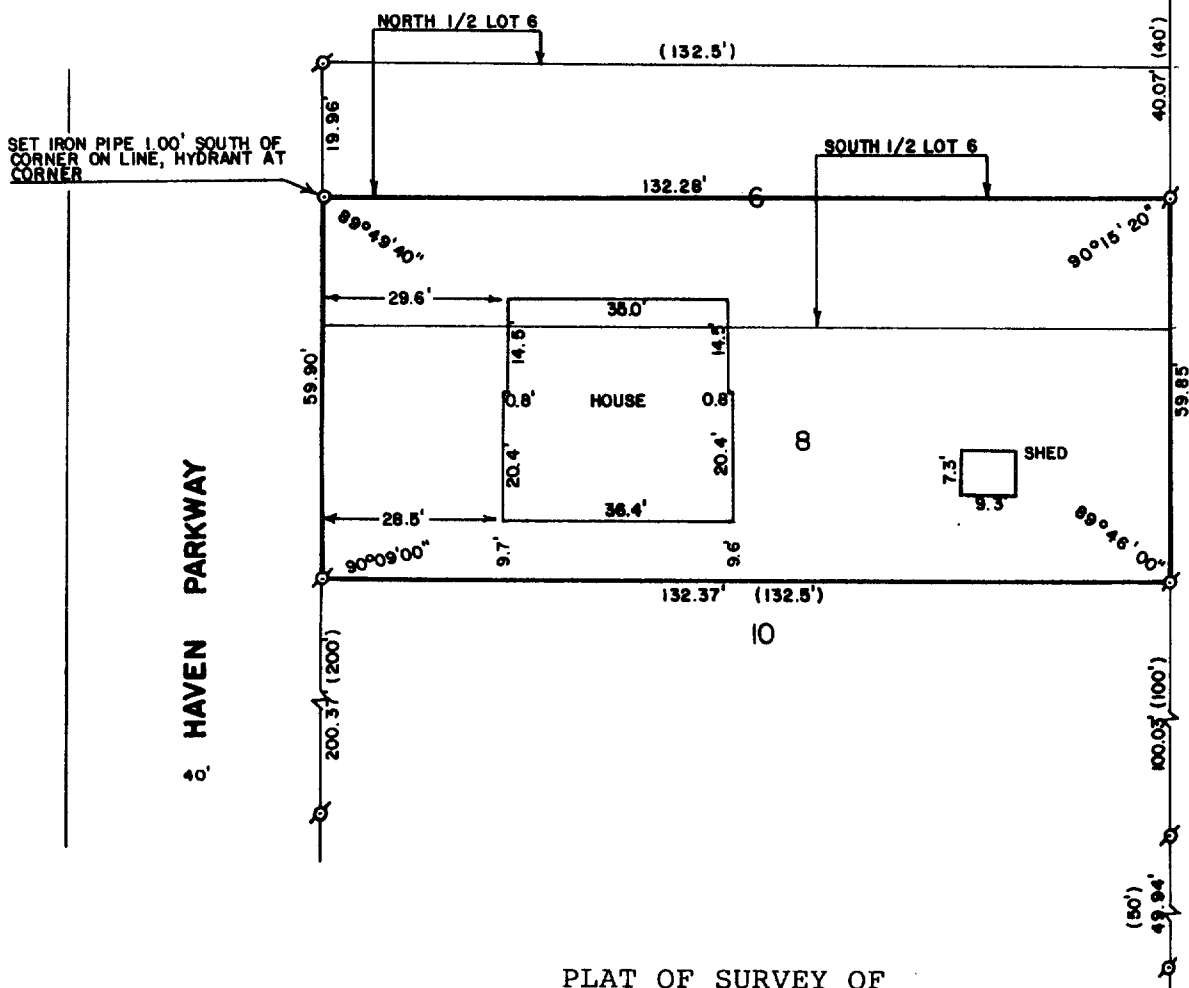

LOT 8 AND THE SOUTH 1/2 OF LOT 6, SHORE
HAVEN, A SUBDIVISION LOCATED IN TOWN 1
NORTH, RANGE 17 EAST, WALWORTH COUNTY,
WISCONSIN.

ORDERED BY: KEEFE REAL ESTATE
704 MAIN STREET
LAKE GENEVA, WI 53147

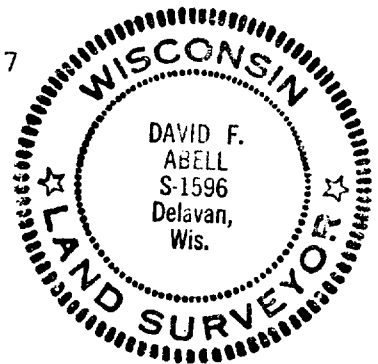

LEGEND

♂ - IRON PIPE FOUND
○ - IRON PIPE SET
() - RECORDED AS

David F. Abell

DATE May 10, 1985

JOB NUMBER 0261

ISA-7 + ISA-5

1-17-702